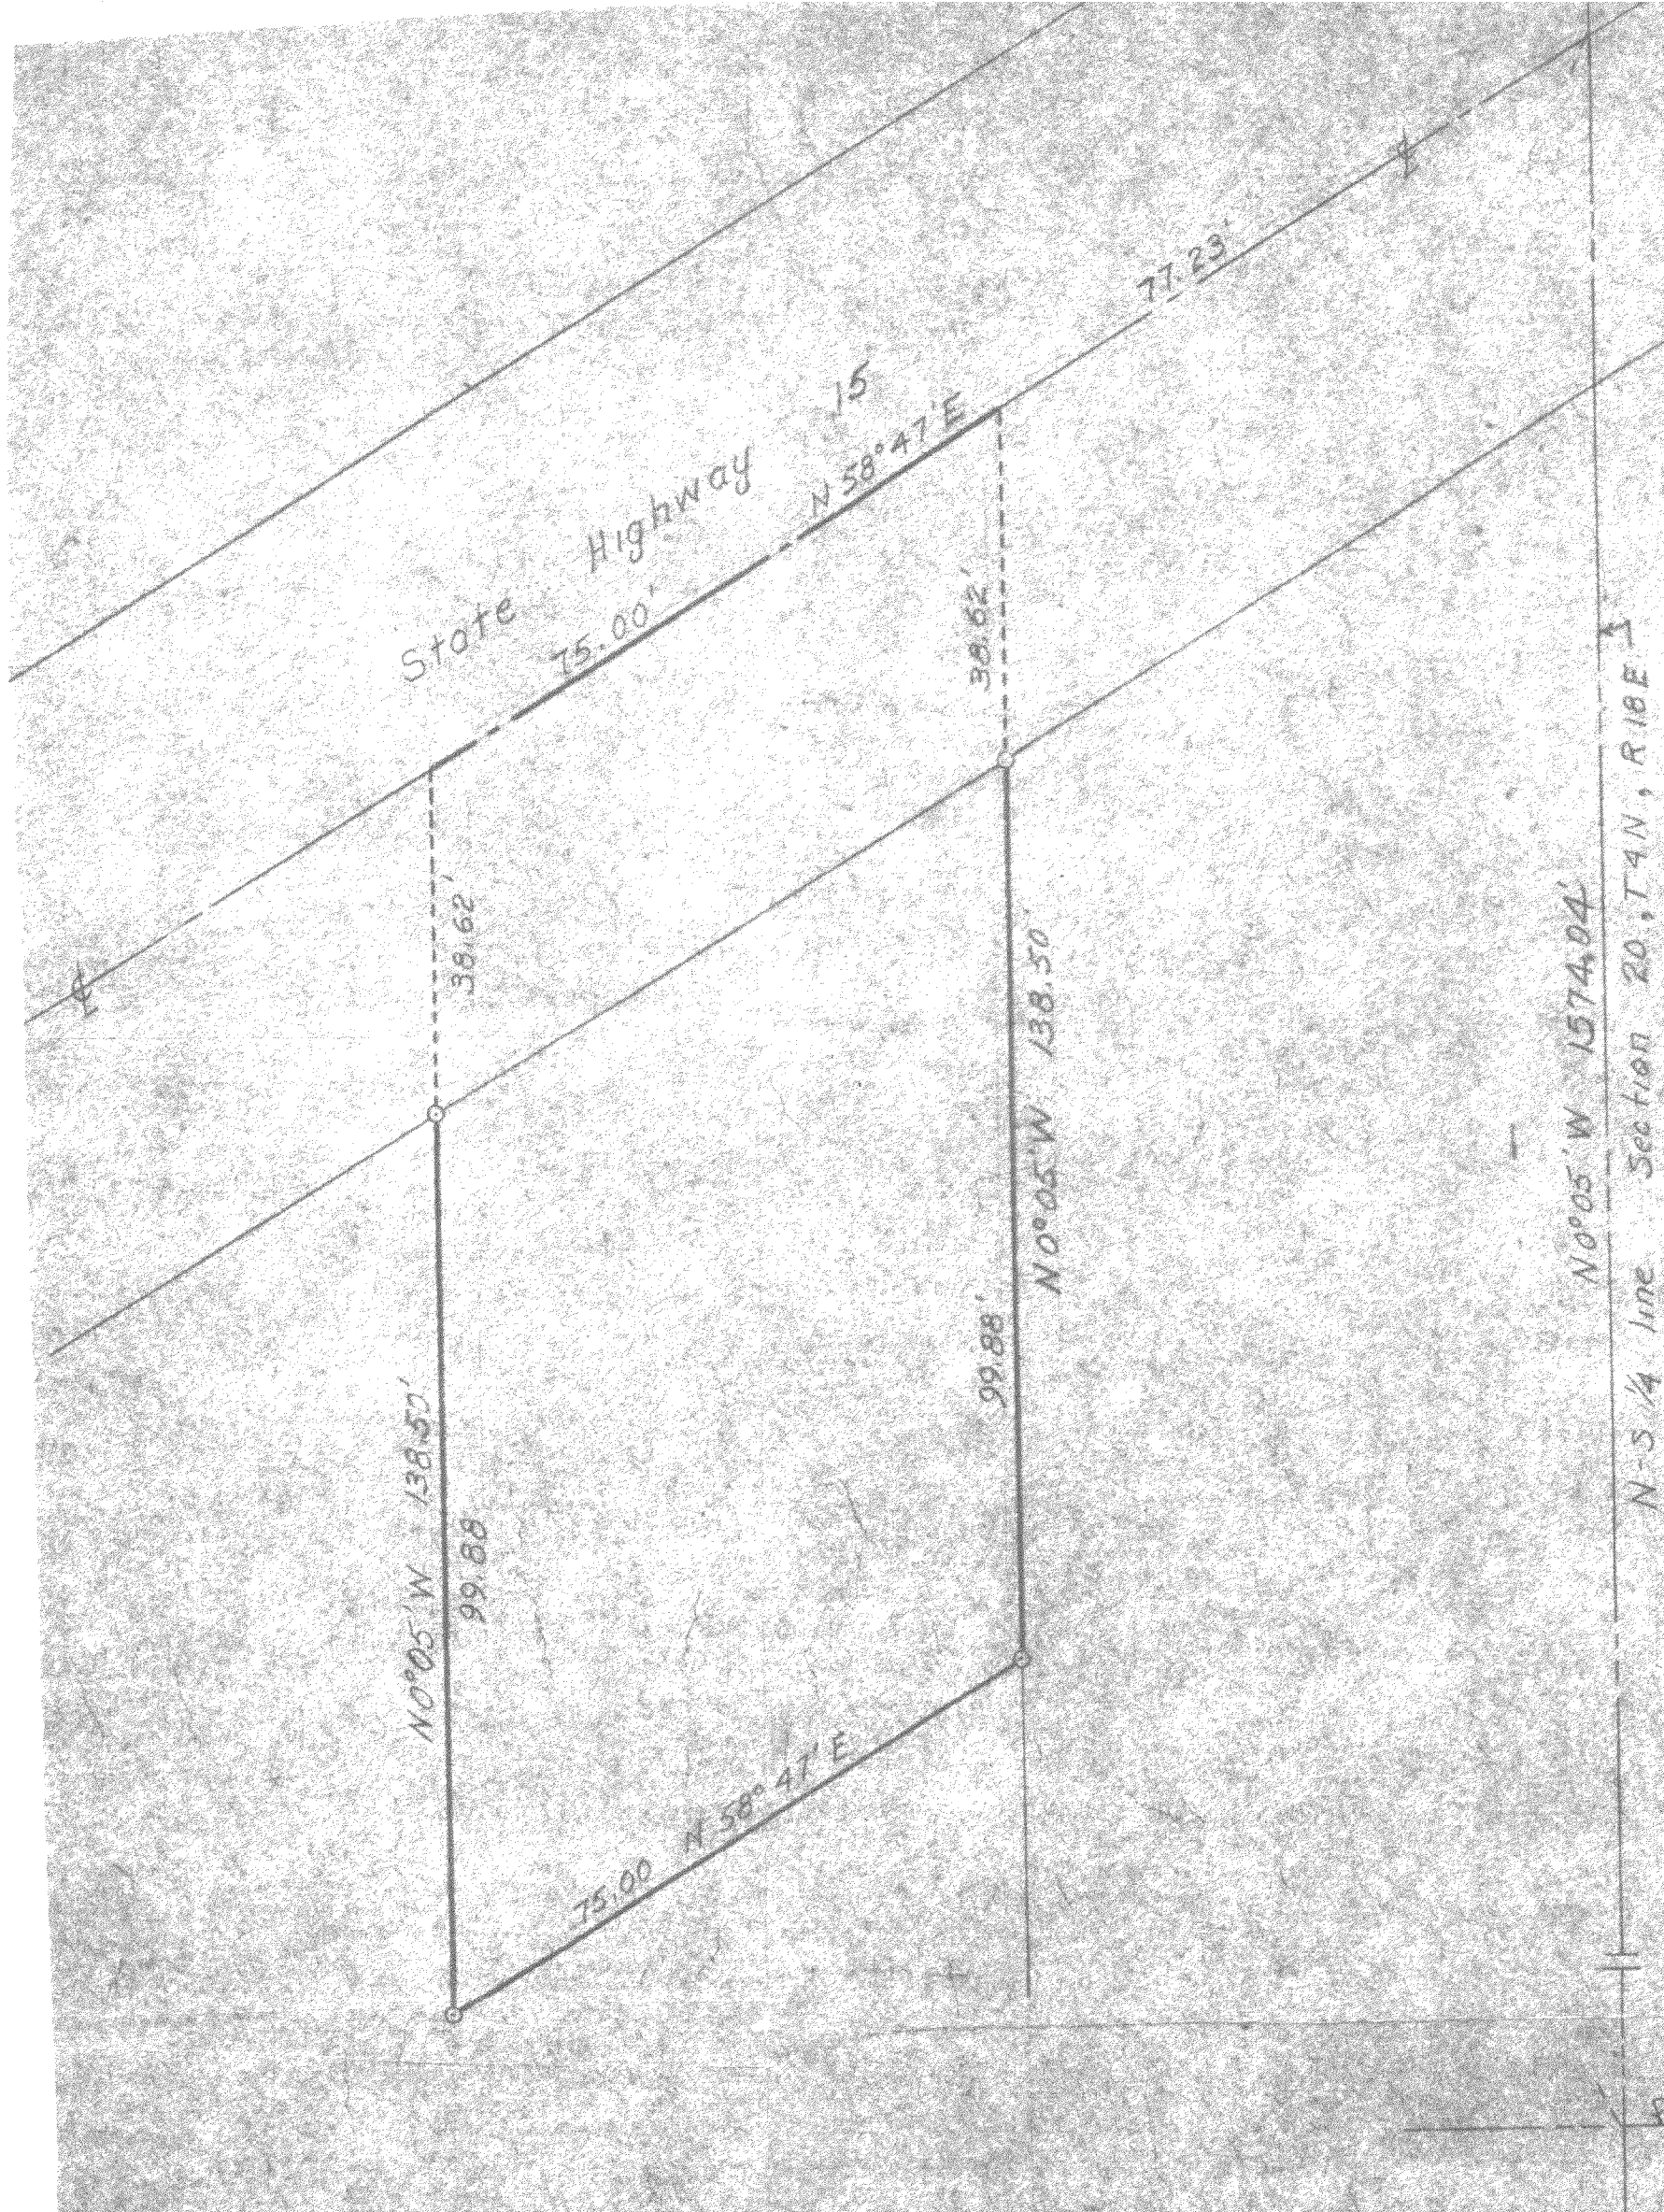


o - Iron Pipe

PLAT OF SURVEY OF

Parcel of Land located in the SW 1/4
of Section 20, T4N, R18E, Village
of East Troy, Walworth County,
Wisconsin

Lloyd J. Jensen
SURVEYOR

SCALE 1" = 20'

DATE April, 1957

3-21-57