
SURVEYING ASSOCIATES, INC.

MEMBER ACSM WSLS

2554 N. 100th STREET
WAUWATOSA, WISCONSIN 53226

FREDERICK W. SHIBILSKI RLS
(414) 257-2212

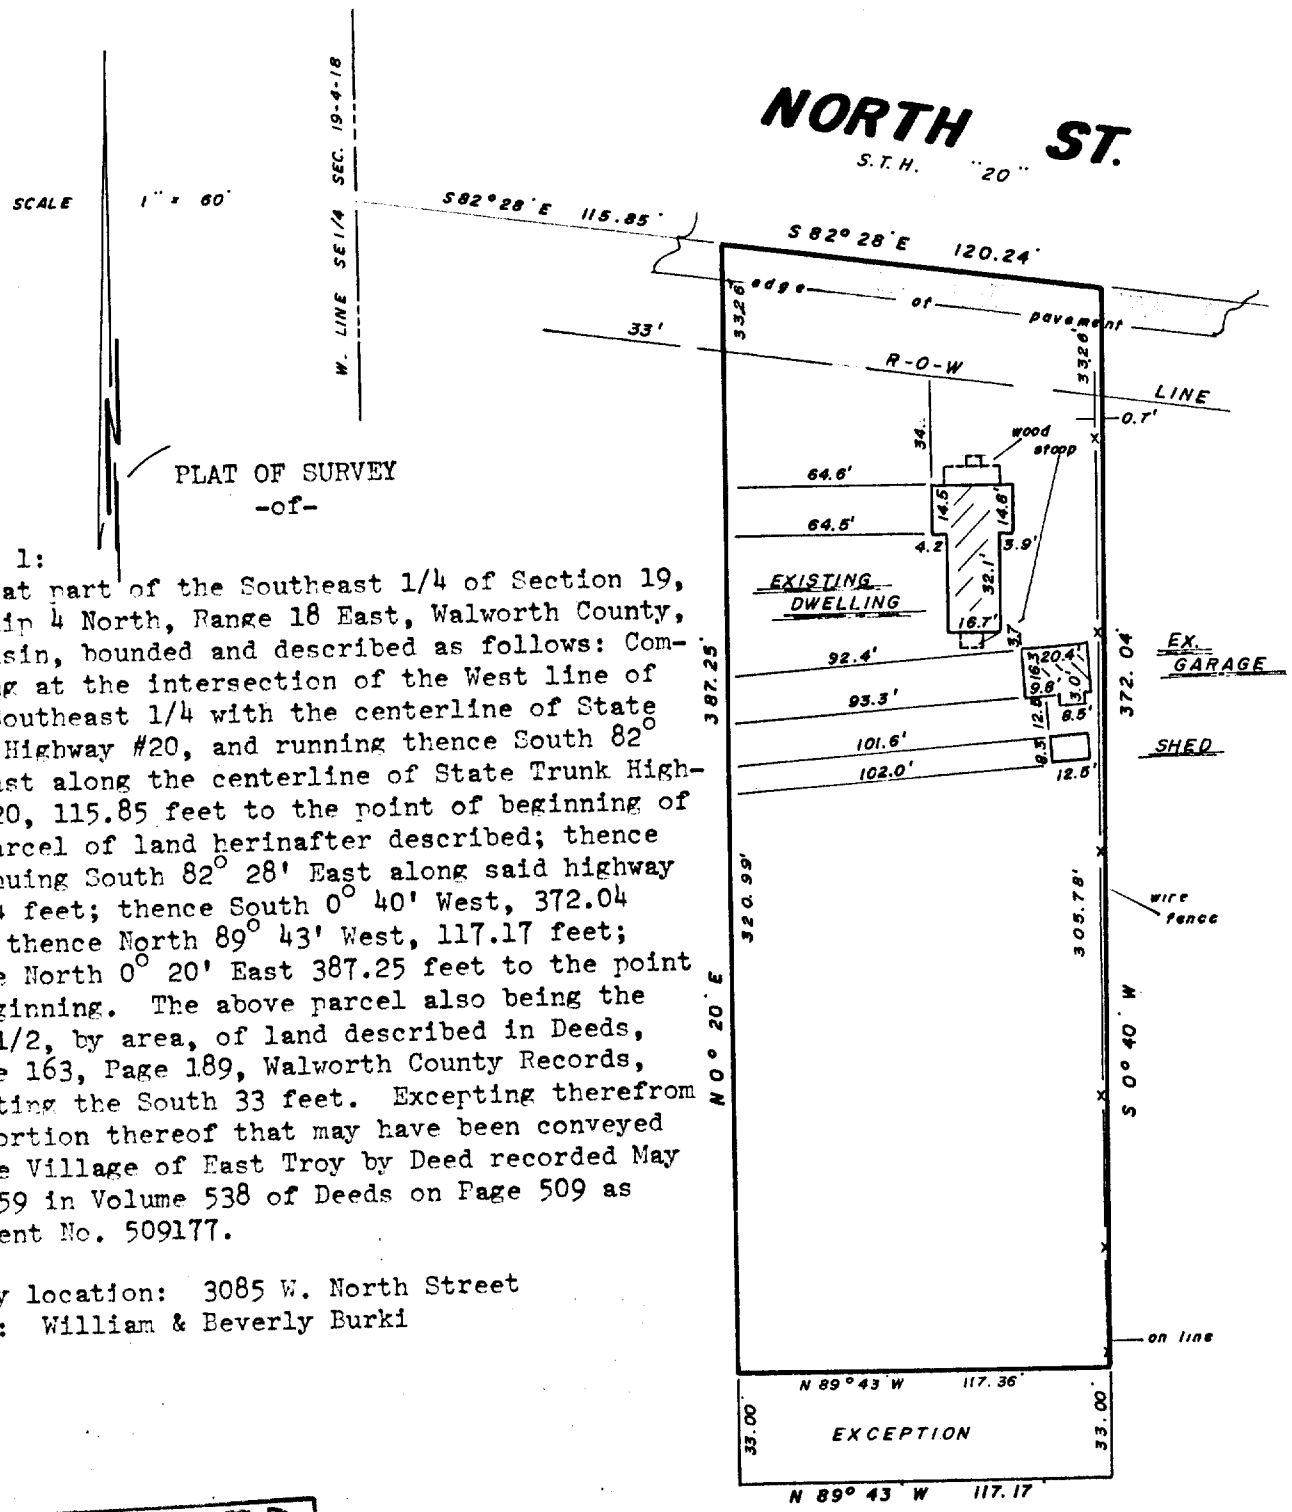

PLAT OF SURVEY
-of-

Parcel 1:
All that part of the Southeast 1/4 of Section 19, Township 4 North, Range 18 East, Walworth County, Wisconsin, bounded and described as follows: Commencing at the intersection of the West line of said Southeast 1/4 with the centerline of State Trunk Highway #20, and running thence South 82° 28' East along the centerline of State Trunk Highway #20, 115.85 feet to the point of beginning of the parcel of land herinafter described; thence continuing South 82° 28' East along said highway 120.24 feet; thence South 0° 40' West, 372.04 feet; thence North 89° 43' West, 117.17 feet; thence North 0° 20' East 387.25 feet to the point of beginning. The above parcel also being the East 1/2, by area, of land described in Deeds, Volume 163, Page 189, Walworth County Records, excepting the South 33 feet. Excepting therefrom any portion thereof that may have been conveyed to the Village of East Troy by Deed recorded May 8, 1959 in Volume 538 of Deeds on Page 509 as Document No. 509177.

Survey location: 3085 W. North Street
Buyer: William & Beverly Burki

RECEIVED
JUL 30 1986

Surveyed for: *ALLSTATE ENTERPRISES MORTGAGE CORP.*

"I hereby certify that I have surveyed the above described property and that the above map is a true representation thereof and shows the size and location of the property, its exterior boundaries, the location of all visible structures and dimensions of all principal buildings thereon, boundary fences, apparent easements, roadways and encroachments, if any.

"This survey is made for the use of the present owners of the property, and also those who purchase, mortgage, or guarantee the title thereto within one year from date hereof."

MONUMENTATION BY WRITTEN AGREEMENT WITH THE ABOVE NAMED CLIENT (HAS [redacted]) BEEN WAIVED IN ACCORDANCE WITH A-E 5.01 (1) (b) OF THE WISCONSIN ADMINISTRATIVE CODE

WISCONSIN
FREDERICK W. SHIBILSKI
S-1154
MILWAUKEE, WIS.
LAND SURVEYOR

"THIS IS NOT AN ORIGINAL SURVEY UNLESS THIS SEAL IS RED."

WISCONSIN REGISTERED LAND SURVEYOR	DATE	FIELD WORK BY	DRAWN BY	JOB NUMBER
	FEB. 13, 1986	prs , tap	mdn , dlf	10448

3-275