PLAT OF SURVEY OF


LOT 68 OF LYNNDALE SUBDIVISION ADDITION NO. TWO
IN THE VILLAGE OF EAST TROY, WALWORTH COUNTY, WISCONSIN
FOR MICHELE ANDERSON

□ = 1"x2"x15" WOOD STAKE SET
(xxxx) = original plat dimen.
O = iron rebar stake found
Bearings are relative to the East line of Fremont St. which was assigned the bearing N0°04'30"E as shown on orig. sub.

FARRIS, HANSEN & ASSOCIATES, INC.
Engineers Architects Surveyors
7 Ridgeway Court P.O. Box 437
ELKHORN, WISCONSIN 53121
Office: (414) 723-2098

NOTE: COPIES OF THIS MAP TO WHICH THE FOLLOWING CERTIFICATE SHALL APPLY ARE BLUE LINE PRINTS WITH THE SURVEYORS ORIGINAL SEAL AND SIGNATURE APPEARING IN BLACK INK. COPIES BY ANY OTHER MEANS MAY CONTAIN ALTERATIONS WHICH DO NOT REPRESENT THE SURVEYOR'S WORK PRODUCT.

DRAWING NUMBER 3108

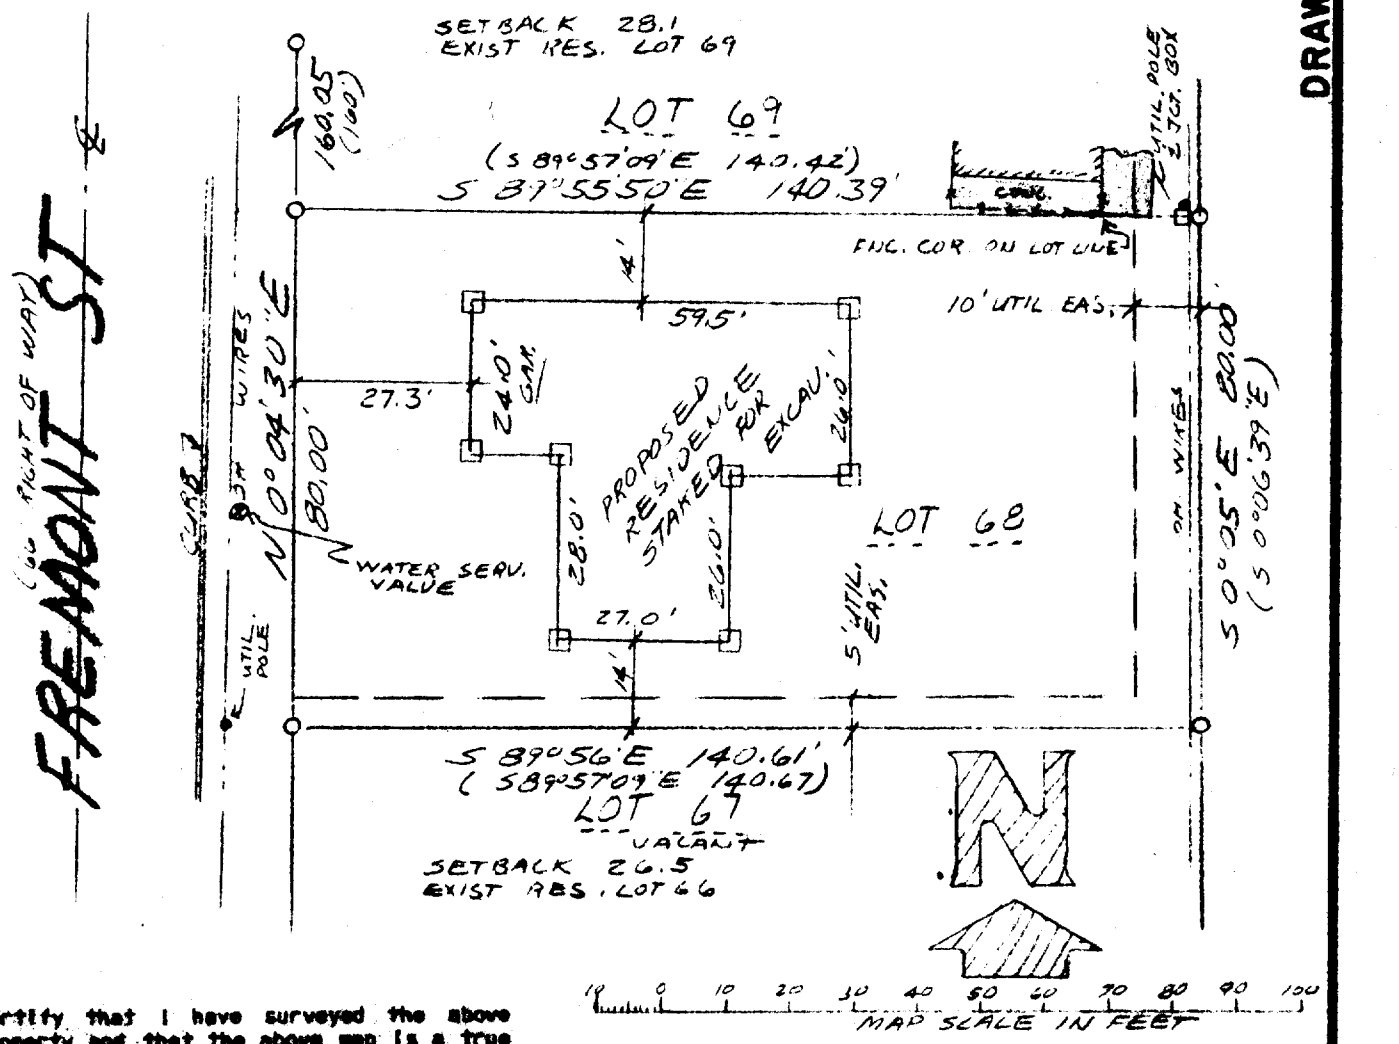

I hereby certify that I have surveyed the above described property and that the above map is a true representation thereof and shows the size and location of the property, its exterior boundaries, the location of all visible structures and dimensions of all principal buildings thereon, boundary fences, apparent easements, roadways and visible encroachments, if any.
This survey is made for the use of the present owners of the property, and also those who purchase, mortgage, or guarantee the title thereto within one (1) year from the date hereof.

DATED THIS 28TH DAY OF SEP, 1988

WISCONSIN
ROBERT A. FARRIS
S-1293
ELKHORN, WIS.
LAND SURVEYOR

RECEIVED
OCT 6 1988

PROJ. 3108

3-300