
46-70

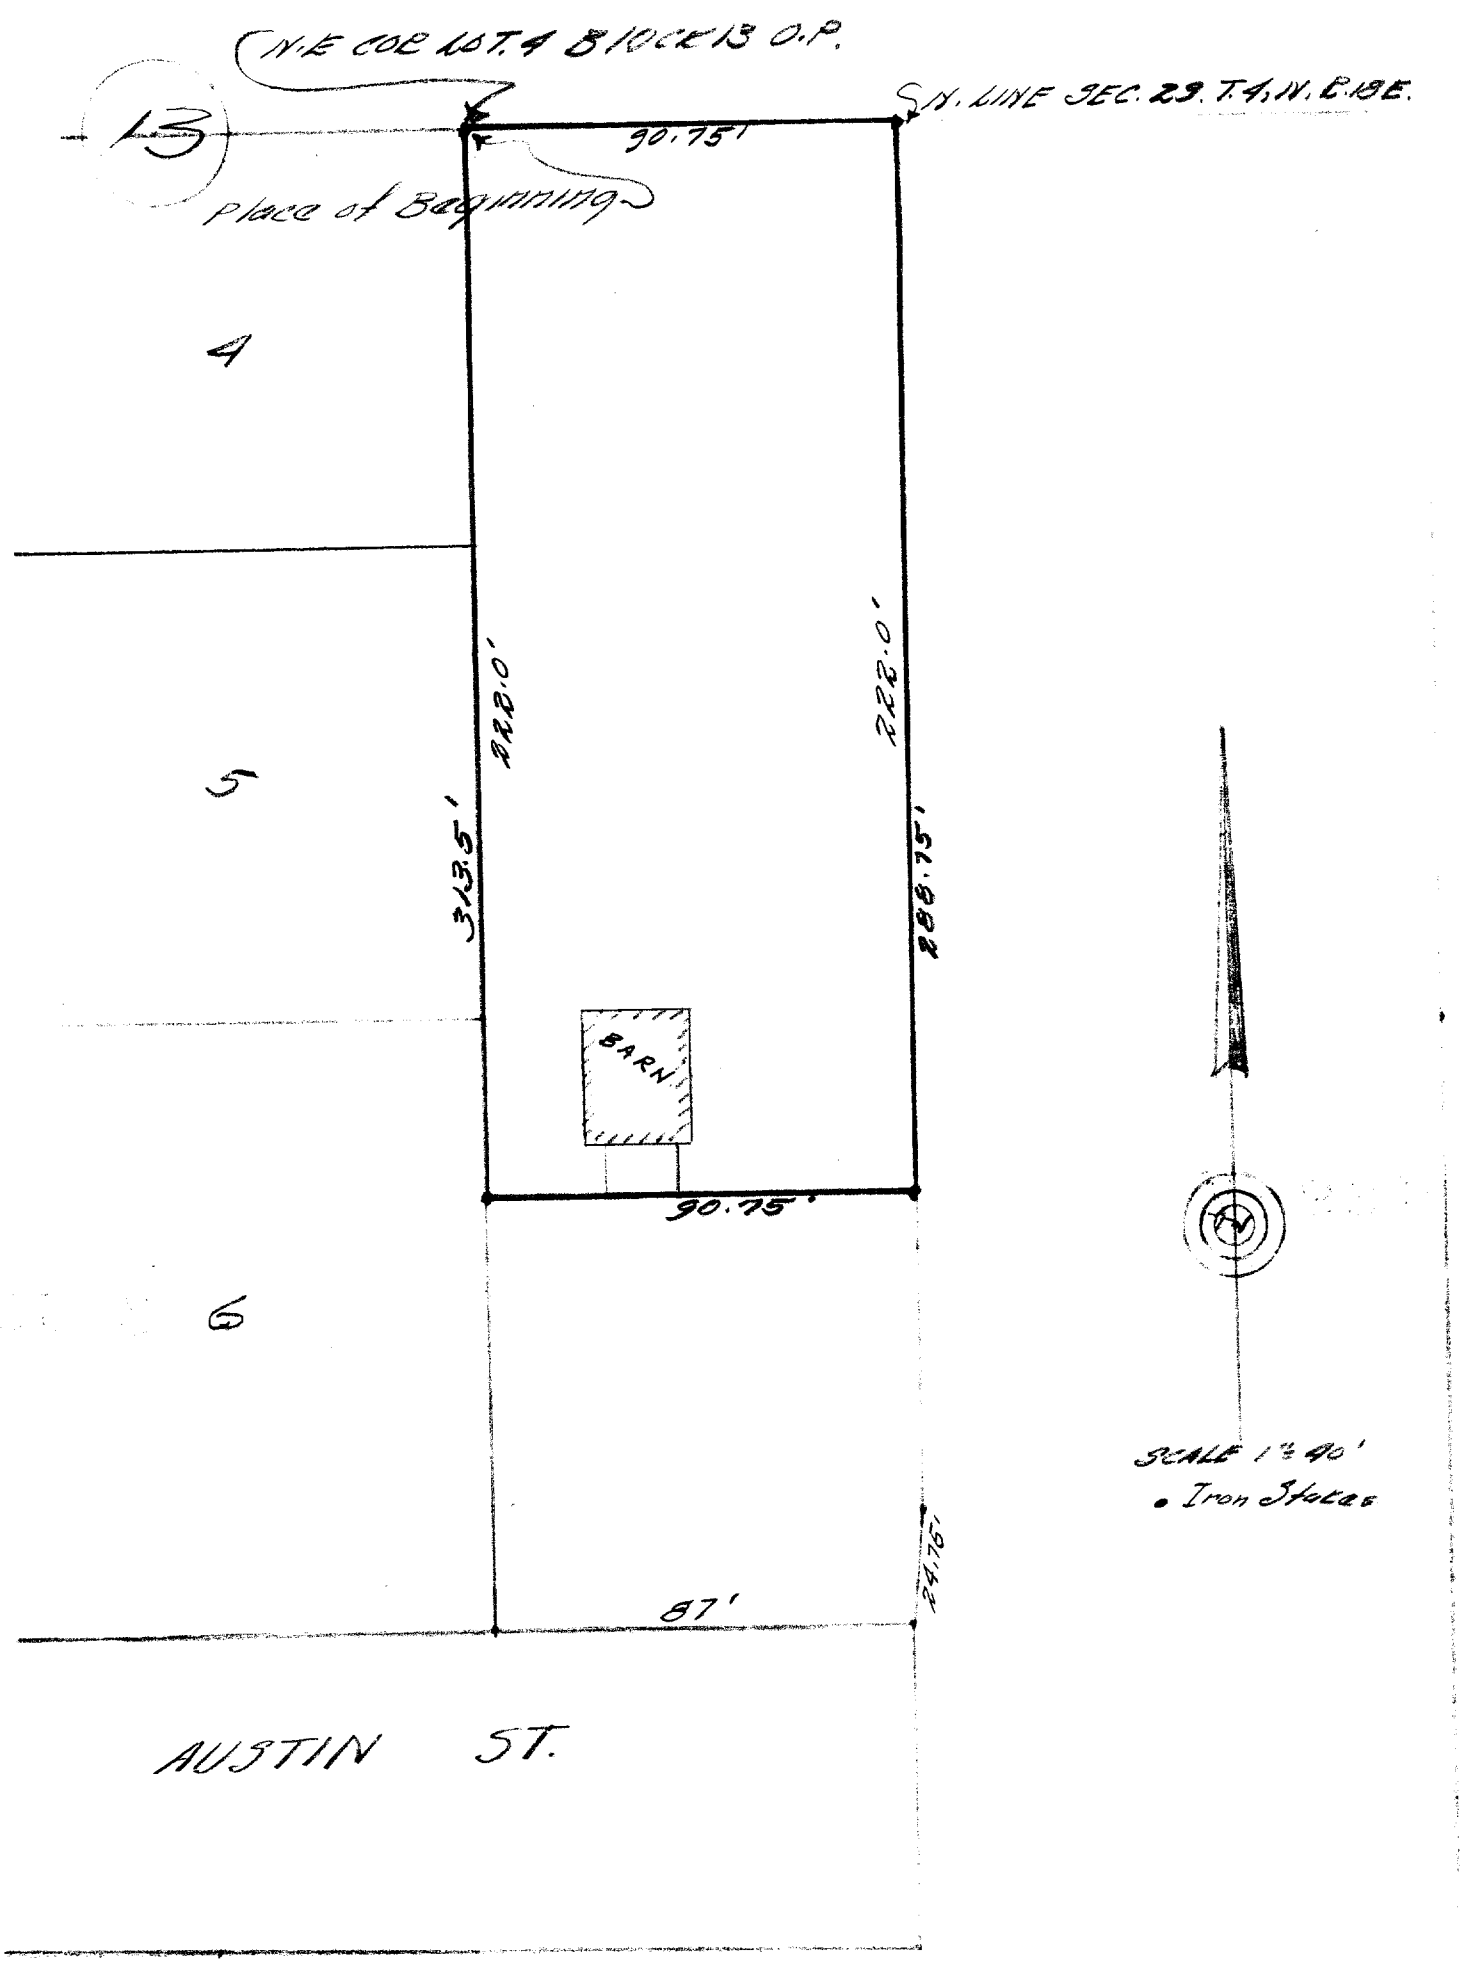

DESCRIPTION: Commencing at an iron stake located where the north line of Section 29, Town 4 north, Range 18 east of the 4th P.M. intersects the east line of Block 13 plat of the Original Town Village of East Troy Walworth County, Wisconsin, thence East 90.75 feet to an iron stake, thence South 222 feet to an iron stake, thence West 90.75 feet to an iron stake, thence North 222 feet to the place of beginning. Containing 46/100 acres more or le ss.

Certificate; I, hereby certify that I have on this the 13th day of July 1946, surveyed the above described property according to the official records on file in the office of the Recorder of Deeds in and for Walworth County Wisconsin, and find that the measurements and bearings of the boundary lines of said property as taken on this day substantially agree with those in the above description and that no encroachments exist.
SIGNED AND SEALED THIS 15TH DAY OF JULY 1946.

Joseph M. Biagi. Professional Engineer
Elkhorn Wisconsin.

UP-163

3-33B