
PLAT OF SURVEY

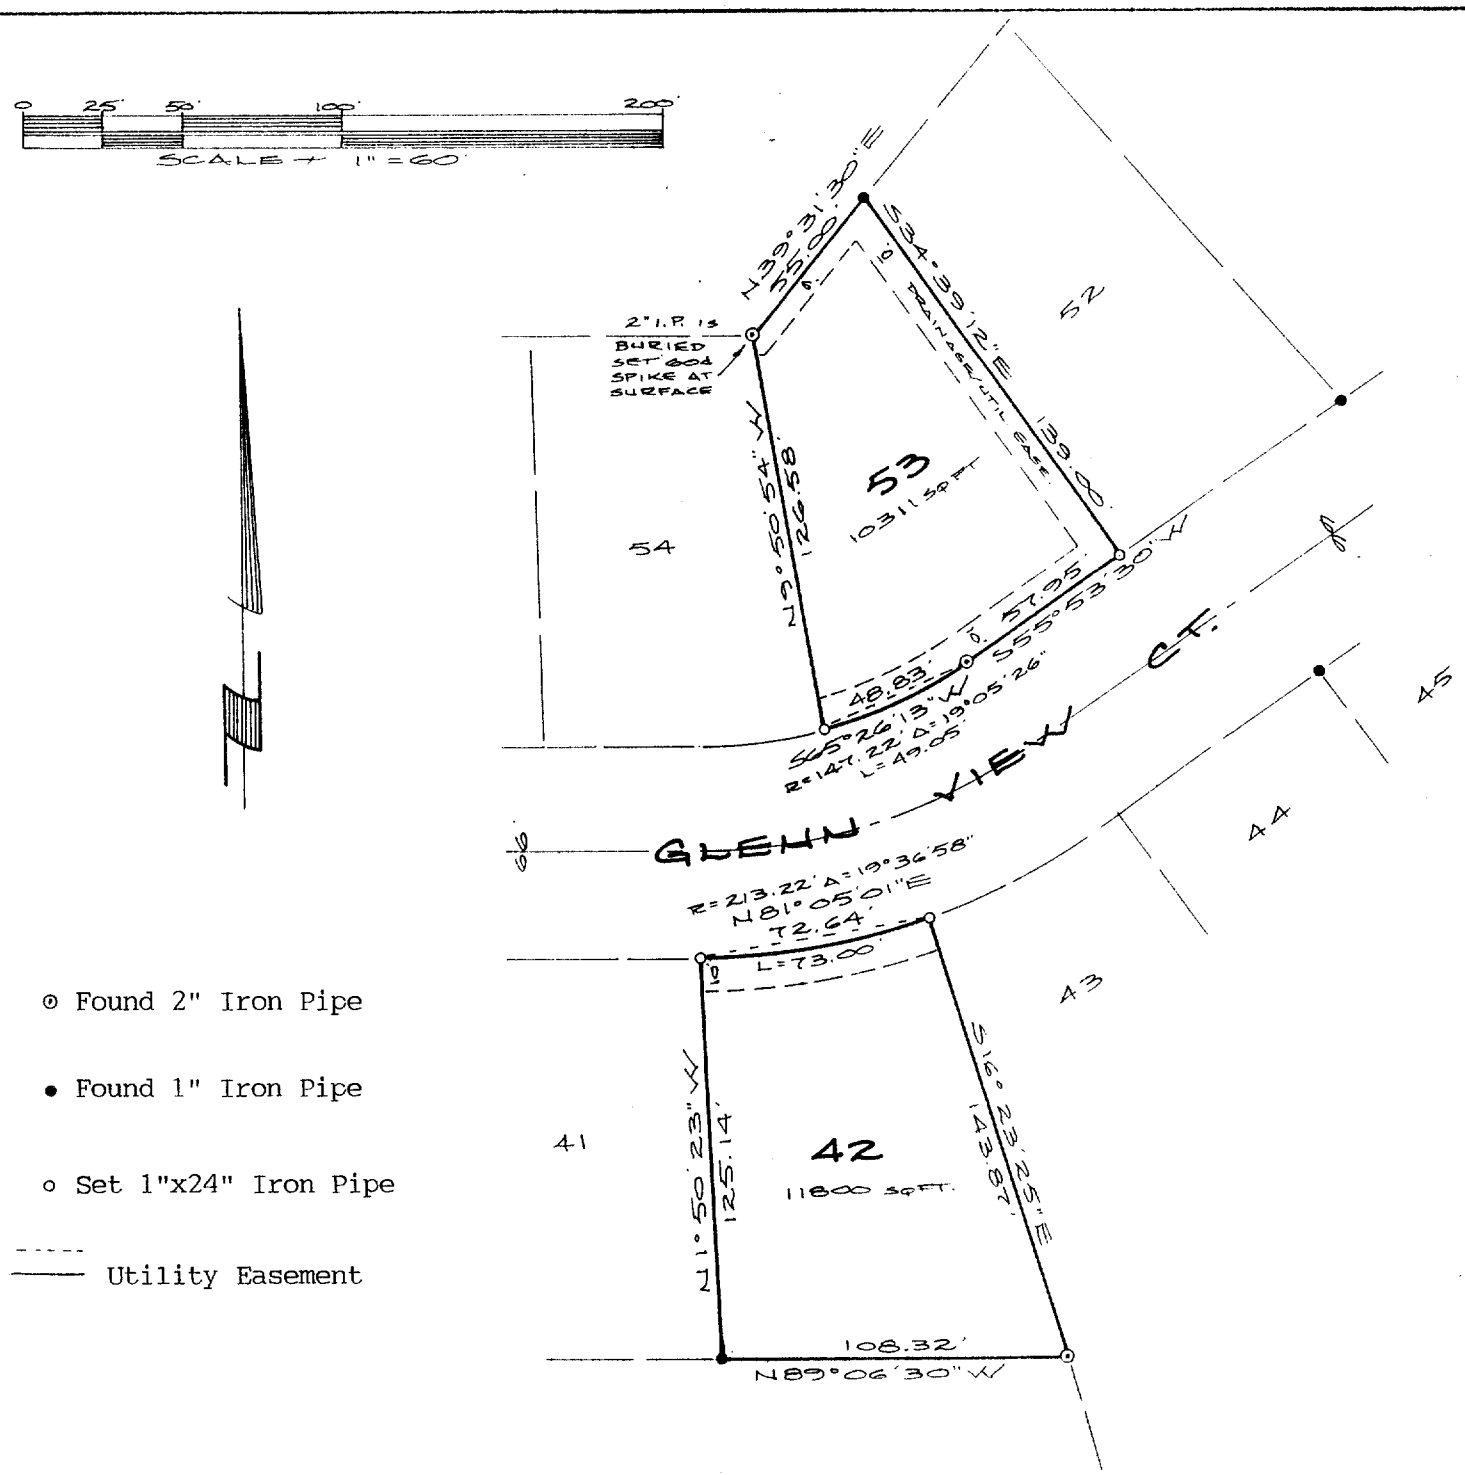

⊙ Found 2" Iron Pipe

• Found 1" Iron Pipe

o Set 1"x24" Iron Pipe

----- Utility Easement

DESCRIPTION

Lots 42 and 53, THIRD ADDITION TO GLENN VIEW ESTATES in the NW¼ of Section 20, T4N, R18E, Village of East Troy, Walworth County, Wisconsin.

CERTIFICATION

I hereby certify that the property described above has been surveyed under my responsible direction and supervision and that this map is an accurate representation of the lot lines and dimensions.

RECEIVED
MAR 4 1993

Date 2-18-93

James B. Woodman
Registered Land Surveyor S-1239

WISCONSIN
JAMES B. WOODMAN
S-1239
FORT ATKINSON, WIS.
LAND SURVEYOR

Prepared for: Mike Gustavson
NEUMANN HOMES INC.
4450 Milton Avenue #206
Janesville, WI 53546

WOODMAN, ANDERSON & ASSOCIATES **Registered Land Surveyors**
210 Madison Avenue, Fort Atkinson, WI 53538 Phone (414) 563-8162
003-378

RGV3-42
RGV3-53