W. 238 S. 3712 BIG BEND ROAD
WAUKESHA, WIS. 53186


TELEPHONE
542-5616

RONALD H. ZIMMERMAN
REGISTERED LAND SURVEYOR

PLAT OF SURVEY

FOR

WAUKESHA SAVINGS & LOAN

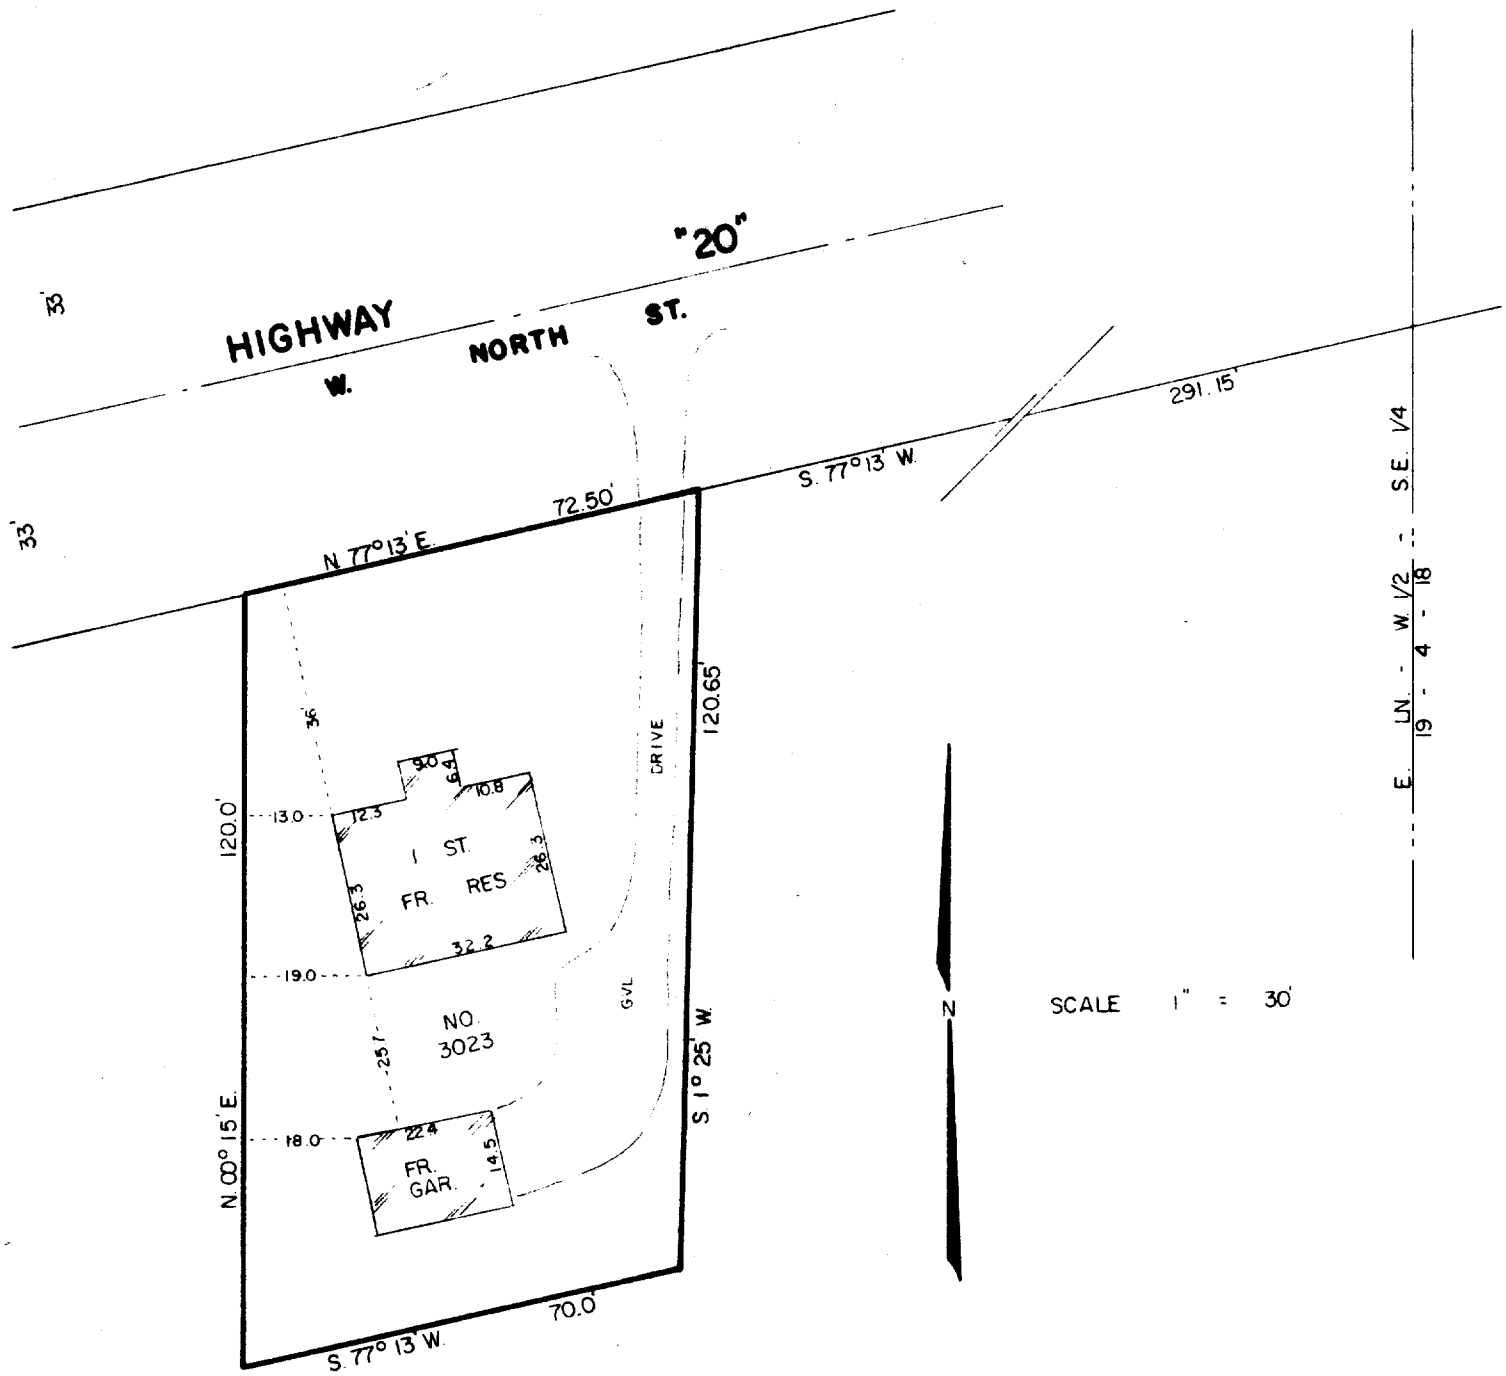

DESCRIPTION of Premises

A tract of land located in the West ½ of the [illegible] Town of North, Range 19 East of the Waukesha, Wisconsin, [illegible] follows, to-wit: Commencing at the intersection of the [illegible] distant 72.

CERTIFICATION

STATE OF WISCONSIN)
COUNTY OF WAUKESHA) SS

I, RONALD H. ZIMMERMAN, REGISTERED LAND SURVEYOR, DO HEREBY CERTIFY THAT I HAVE MADE A SURVEY OF THE PROPERTY DESCRIBED ABOVE AND THE EXISTING BUILDING AND IMPROVEMENTS LOCATED THEREON AND THAT THE PLAT HEREWITH DRAWN IS A CORRECT REPRESENTATION OF SAID SURVEY.

DATE NOV. 30, 1973

RONALD H. ZIMMERMAN S - 868

VP-31

[redacted]

3-3Z