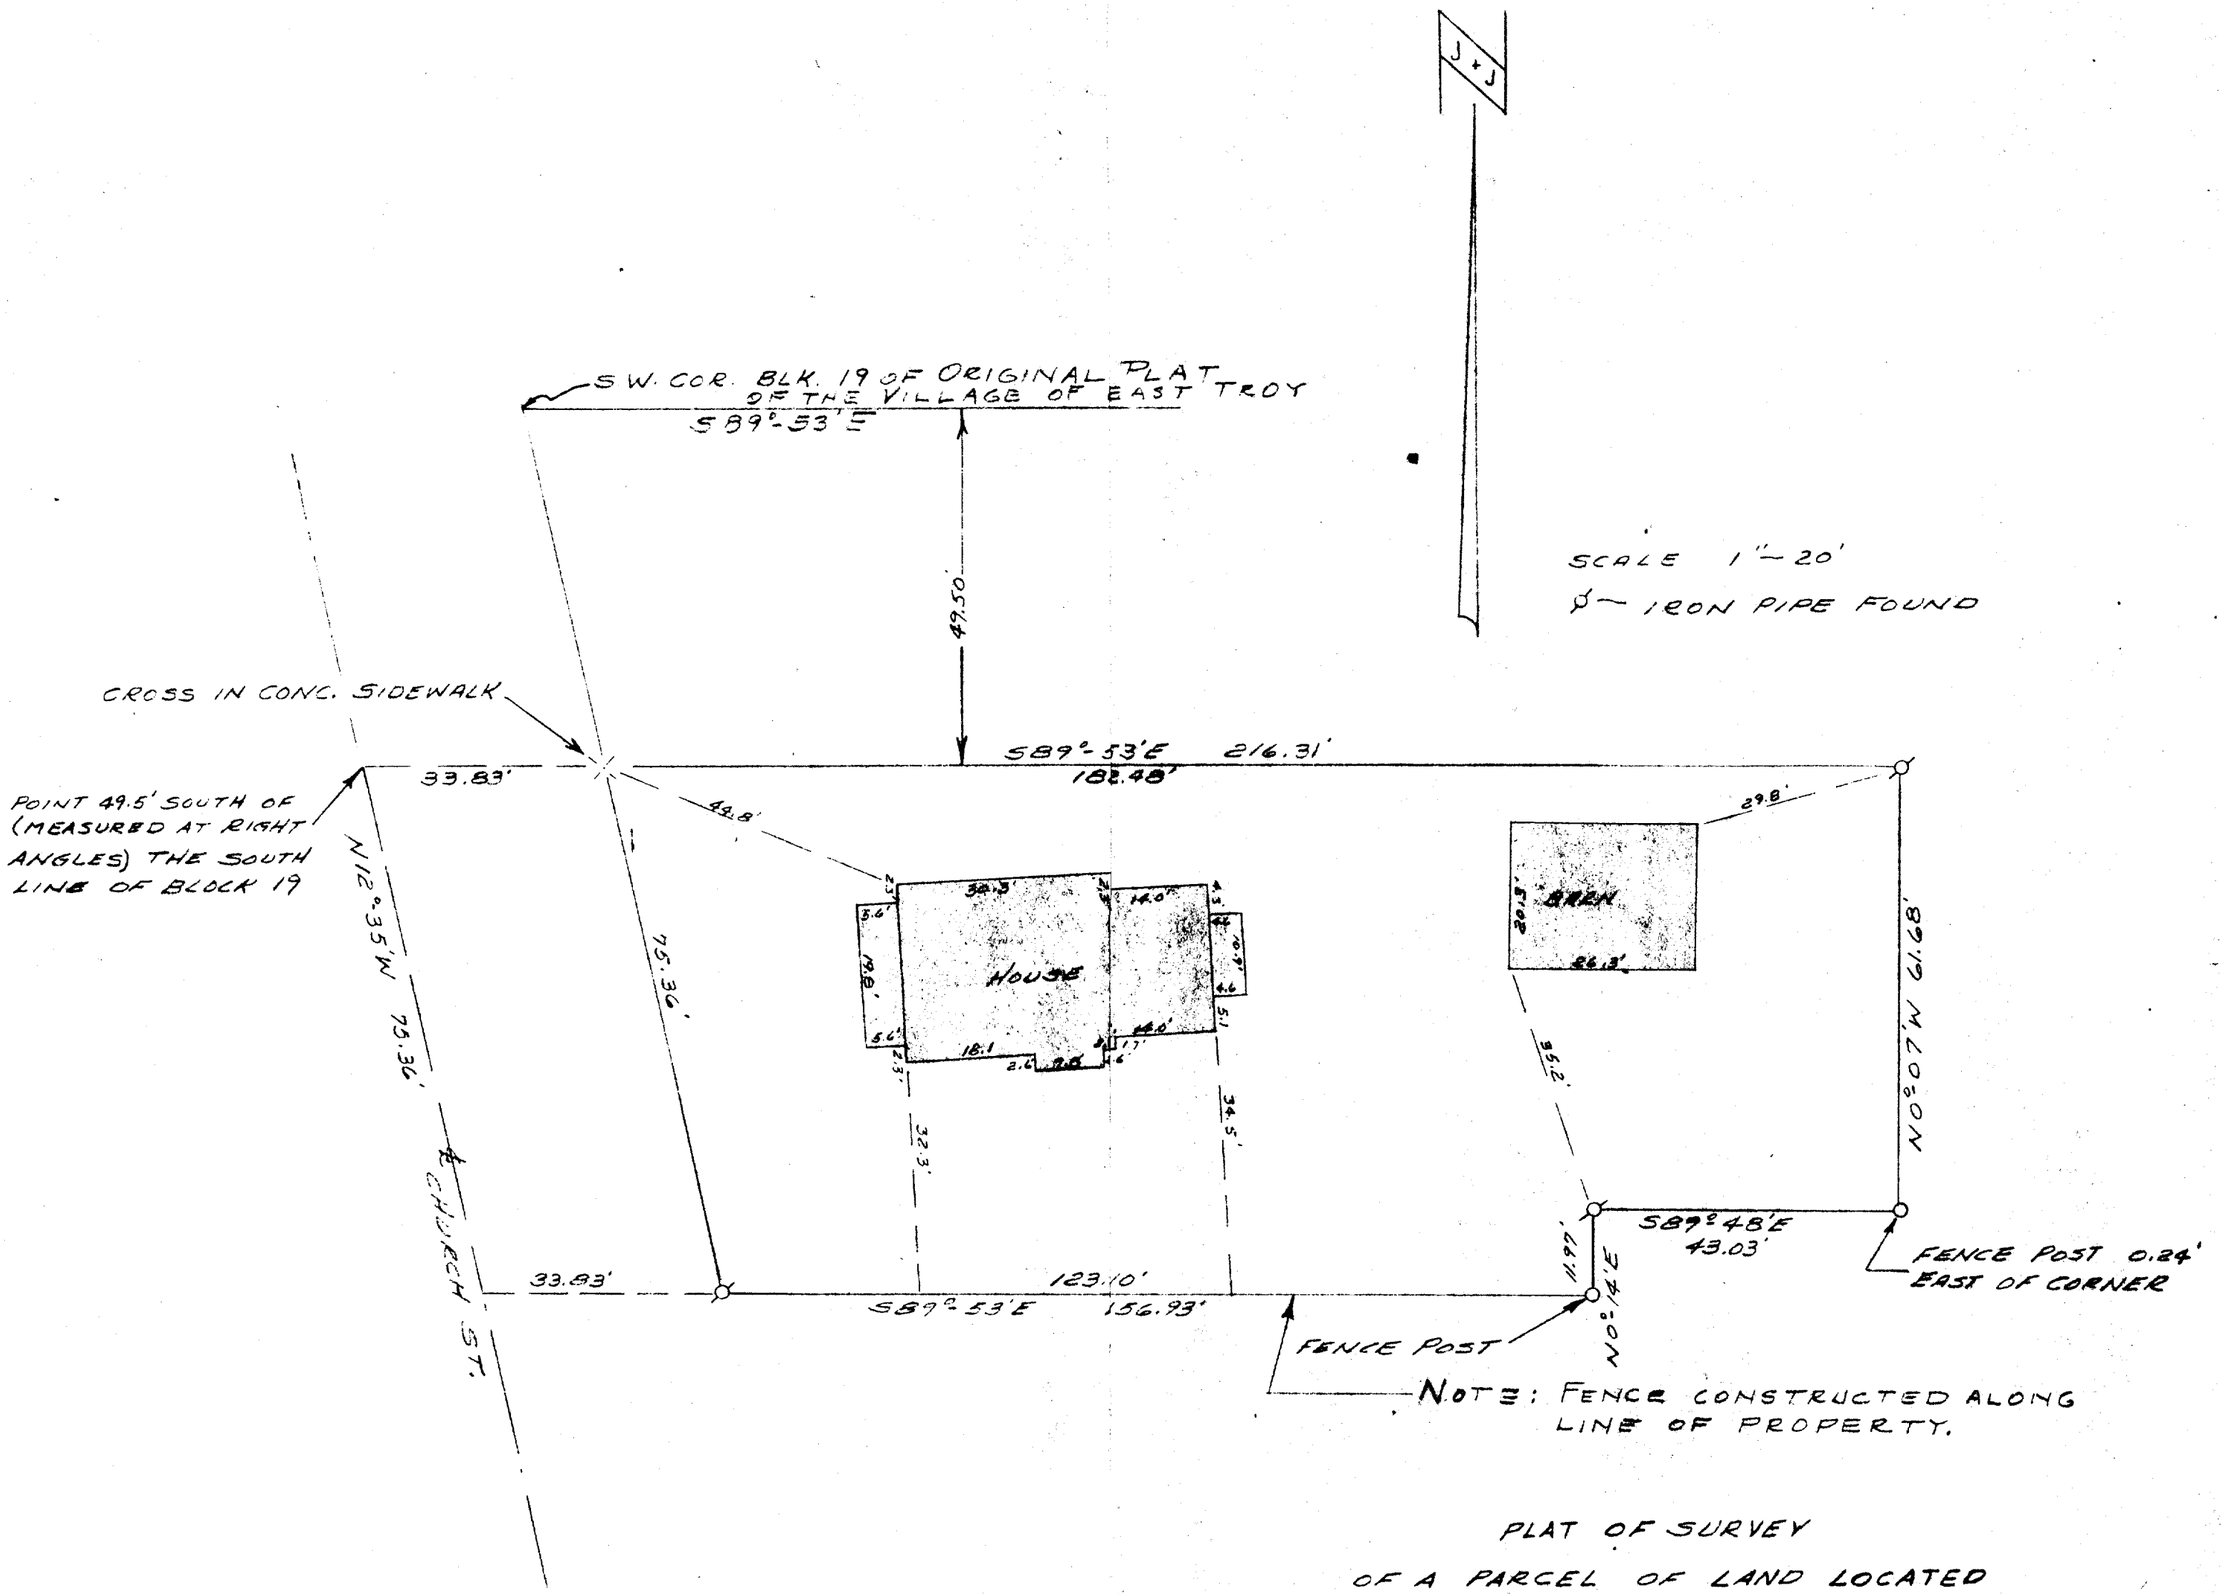


NOTE: FENCE CONSTRUCTED ALONG LINE OF PROPERTY.

PLAT OF SURVEY
OF A PARCEL OF LAND LOCATED
IN THE NW¼ OF SECTION 29,
T4N R18E WAL. CO. WIS.

OCT. 8, 1968

Lloyd L. Jensen
Lloyd L. JENSEN
Co. SURVEYOR

3-91J

UP-167