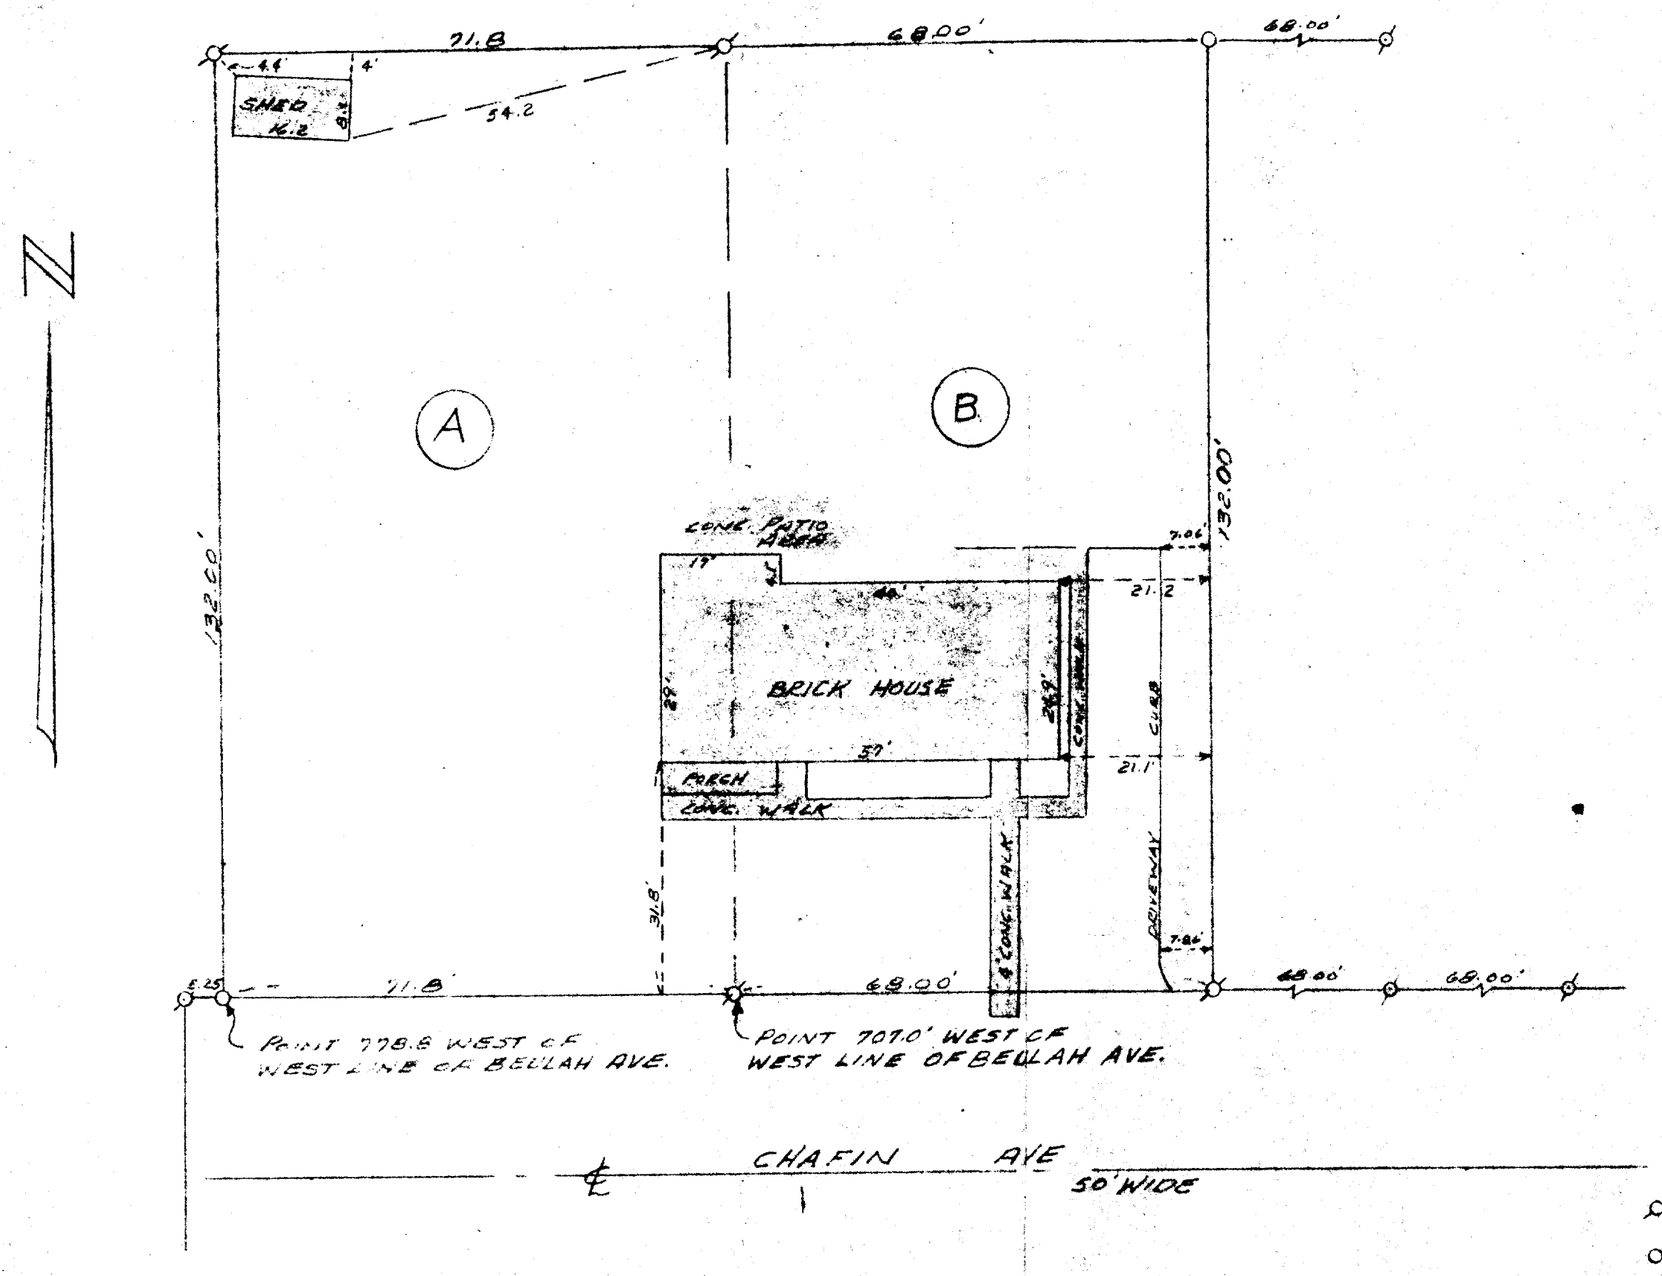

WISCONSIN
LLOYD L. JENSEN
S-211
ELKHORN, WIS.
LAND SURVEYOR

⊗ — IRON PIPE FOUND
O — IRON PIPE SET

Parcel A: Commencing at an iron stake in the North line of Chafin Ave., in the Village of East Troy, Walworth County, Wis., that is 778.8 feet West of the West line of Beulah Avenue in said Village, thence North 132.00 feet to an iron stake, thence East 71.8 feet to an iron stake, thence South 132.00 feet to an iron stake in the North line of Chafin Ave., thence West in the North line of said Chafin Ave., 71.8 feet to the place of beginning.

Parcel B: Commencing at an iron stake in the North line of Chafin Ave., in the Village of East Troy, Walworth County, Wis., that is 707.0 feet West of the West line of Beulah Avenue in said Village, thence North 132.00 feet to an iron stake, thence East 68.0 feet to an iron stake, thence South 132.00 feet to an iron stake in the North line of Chafin Ave., thence West in the North line of said Chafin Ave., 68.00 feet to the place of beginning.

"We certify that we have surveyed the above-described property and that the above plat is an accurate survey and a true representation thereof and correctly shows the exterior boundary lines and location of buildings and other improvements, and roads, driveways, and other apparent easements on said property and the correct measurements thereof."

July 6, 1968

Lloyd L. Jensen
Lloyd L. Jensen S-211
County Surveyor

PLAT OF SURVEY
OF

A PARCEL LAND LOCATED IN THE VILLAGE OF EAST TROY, WAL. CO. WIS.

Lloyd L. Jensen
SURVEYOR

UP-35

3-44 J

SCALE 1" = 20'

DATE JULY 1968