46-59

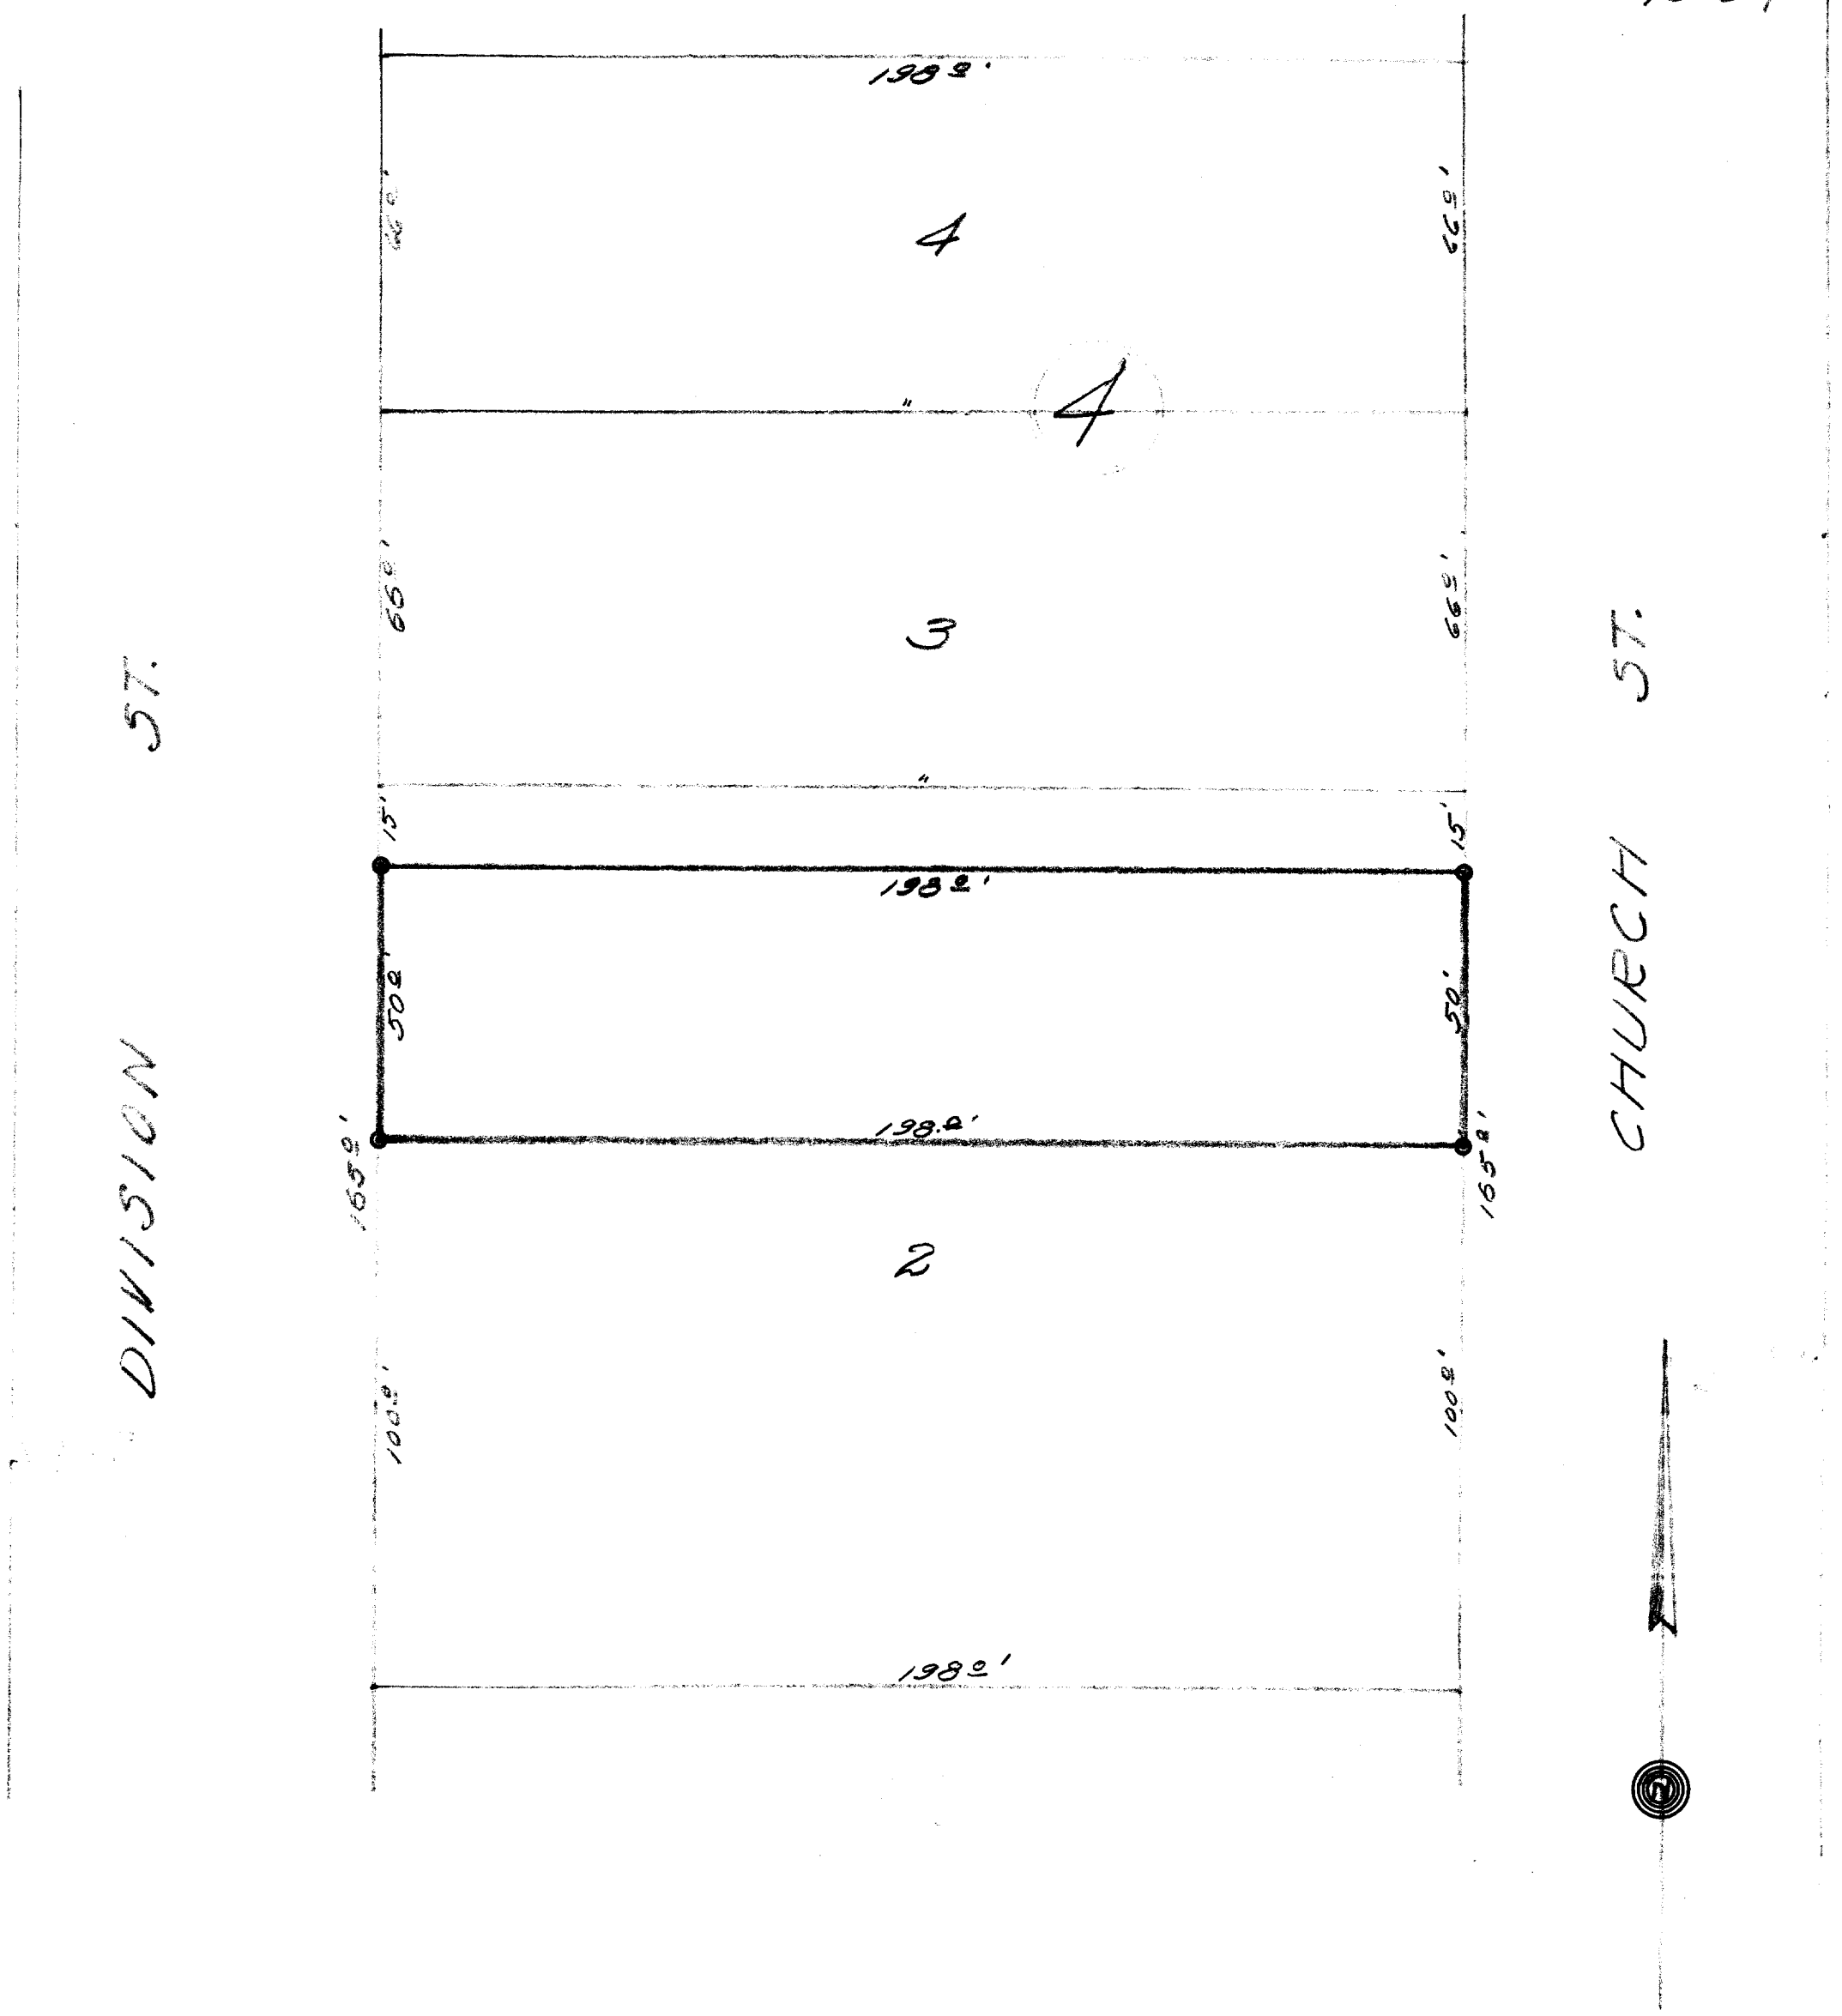

DESCRIPTION:

The south 50 feet of the north 65 feet of Lot 2 Block 4 S. B. Edwards Addition to the Village of East Troy, Walworth County, Wisconsin.

CERTIFICATE:

I, Joseph M. Biagi, hereby certify that I have on this the 21st day of August surveyed the above described property according to the official records on file in the office of the Recorder of Deeds in and for Walworth County, Wisconsin, and find that the measurements and bearings of the boundary lines of said property as taken at the site on this day, substantially agree with those in the above description and that no encroachments exist.

SIGNED AND SEALED ON THIS THE 22ND DAY OF AUGUST 1946.

Joseph M. Biagi.
Professional Engineer.
Elkhorn Wisconsin.

3-46