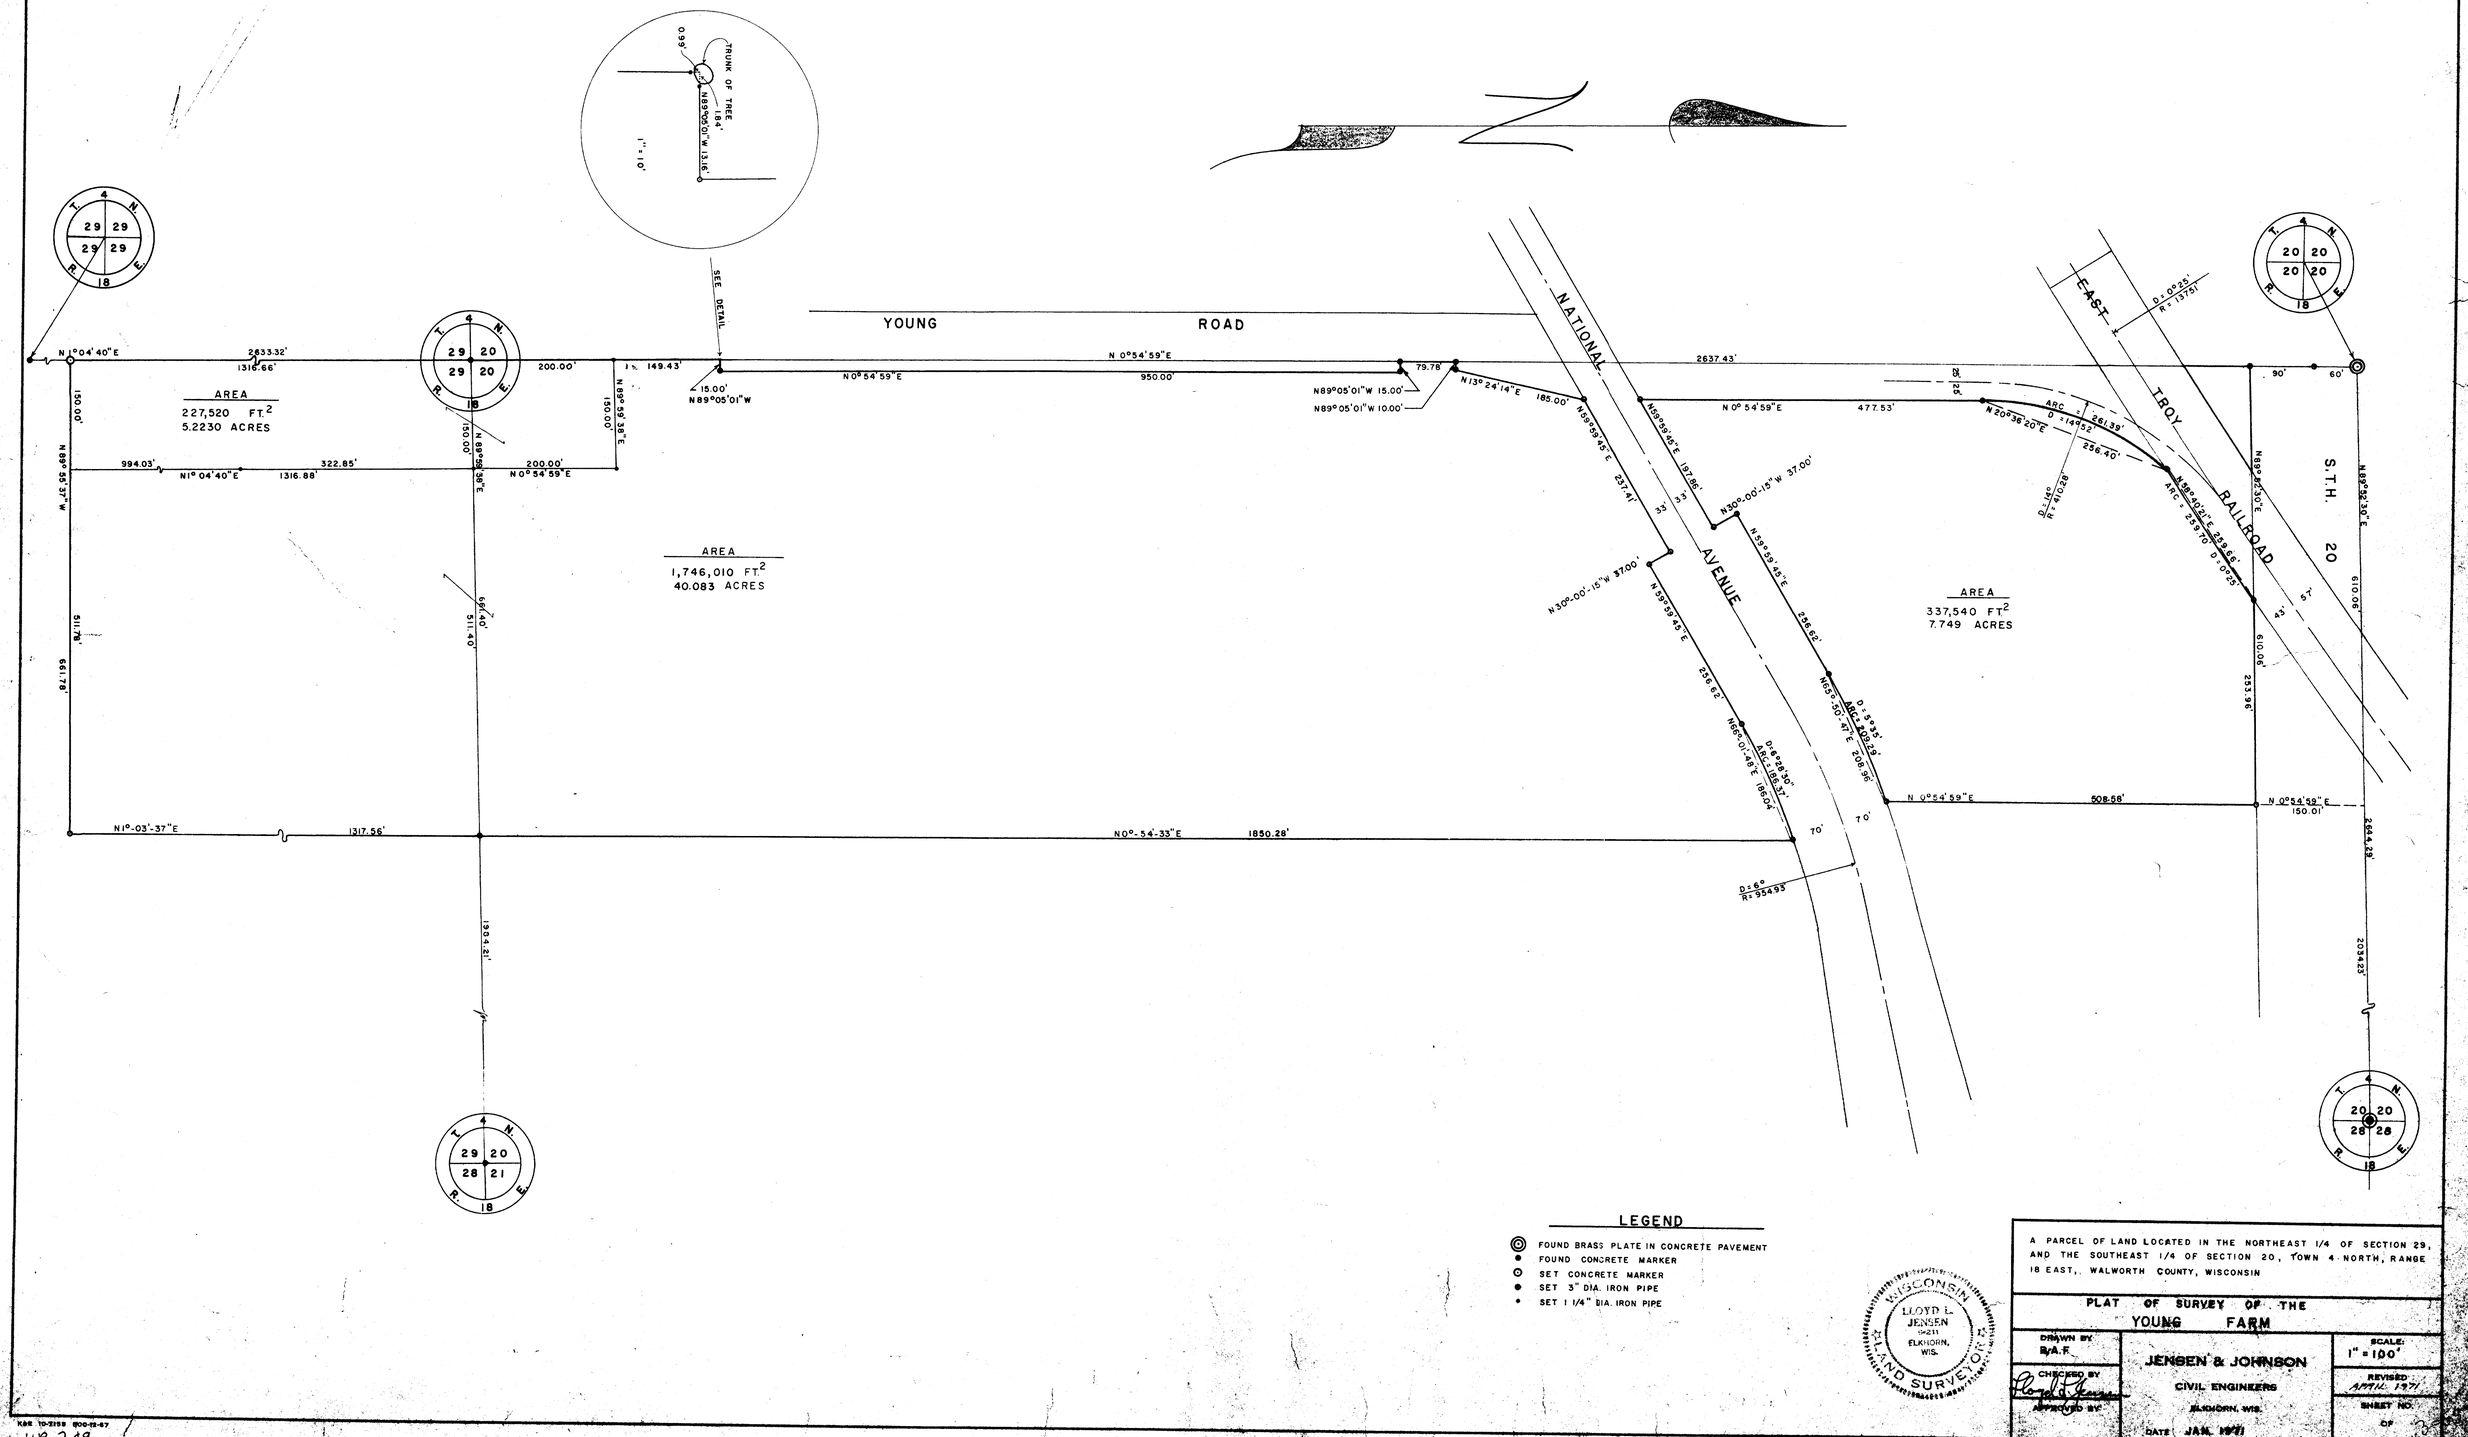


LEGEND

- ◎ FOUND BRASS PLATE IN CONCRETE PAVEMENT
- ● FOUND CONCRETE MARKER
- ⊙ SET CONCRETE MARKER
- ● SET 3" DIA. IRON PIPE
- • SET 1 1/4" DIA. IRON PIPE

WISCONSIN
LLOYD L. JENSEN
S-211
ELKHORN, WIS.
LAND SURVEYOR

A PARCEL OF LAND LOCATED IN THE NORTHEAST 1/4 OF SECTION 29, AND THE SOUTHEAST 1/4 OF SECTION 20, TOWN 4 NORTH, RANGE 18 EAST, WALWORTH COUNTY, WISCONSIN

PLAT OF SURVEY OF THE YOUNG FARM

DRAWN BY: B.A.F	JENSEN & JOHNSON CIVIL ENGINEERS ELKHORN, WIS.	SCALE: 1" = 100'
CHECKED BY: Lloyd L. Jensen		REVISED: APRIL 1971
APPROVED BY:	DATE: JAN. 1971	SHEET NO. OF

K&E 10-2158 (100-12-67)

UP-209
11-209B