
PLAT OF SURVEY

LOT 98, STERLING OAKS ADDITION NO.1 , being a part of the Northwest 1/4 and Southwest 1/4 of the Northeast 1/4 and a part of the Northeast 1/4 and Southeast 1/4 of the Northwest 1/4, all in Section 20, Town 4 North, Range 18 East, Village of East Troy, Walworth County, Wisconsin.

Surveyed for: Bielinski Bros. Builders Inc/ Jason Brazer & Becky Lajsic

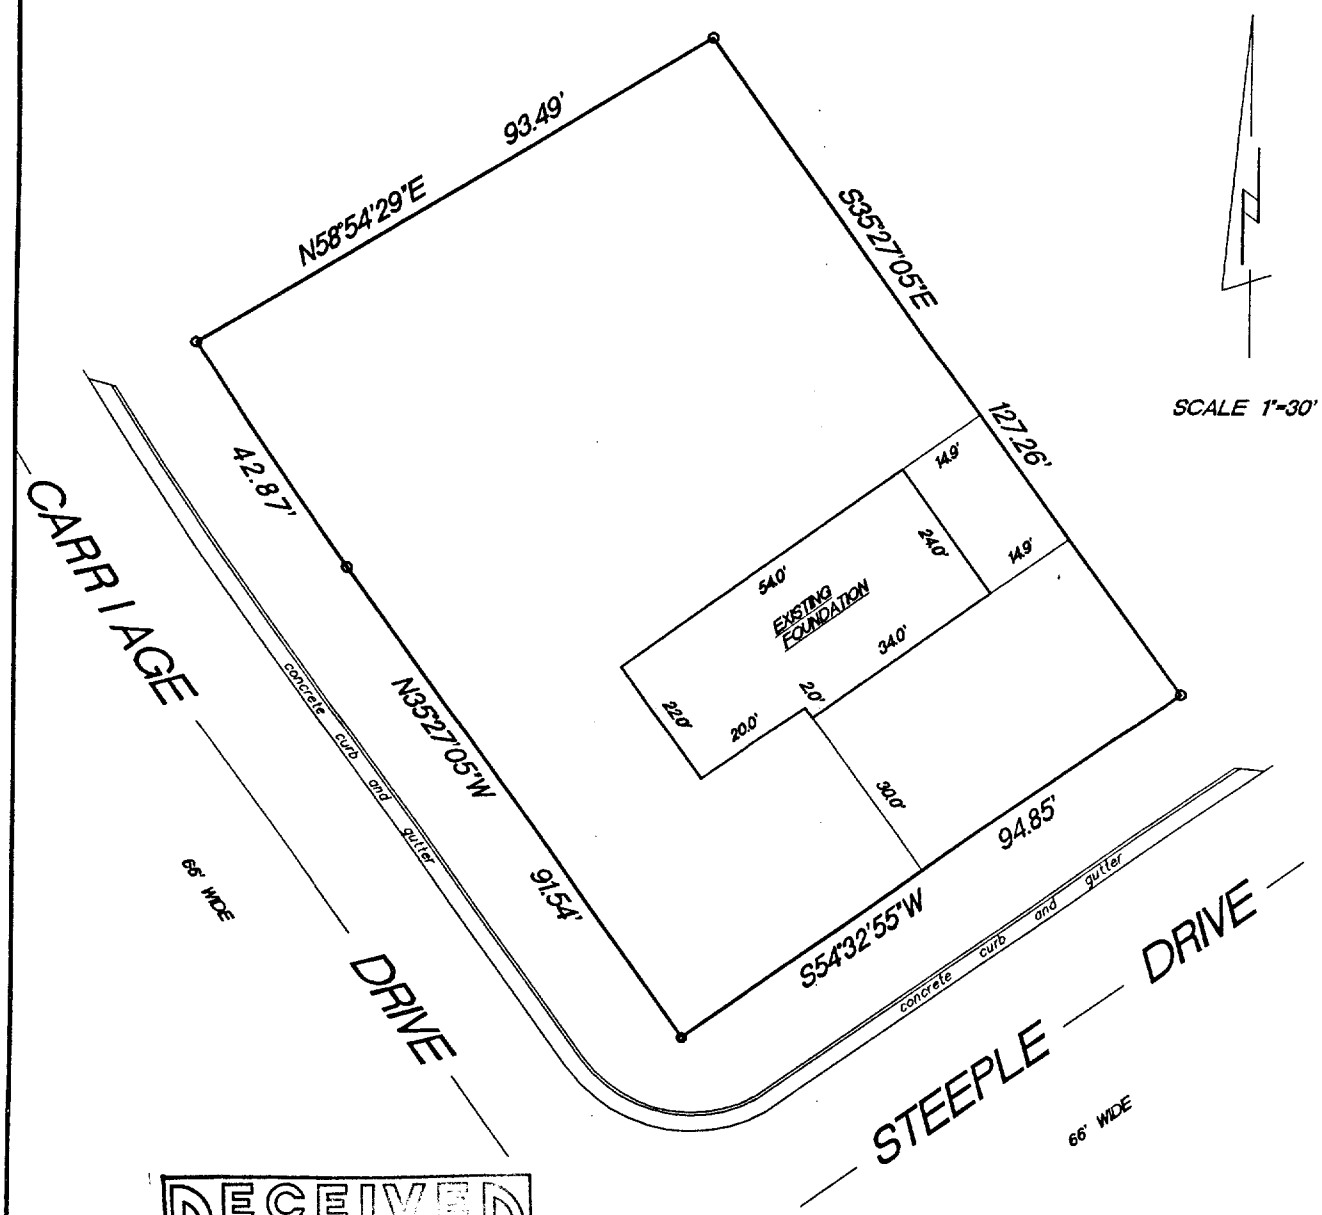

RECEIVED
MAR 22 1999

○ FOUND 1" IRON PIPE

● FOUND NAIL

RADIUS	LENGTH	CHORD	BEARING	DELTA
563.22'	42.87'	42.86'	N33°16'15"W	04°21'40"

"I hereby certify that I have surveyed the above described property and that the above map is a true representation thereof and shows the size and location of the property, its exterior boundaries, the location of all visible structures and dimension of all principal buildings thereon, boundary fences, apparent easements, roadways and encroachments if any."

"This survey is made for the use of the present owners of the property, and also those who purchase, mortgage or guarantee the title thereto within one year from date hereof."

KETTLE MORAINE SURVEYING

W362 S10227 Lewin Lane
Eagle, Wisconsin 53119
Terrance E.Pisarek R.L.S.

(414) 594-3484
fax (414) 594-5904

THIS IS NOT AN ORIGINAL SURVEY UNLESS THE SEAL IS RED.

REV. 2/8/99 10/16/98	TEP/DW	TEP	98255
DATE	FIELD WORK BY	DRAWN BY	JOB NUMBER

RST01-28 003-594