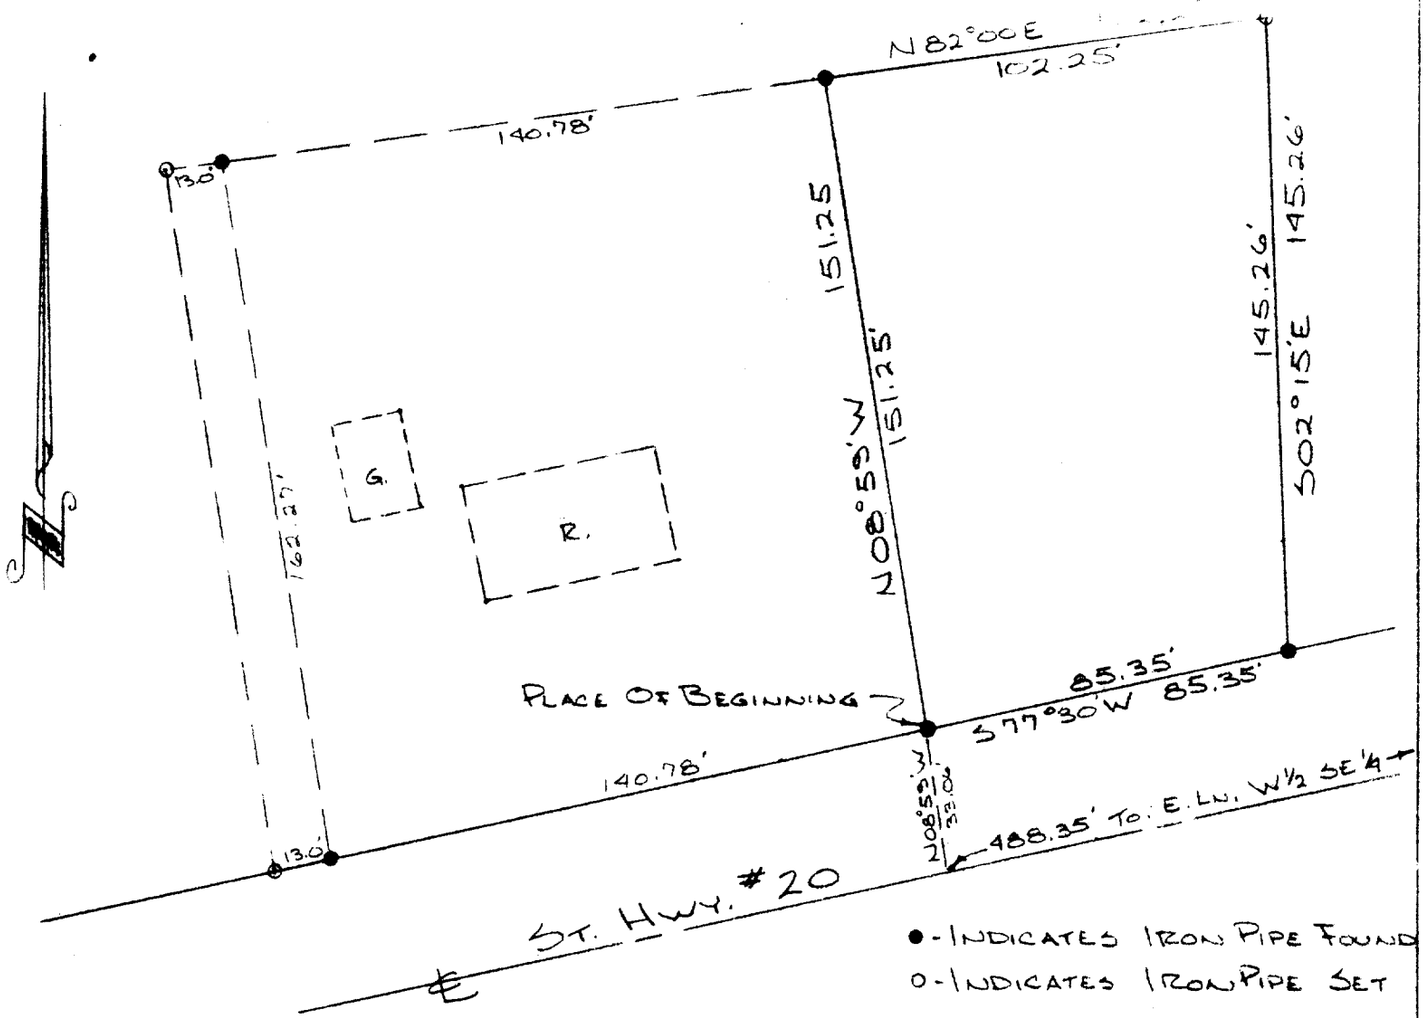


DESCRIPTION: Commencing at the point of intersection of the center line of ST. HWY. #20 and the East line of the W½ of the SE¼ of Section 19, T. 4 N., R 16 E., Walworth County, Wisconsin; thence SW'ly along the center line of ST. HWY. #20, 488.35 feet, thence N. 08° 59' W. 33.06 feet to the place of beginning of the lands hereinafter described, to-wit: thence continue N. 08° 59' W. 151.25 feet, thence N. 82° 00' E. 102.25 feet, thence S. 02° 15' E. 145.26 feet, to the N'ly. ROW line of said Hwy., thence S 77° 30' W. 85.35 feet along said N'ly row line to the place of beginning.

CERTIFICATE: I James F. Biagi, surveyor, do hereby certify that I have surveyed the property hereon described.

August 2, 1971.

WISCONSIN
JAMES F.
BIAGI
MILWAUKEE,
WIS.
LAND SURVEYOR

James F. Biagi, RLS 272

ENGINEERS ASSOCIATED, INC.
228 W. WALWORTH ST.
ELKHORN, WISCONSIN

3-5B