
51-48

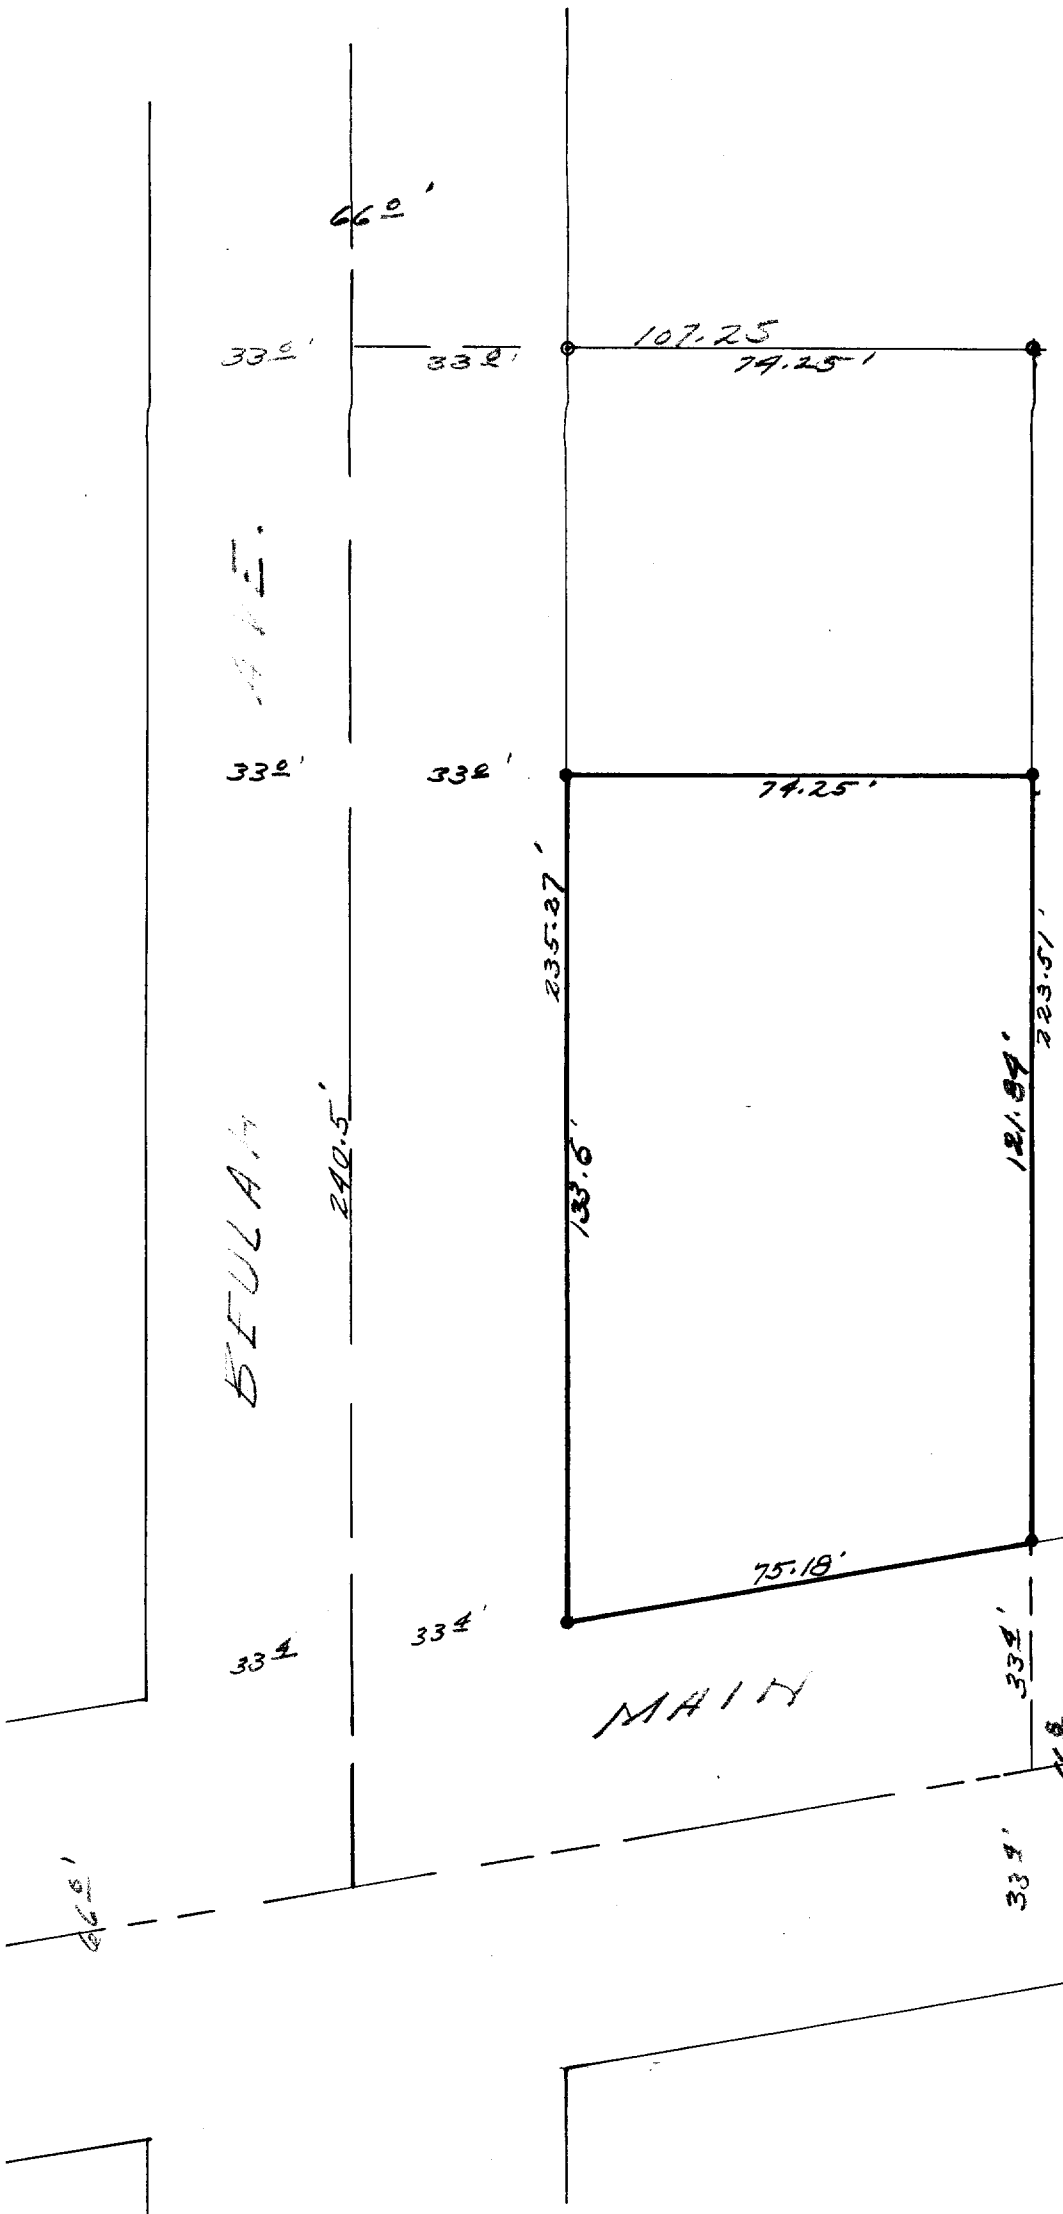

DESCRIPTION:

Commencing at the intersection of the north line of Main Street and the east line of Beulah Avenue in the Village of East Troy, Walworth County, Wisconsin; thence North in the east line of said Beulah Avenue, 133.6 feet to a point, thence East 74.25 feet to a point, thence South parallel with the east line of Beulah Avenue 121.84 feet to a point in the north line of Main Street, thence S. 81°W., along the north line of Main Street 75.18 feet to the place of beginning.

CERTIFICATE:

I, hereby certify that I have on this the 2nd day of June , 1951, surveyed the above described property according to the official records on file in the office of the Recorder of Deeds in and for Walworth County, Wisconsin, and find that measurements and bearings of the boundary lines of said property as taken at the site on this day, substantially agree with those in said official record and that no encroachments exist.

SIGNED AND SEALED ON THSI THE 5TH DAY OF JUNE 1951.

Joseph M. Biagi. Professional Engineer.
Elkhorn Wisconsin.

TP. 96

3-66 B