
PLAT OF SURVEY

OF

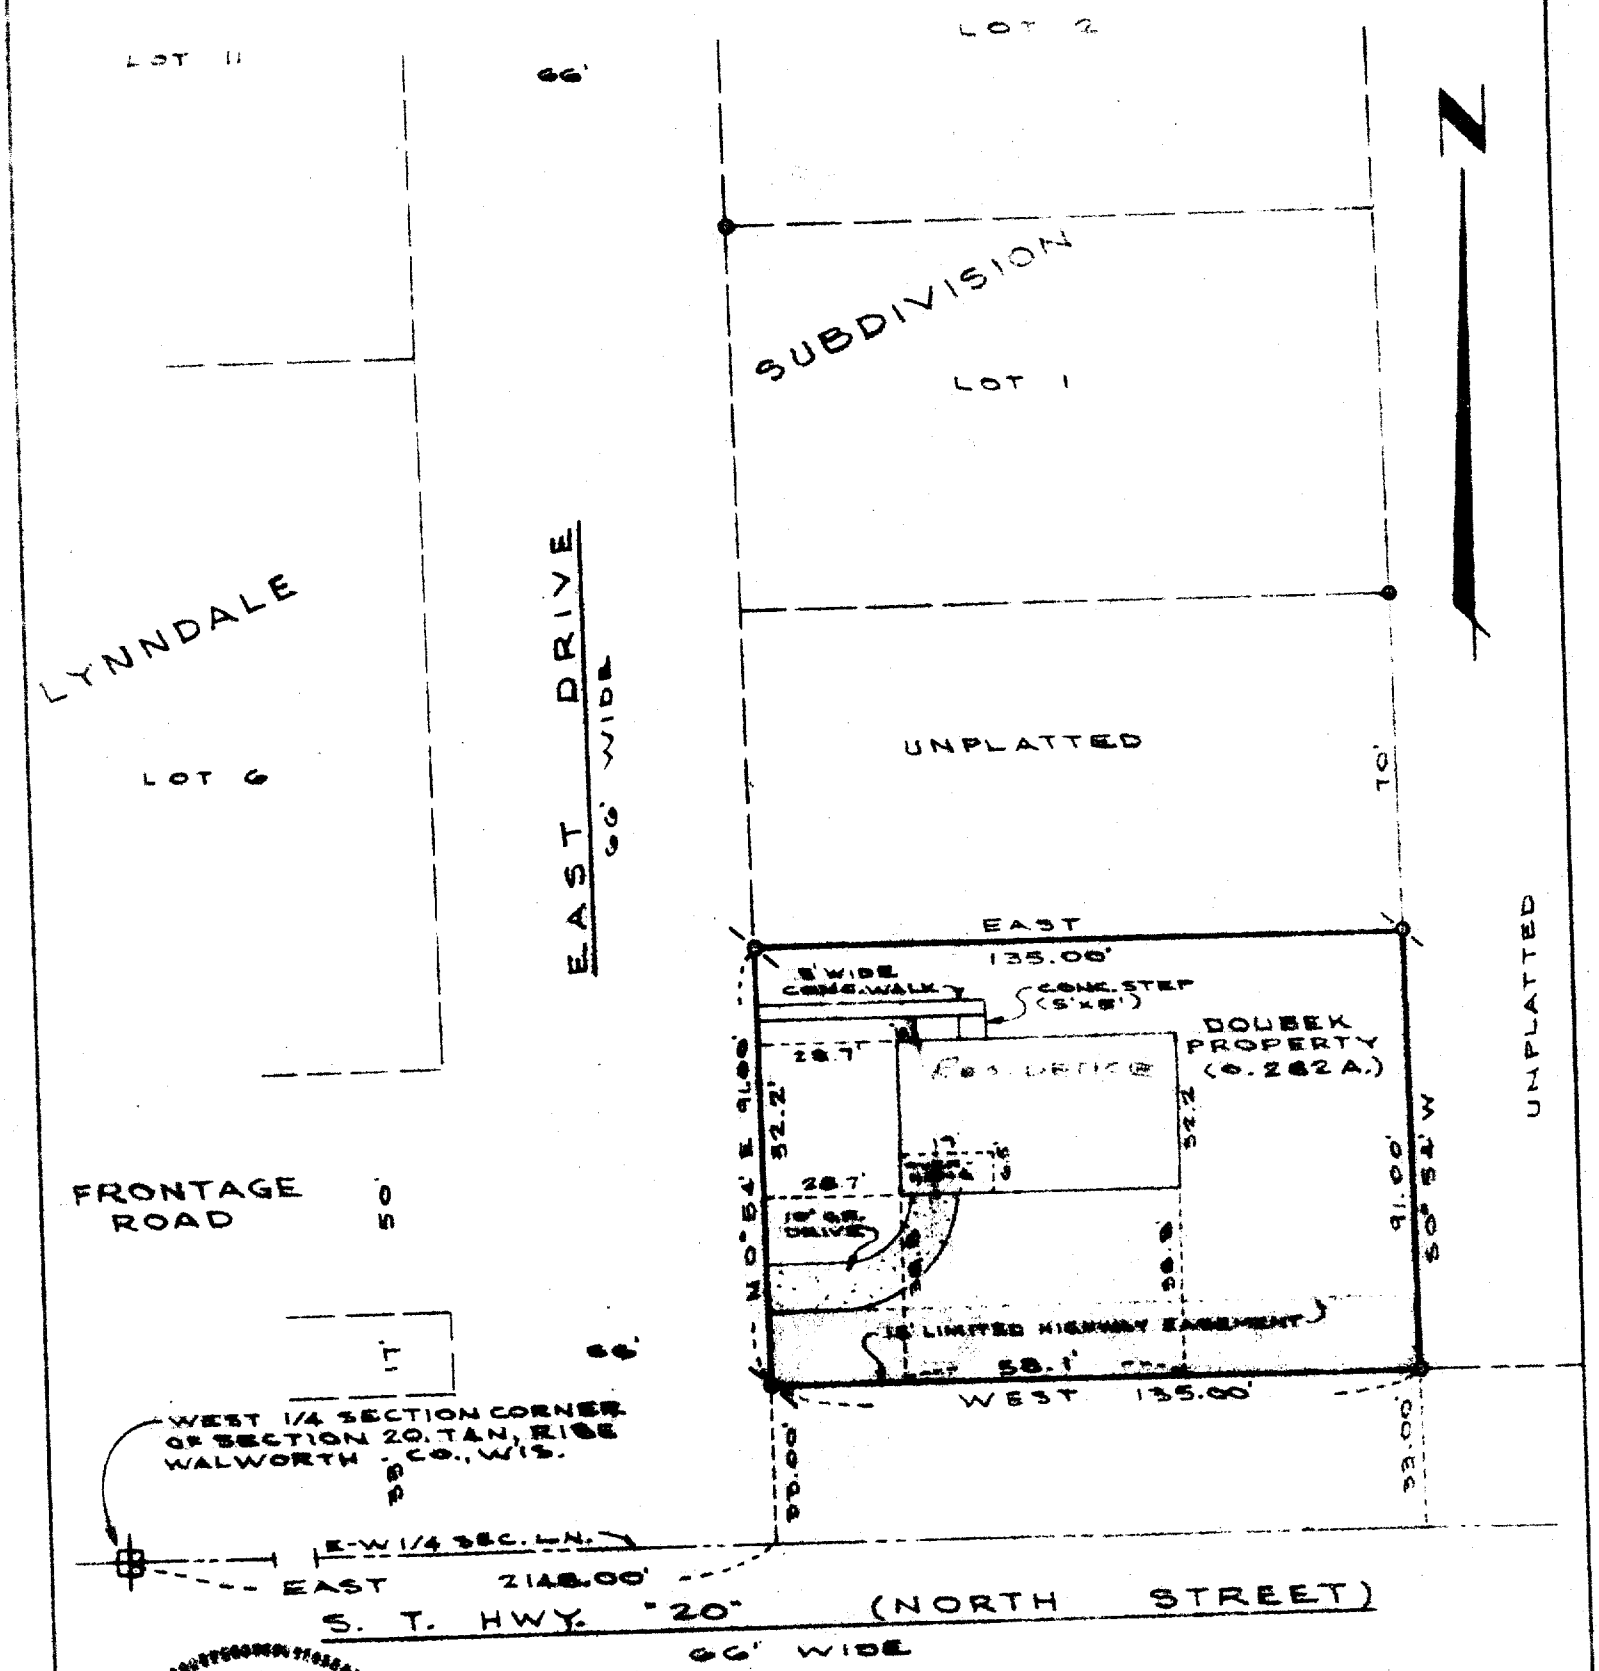

WISCONSIN
LLOYD L JENSEN
S-211
ELKHORN, WIS.
LAND SURVEYOR

LEGEND

○ — Iron Pipe Found
o — Iron Pipe Set
● — Concrete Monument

Scale 1" = 40'

SURVEY AND PLAT BY

JENSEN & JOHNSON, INC.

CIVIL ENGINEERS AND SURVEYORS

Elkhorn, Wisconsin

WE CERTIFY: That we have surveyed the above described property and that the plat shown hereon is an accurate survey and a true representation thereof and correctly shows the exterior boundary lines and all divisions of said property, and buildings thereon.

Date JUNE 1971

Lloyd L Jensen

LLOYD L. JENSEN,

Wisconsin Registered Land Surveyor, No. S-211

3-68J

17801—800—11-68

UP- 120 — (South 91')