
278-65

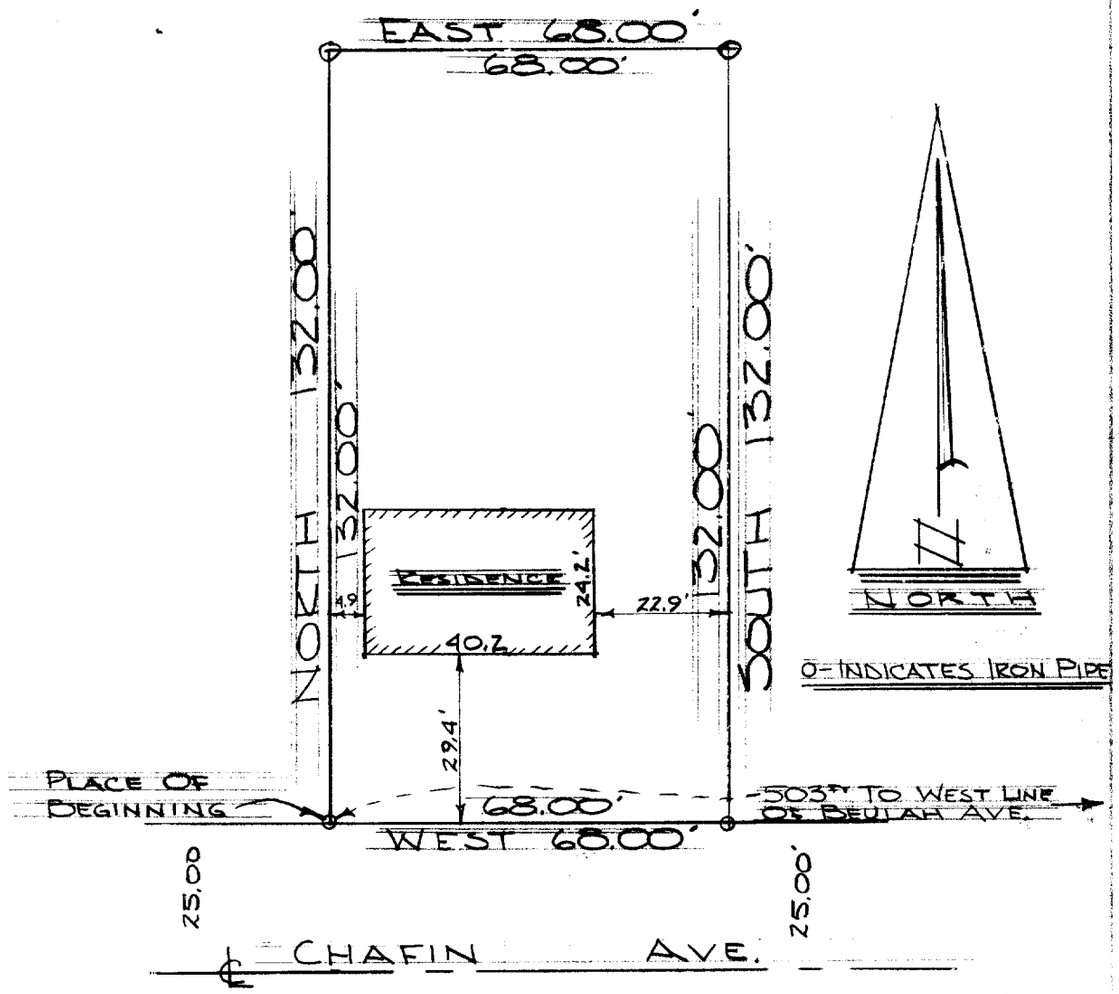

DESCRIPTION: Commencing at an iron stake in the North line of Chafin Avenue in the Village of East Troy, Walworth County, Wisconsin; that is 503.00 feet West of the West line of Beulah Avenue in said village, thence North 132.00 feet to an iron stake, thence East 68.00 feet to an iron stake, thence South 132.00 feet to an iron stake in the North line of said Chafin Avenue, thence West along the North of said Chafin Avenue 68.00 feet to the place of beginning.

CERTIFICATE: I, hereby certify that I have surveyed the above mentioned property and that the hereon portrayed is an accurate survey and a true representation thereof and correctly shows the exterior boundary lines and the location of the buildings and the other improvements thereof.

December 15, 1965.

James F. Biagi RLS 272

WISCONSIN JAMES F. BIAGI MILWAUKEE, WIS. LAND SURVEYOR

UP-37

3-71 B