
#94-70

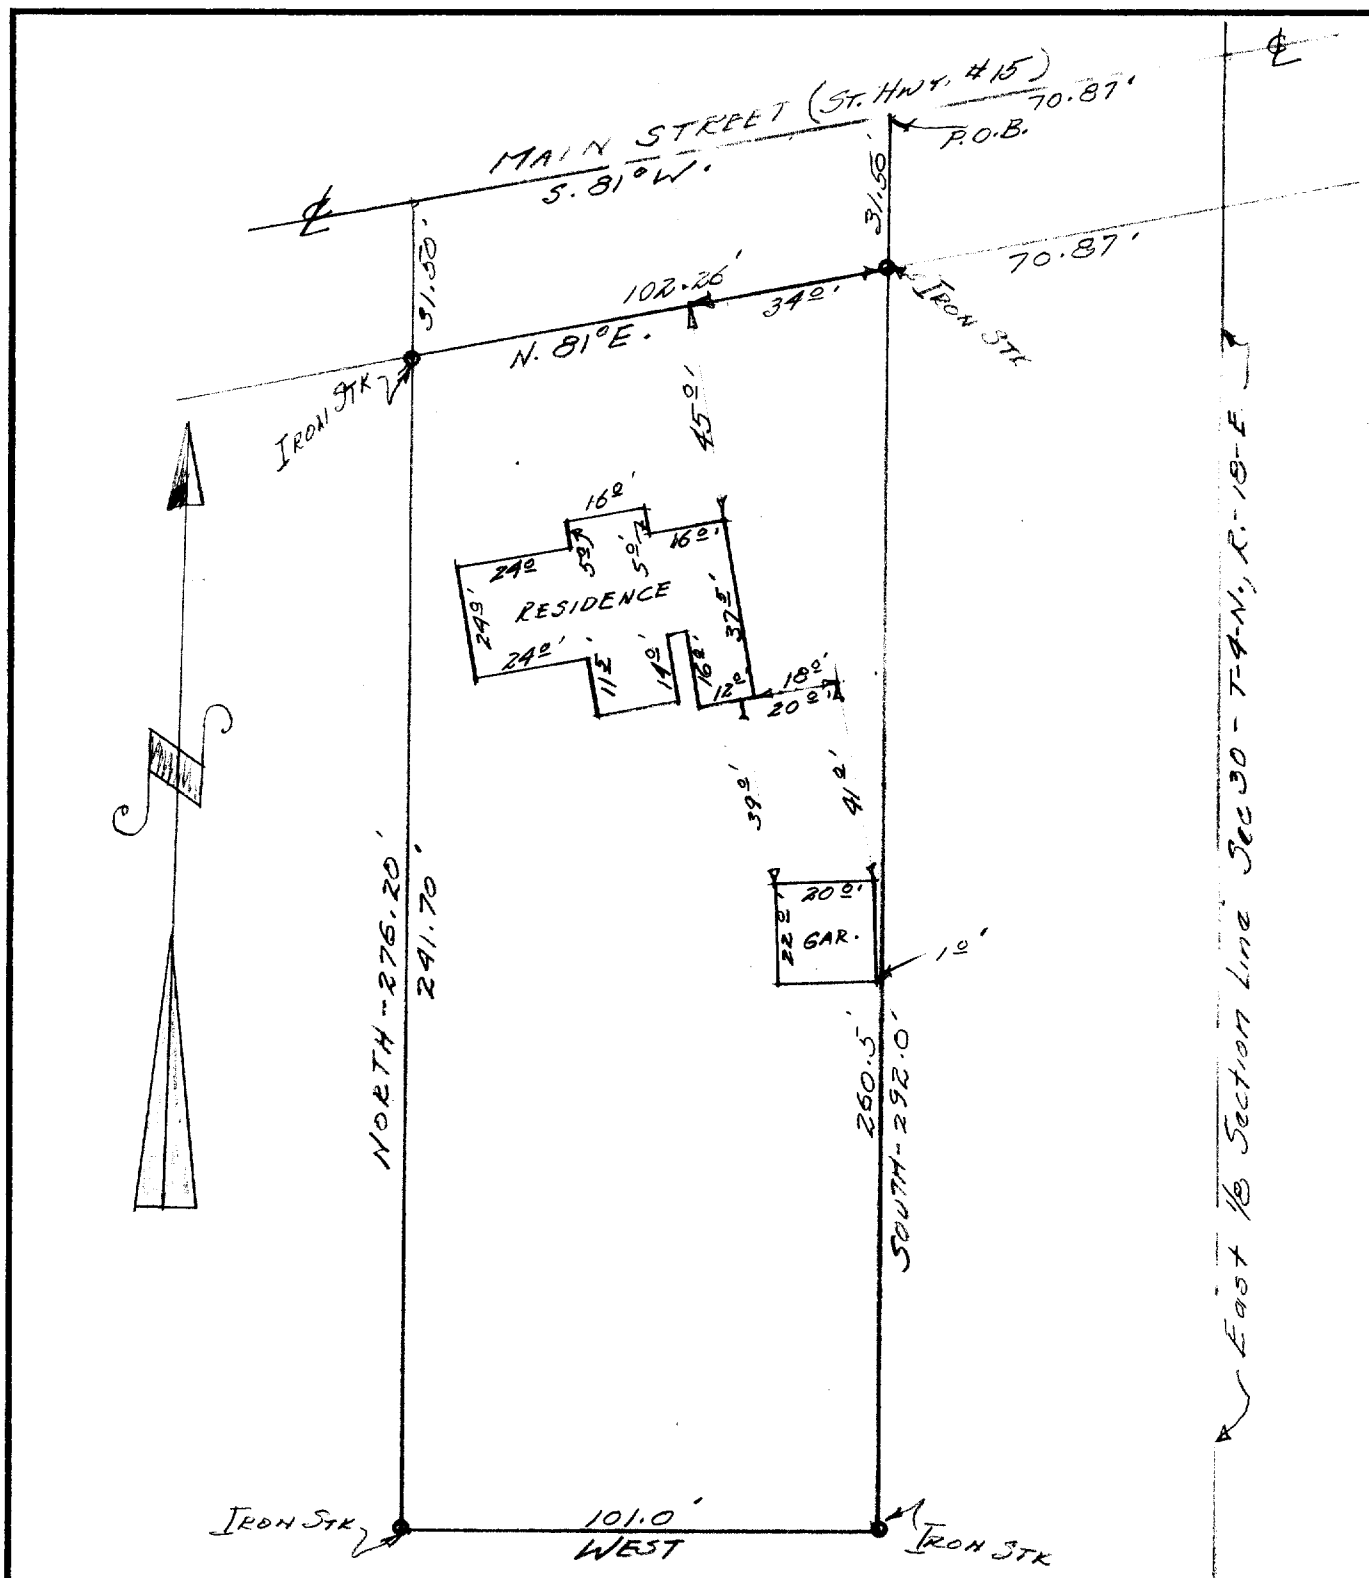

DESCRIPTION: Commencing at a point that is 70.87 feet, S. 81° W., of the intersection of the East 1/8th section line of Section 30, Town 4 north, Range 18 east of the 4th P.M., in the Village of East Troy, Walworth County, Wisconsin and the centerline of the Milwaukee Beloit Road (STH #15); thence South 292.00 feet to a point, thence West 101.00 feet to a point, thence North 276.20 feet to a point in the centerline of said highway, thence N. 81° E., 102.26 feet to the place of beginning.

CERTIFICATE: I, Joseph M. Biagi, surveyor do hereby certify that I have surveyed the property hereon described and the drawing shown above is an accurate portrayal of the survey.

Signed and sealed
May 15th 1970.

Joseph M. Biagi RLS #12
Elkhorn, Wisconsin.

UP 181

3-73B