
PLAT OF SURVEY

LOT 175, STERLING OAKS ADDITION NO. 1, being a part of the Northwest 1/4 and Southwest 1/4 of the Northeast 1/4 and a part of the Northeast 1/4 and Southeast 1/4 of the Northwest 1/4, all in Section 20, Town 4 North, Range 18 East, Village of East Troy, Walworth County, Wisconsin.

Surveyed for: Bielinski Bros. Builders Inc./Thomas Couillard

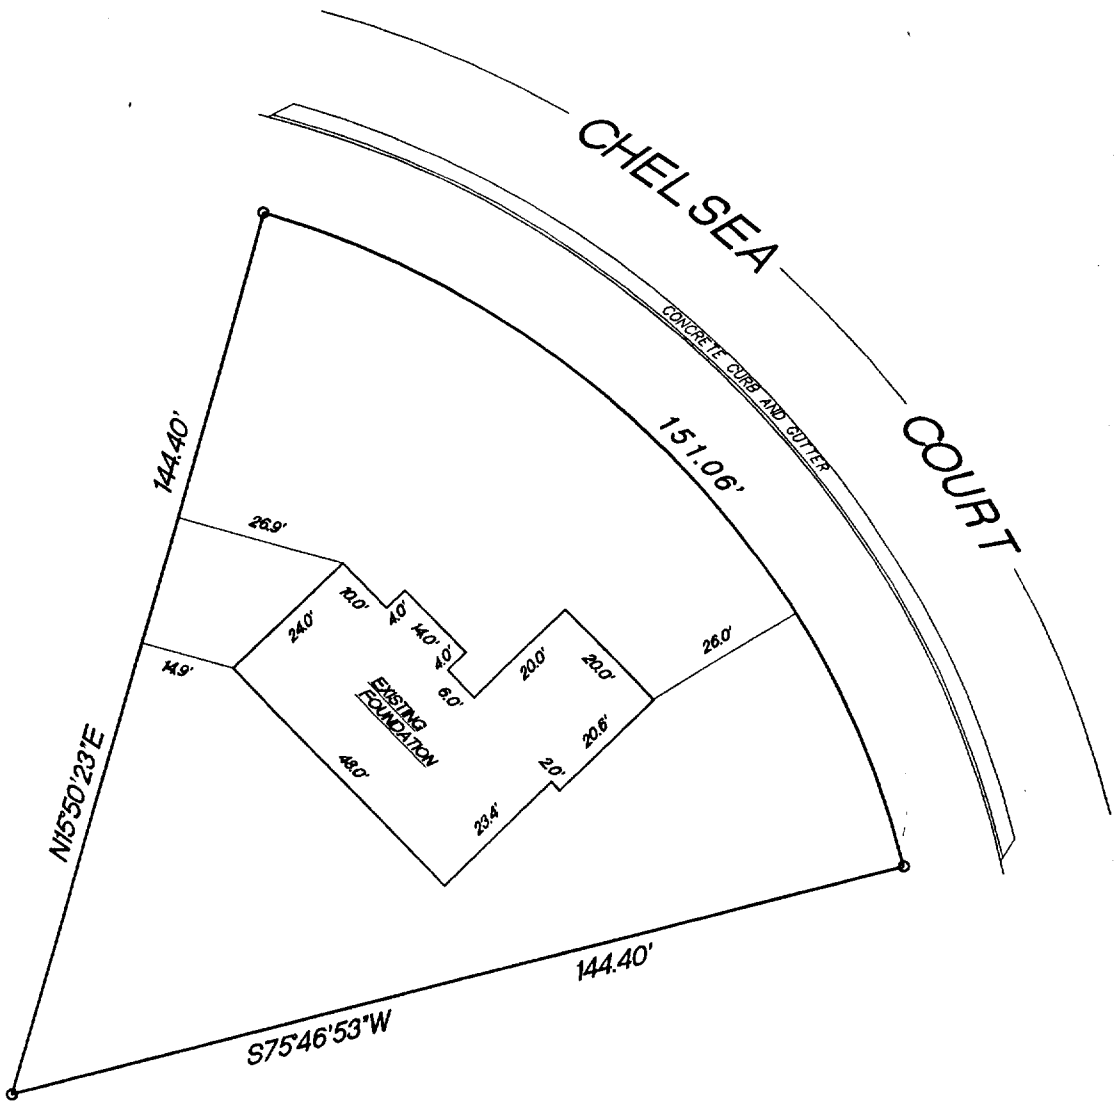

RECEIVED
FEB 19 2001

o FOUND 1" IRON PIPE

SCALE 1"=30'

RADIUS	LENGTH	CHORD	BEARING	DELTA
144.40'	151.06'	144.27'	S44°11'22.5"E	59°56'25"

"I hereby certify that I have surveyed the above described property and that the above map is a true representation thereof and shows the size and location of the property, its exterior boundaries, the location of all visible structures and dimension of all principal buildings thereon, boundary fences, apparent easements, roadways and encroachments if any."

"This survey is made for the use of the present owners of the property, and also those who purchase, mortgage or guarantee the title thereto within one year from date hereof."

KETTLE MORAINE SURVEYING
W356 S9050 Godfrey Lane
Eagle Wisconsin 53119
P.O. Box 357
(262) 594-3484
Terrance E. Pisarek R.L.S.

TERRANCE E. PISAREK S-2021 WISCONSIN LAND SURVEYOR

THIS IS NOT AN ORIGINAL SURVEY UNLESS THE SEAL IS RED.

DATE	FIELD WORK BY	DRAWN BY	JOB NUMBER
REV. 1/2/01 11/28/00	TEP/DW	TEP	00304

RST01-105

003-743


PLAT OF SURVEY

LOT 175, STERLING OAKS ADDITION NO. 1, being a part of the Northwest 1/4 and Southwest 1/4 of the Northeast 1/4 and a part of the Northeast 1/4 and Southeast 1/4 of the Northwest 1/4, all in Section 20, Town 4 North, Range 18 East, Village of East Troy, Walworth County, Wisconsin.

Surveyed for: Bielinski Bros. Builders Inc./Thomas Couillard

Suggested yard grade per grading plan: 863.1

RECEIVED
DEC 13 2000

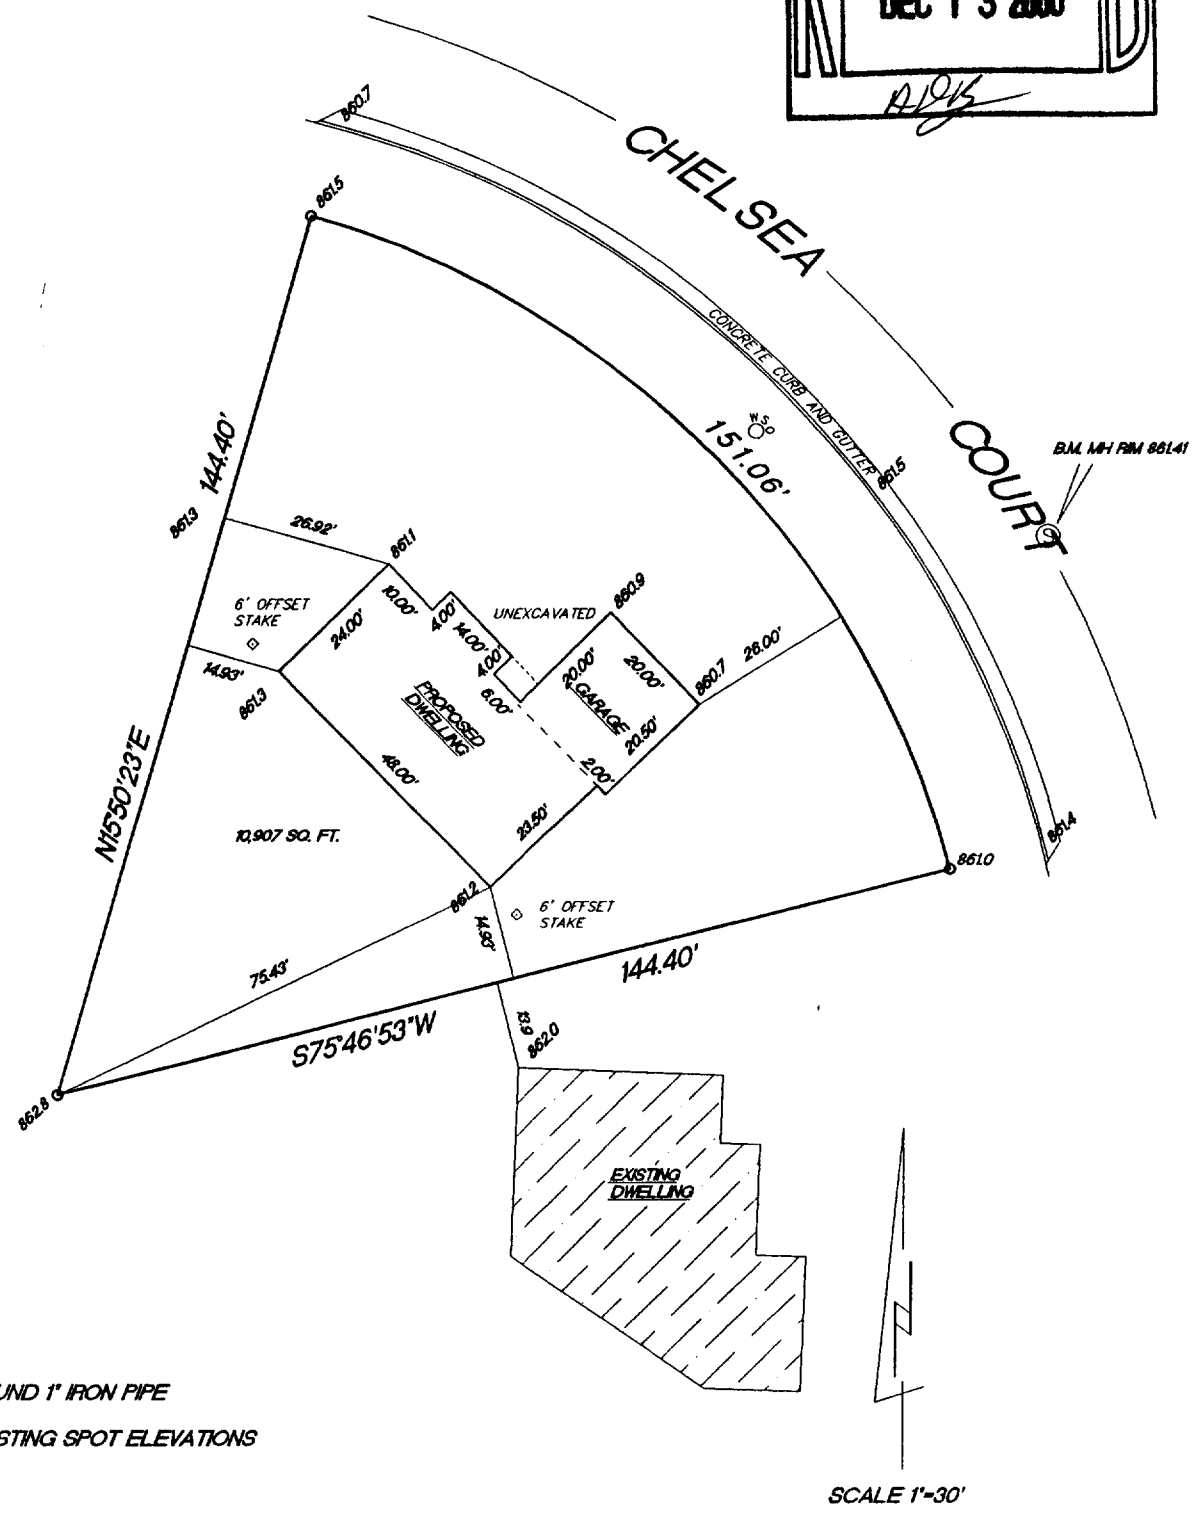

o *FOUND 1" IRON PIPE*

862.2 *EXISTING SPOT ELEVATIONS*

RADIUS	LENGTH	CHORD	BEARING	DELTA
144.40'	151.06'	144.27'	S44°11'22.5"E	59°56'25"

"I hereby certify that I have surveyed the above described property and that the above map is a true representation thereof and shows the size and location of the property, its exterior boundaries, the location of all visible structures and dimension of all principal buildings thereon, boundary fences, apparent easements, roadways and encroachments if any."

"This survey is made for the use of the present owners of the property, and also those who purchase, mortgage or guarantee the title thereto within one year from date hereof."

KETTLE MORAINE SURVEYING
W356 S9050 Godfrey Lane
Eagle Wisconsin 53119
P.O. Box 357
(262) 594-3484
Terrance E. Pisarek R.L.S.

THIS IS NOT AN ORIGINAL SURVEY UNLESS THE SEAL IS RED.

11/28/00	TEP/DW	TEP	00304
DATE	FIELD WORK BY	DRAWN BY	JOB NUMBER

RST01-105

003-743