
58-33

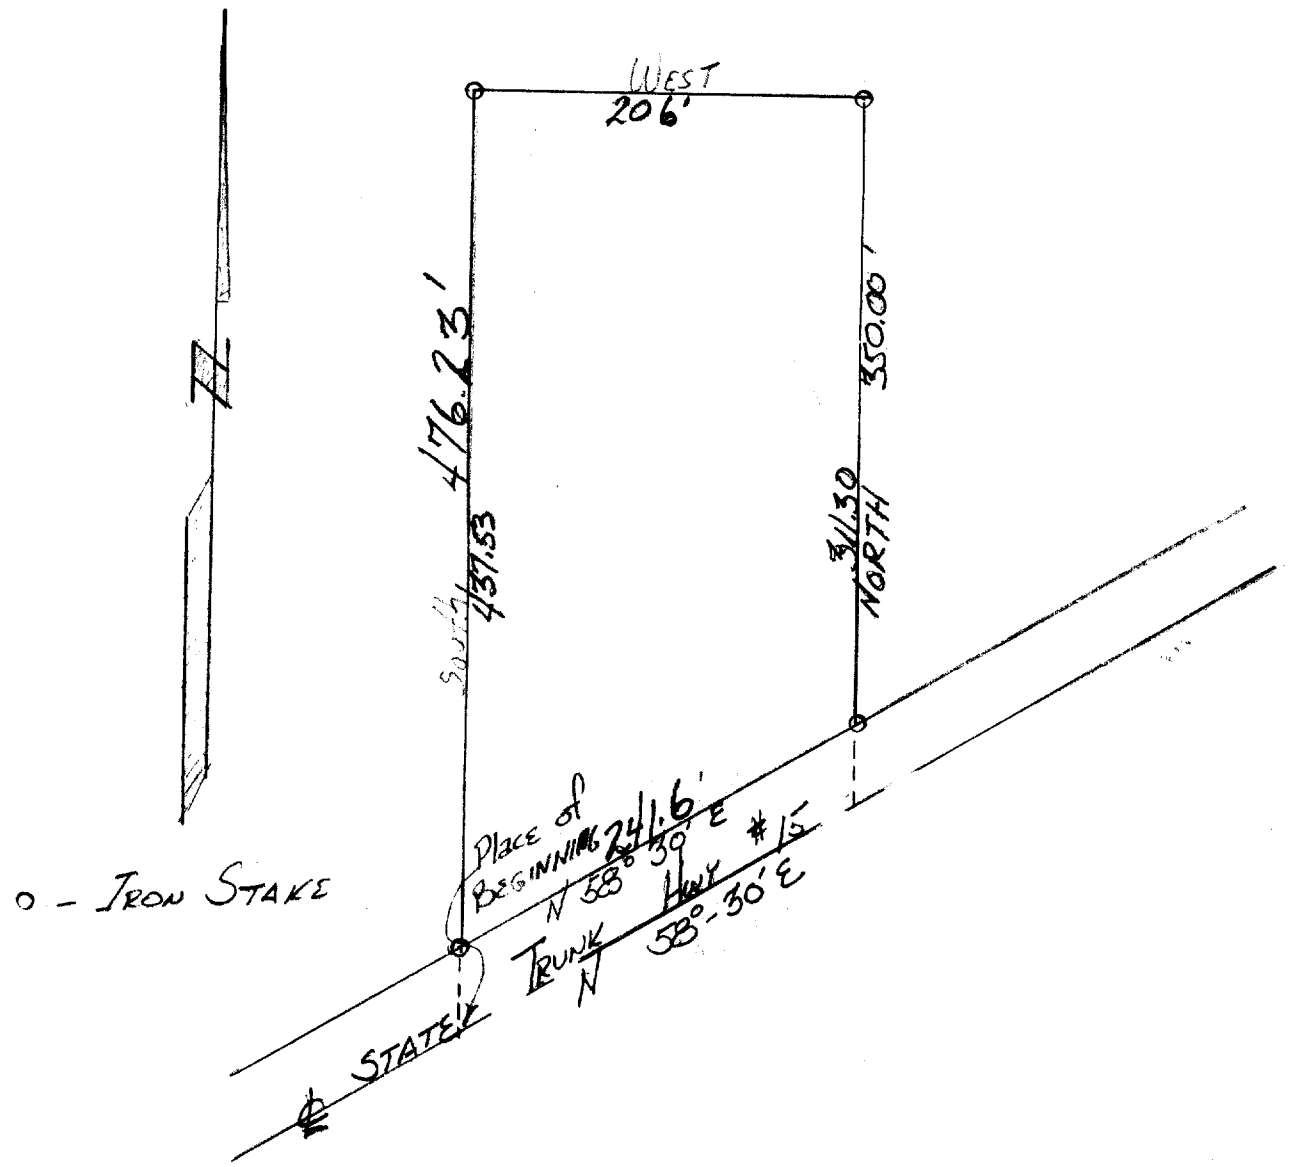

DESCRIPTION: Commencing at a point in the center line of State Trunk Hwy.#15 that is S 58°-30' W 38.70 feet from a point where said center line intersects the West boundary line of the East ½ of the East ½ of the South West ¼ of Section 20, Town 4 North, Range 18 East of the 4th Principal Meridian, Walworth County, Wisconsin, thence North 58°-30' East 241.60 feet to a point in said center line, thence North 350.00 feet to an iron stake, thence West 206.00 feet to an iron stake, thence South 476.23 feet to the place of beginning, containing 1.7 acres more or less.

CERTIFICATE: I, hereby certify that I have on this the 6th day of August 1958, surveyed the above described property, and that said survey corresponds with the above description and drawing, and that no enchroachments exist.

SIGNED AND SEALED ON THIS 6TH DAY OF AUGUST 1958

WISCONSIN
JAMES F.
BIAGI
MILWAUKEE,
WIS.
LAND SURVEYOR

James F. Biagi
LAND SURVEYOR(272)

UP-135

3-77B