PLAT OF SURVEY


- OF -

THE WEST 125 FEET OF LOT 1 OF BLOCK 17 IN THE VILLAGE OF EAST TROY, WALWORTH COUNTY, WISCONSIN, ACCORDING TO THE RECORED PLAT THEREOF, EXCEPT THE SOUTH 1/2 THEREOF.

PREPARED FOR ;

TIM LEWANDOWSKI
2128 CLARK ST.
EAST TROY, WIS.
53120

J.K. SURVEYING INC.
N3705 WILLOWBEND LANE
LAKE GENEVA, WI, 53147
262-248-3697

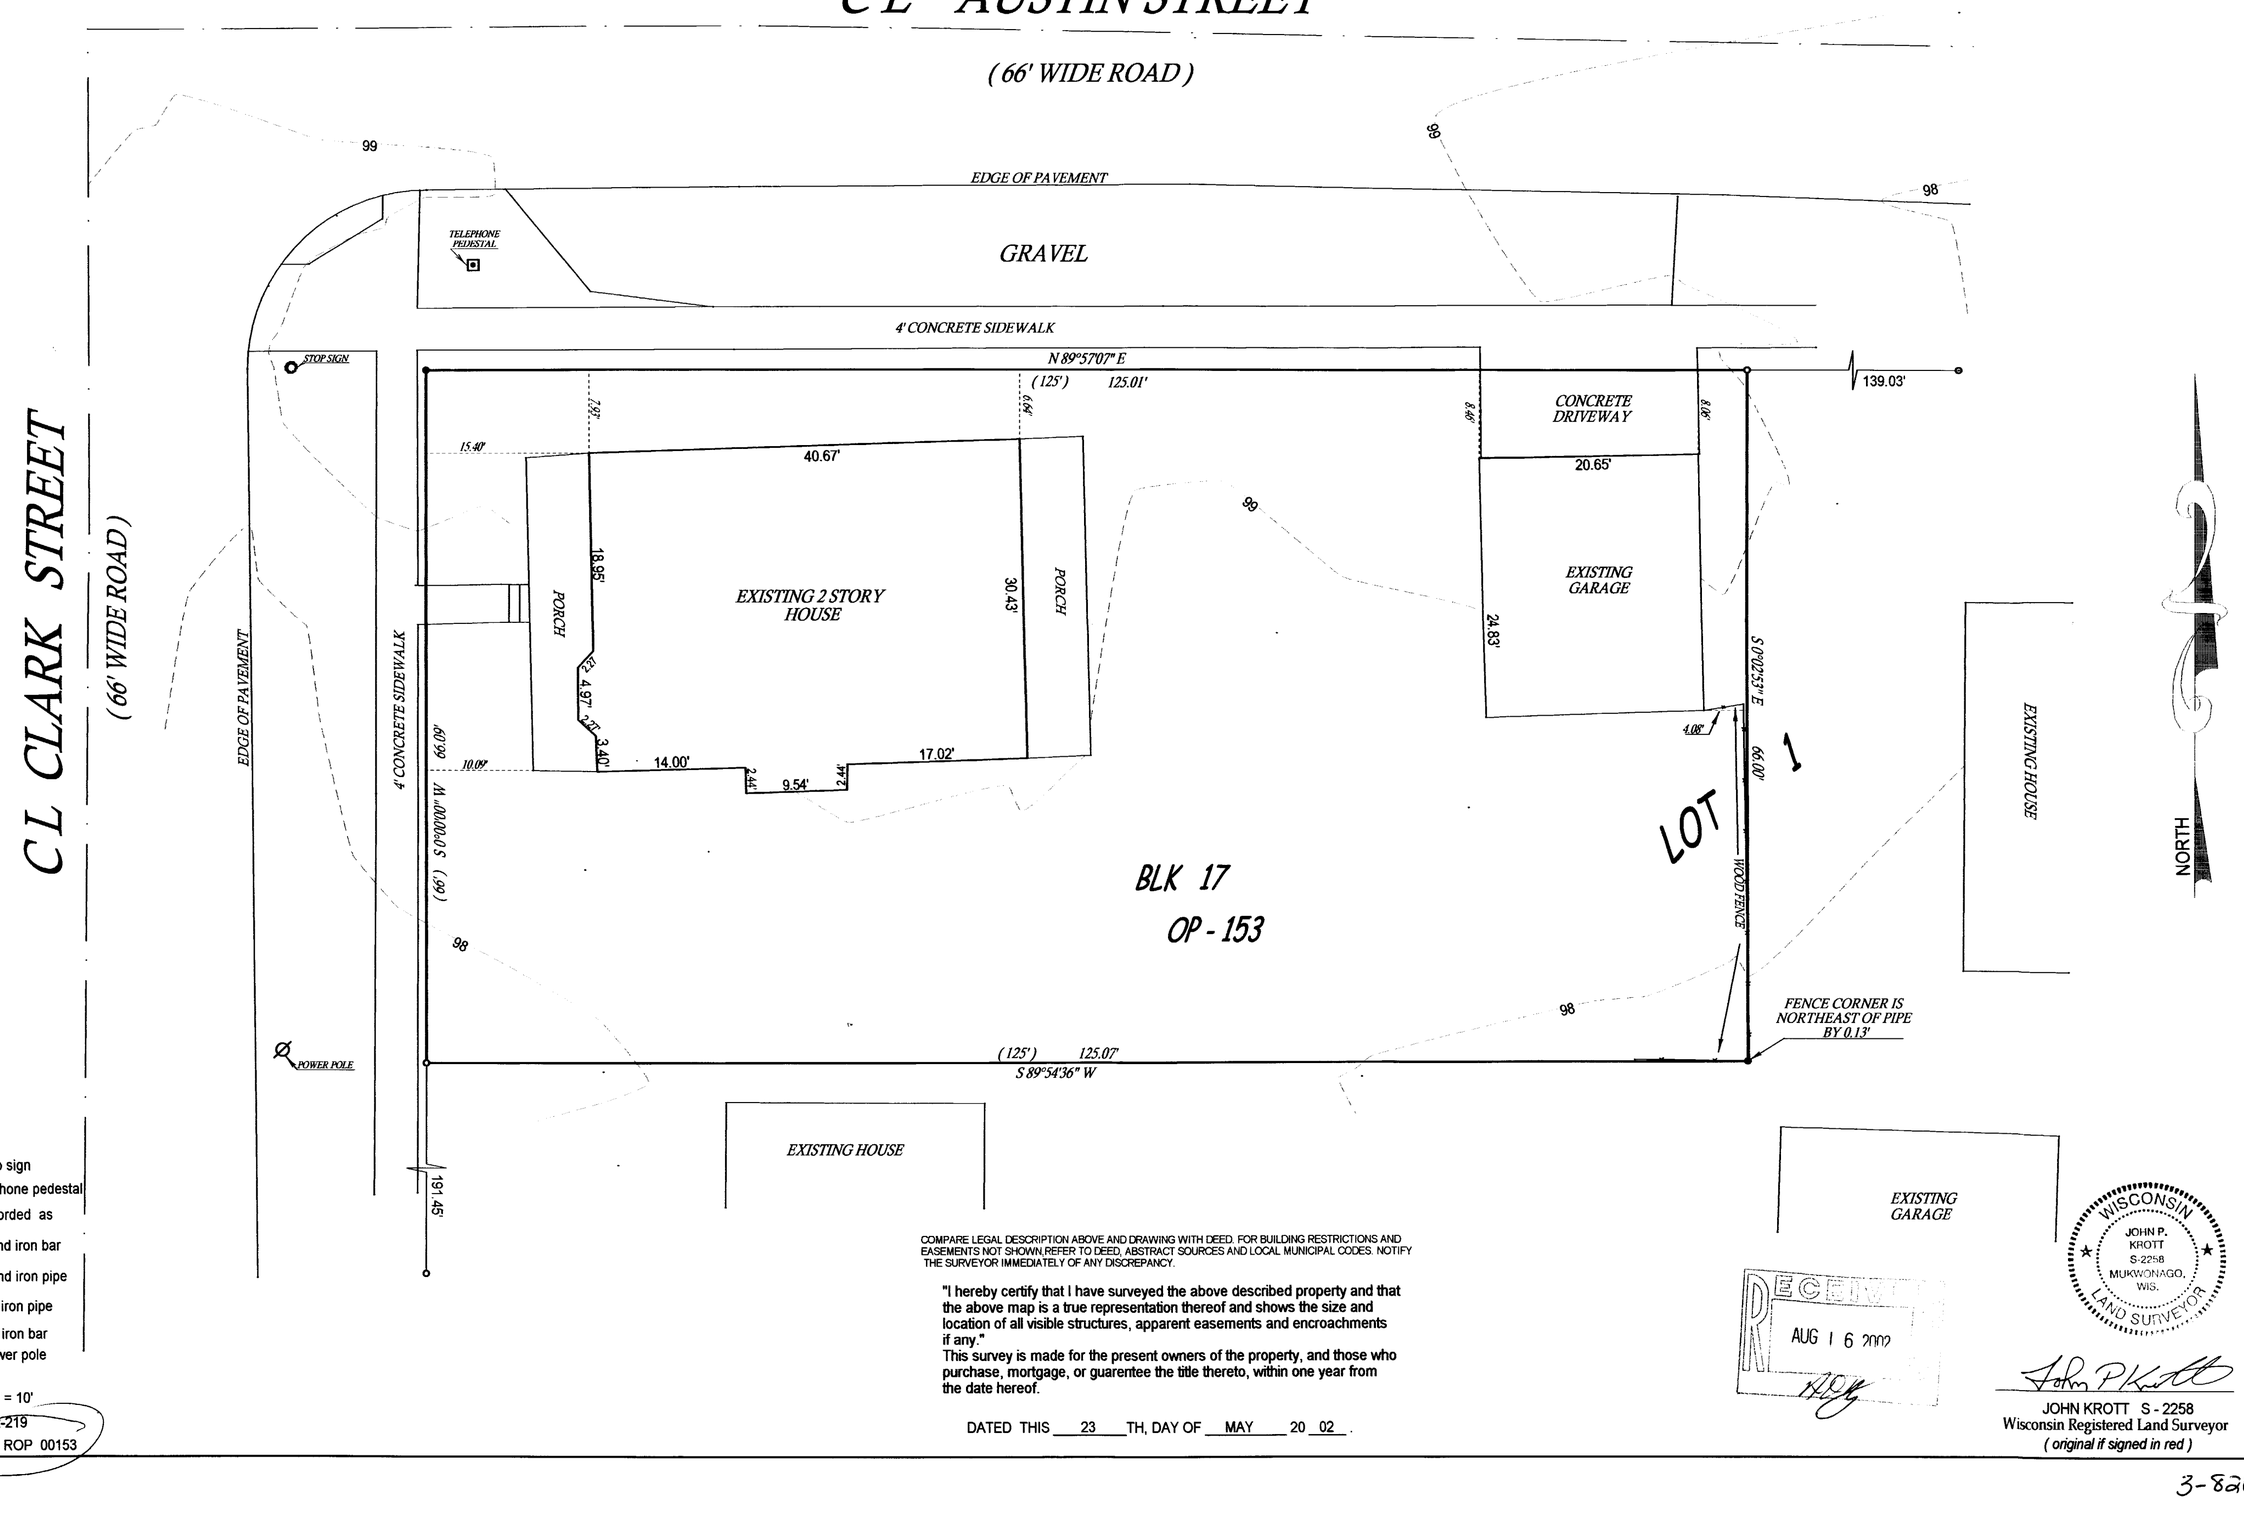

○ = stop sign
⊡ = telephone pedestal
( ) = recorded as
□ = found iron bar
○ = found iron pipe
● = set iron pipe
■ = set iron bar
Ø = power pole

SCALE 1" = 10'
JOB # 02-219
TAX ID # ROP 00153

COMPARE LEGAL DESCRIPTION ABOVE AND DRAWING WITH DEED. FOR BUILDING RESTRICTIONS AND EASEMENTS NOT SHOWN,REFER TO DEED, ABSTRACT SOURCES AND LOCAL MUNICIPAL CODES. NOTIFY THE SURVEYOR IMMEDIATELY OF ANY DISCREPANCY.

"I hereby certify that I have surveyed the above described property and that the above map is a true representation thereof and shows the size and location of all visible structures, apparent easements and encroachments if any."
This survey is made for the present owners of the property, and those who purchase, mortgage, or guarentee the title thereto, within one year from the date hereof.

DATED THIS 23 TH, DAY OF MAY 20 02 .

RECEIVED
AUG 16 2002

WISCONSIN
JOHN P. KROTT
S-2258
MUKWONAGO, WIS.
LAND SURVEYOR

JOHN KROTT S - 2258
Wisconsin Registered Land Surveyor
(original if signed in red)

3-820