SURVEYING ASSOCIATES, INC.
MEMBER WISCONSIN SOCIETY OF LAND SURVEYORS
AND AMERICAN CONGRESS ON SURVEYING AND MAPPING


2554 N. 100TH STREET
P.O. BOX 26596
WAUWATOSA, WISCONSIN 53226
(414) 257-2212 FAX : (414) 257-2443

WILLIAM J. KARPEN R L S
FREDERICK W. SHIBILSKI R L S

PLAT OF SURVEY

PARCEL 3 OF CERTIFIED SURVEY MAP NO. 3824, located in part of the Northwest ¼ of the Southwest ¼ of Section 19, Town 4 North, Range 18 East, in the Village of East Troy, Walworth County, Wisconsin.

Address: Emery Street

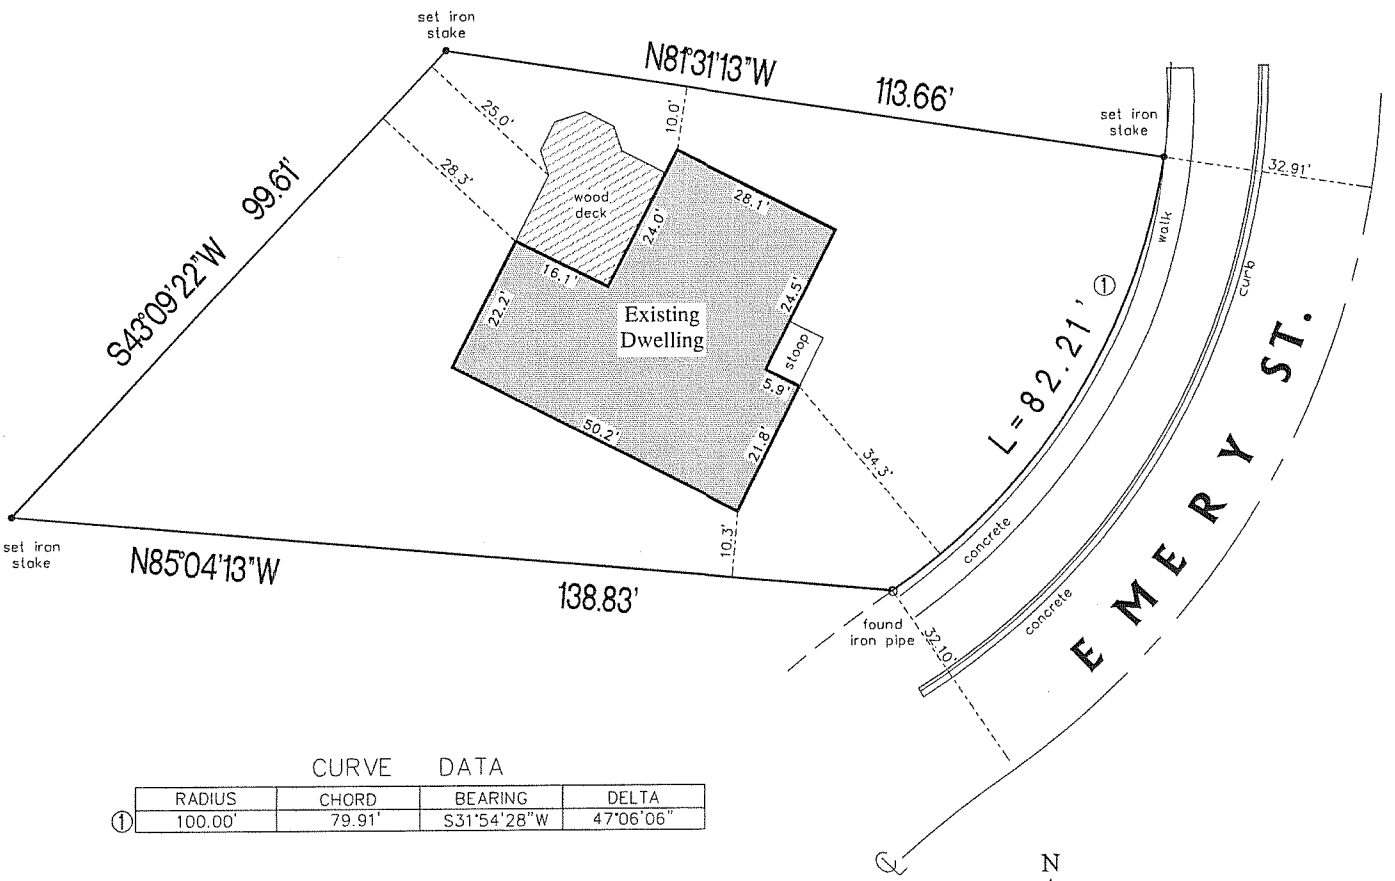

CURVE DATA

	RADIUS	CHORD	BEARING	DELTA
①	100.00'	79.91'	S31°54'28"W	47°06'06"

RECEIVED
DEC 15 2006
SMF

SCALE : 1" = 30'

Area of Property = 10,046.5 Sq. Ft.
0.23 Acres

Surveyed for: Tarantino and Company

"I have surveyed the above described property from the legal description furnished by the client named on this survey."

"This survey is made for the exclusive use of the present owners of the property, and also those who purchase, mortgage, or guarantee the title thereto within one (1) year from date hereof."

WISCONSIN FREDERICK W. SHIBILSKI S-1154 WAUWATOSA, WI LAND SURVEYOR

NOTE : THIS IS NOT AN ORIGINAL SURVEY UNLESS THIS SEAL IS RED.

WISCONSIN REGISTERED LAND SURVEYOR	June 9th, 2006	FWS	JTY	31612
	DATE	FIELD WORK BY	DRAWN BY	JOB NUMBER

RA3824-3

003-925