
PLAT OF SURVEY

OF

A PARCEL OF LAND LOCATED IN THE SOUTHWEST ¼ OF THE NORTHWEST ¼ OF SECTION 20, TOWNSHIP 4 NORTH, RANGE 18 EAST, VILLAGE OF EAST TROY, WALWORTH COUNTY, WIS.

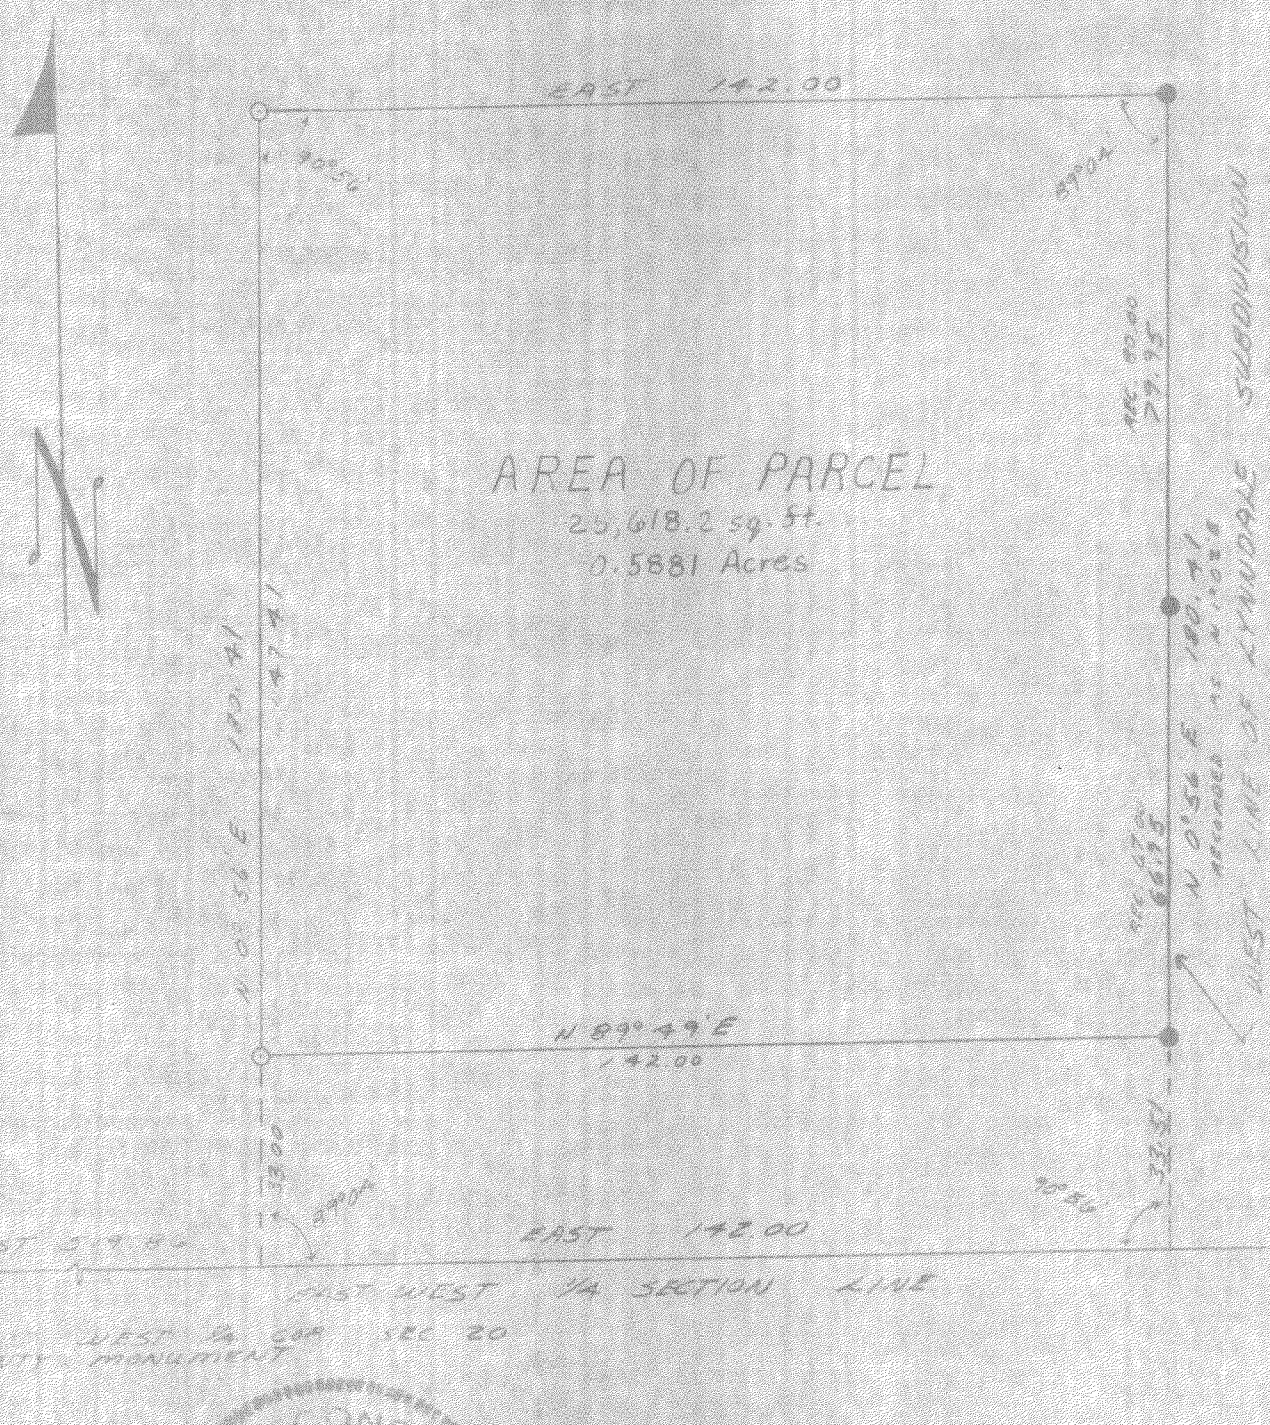

SURVEY AND PLAT BY

JENSEN & JOHNSON, INC.

CIVIL ENGINEERS AND SURVEYORS

Elkhorn, Wisconsin

WE CERTIFY: That we have surveyed the above described property and that the plat shown hereon is an accurate survey and a true representation thereof and correctly shows the exterior boundary lines and all divisions of said property.

Date ____

LLOYD L. JENSEN,

Wisconsin Registered Land Surveyor, No. S-211

UP-121A

3-92J