


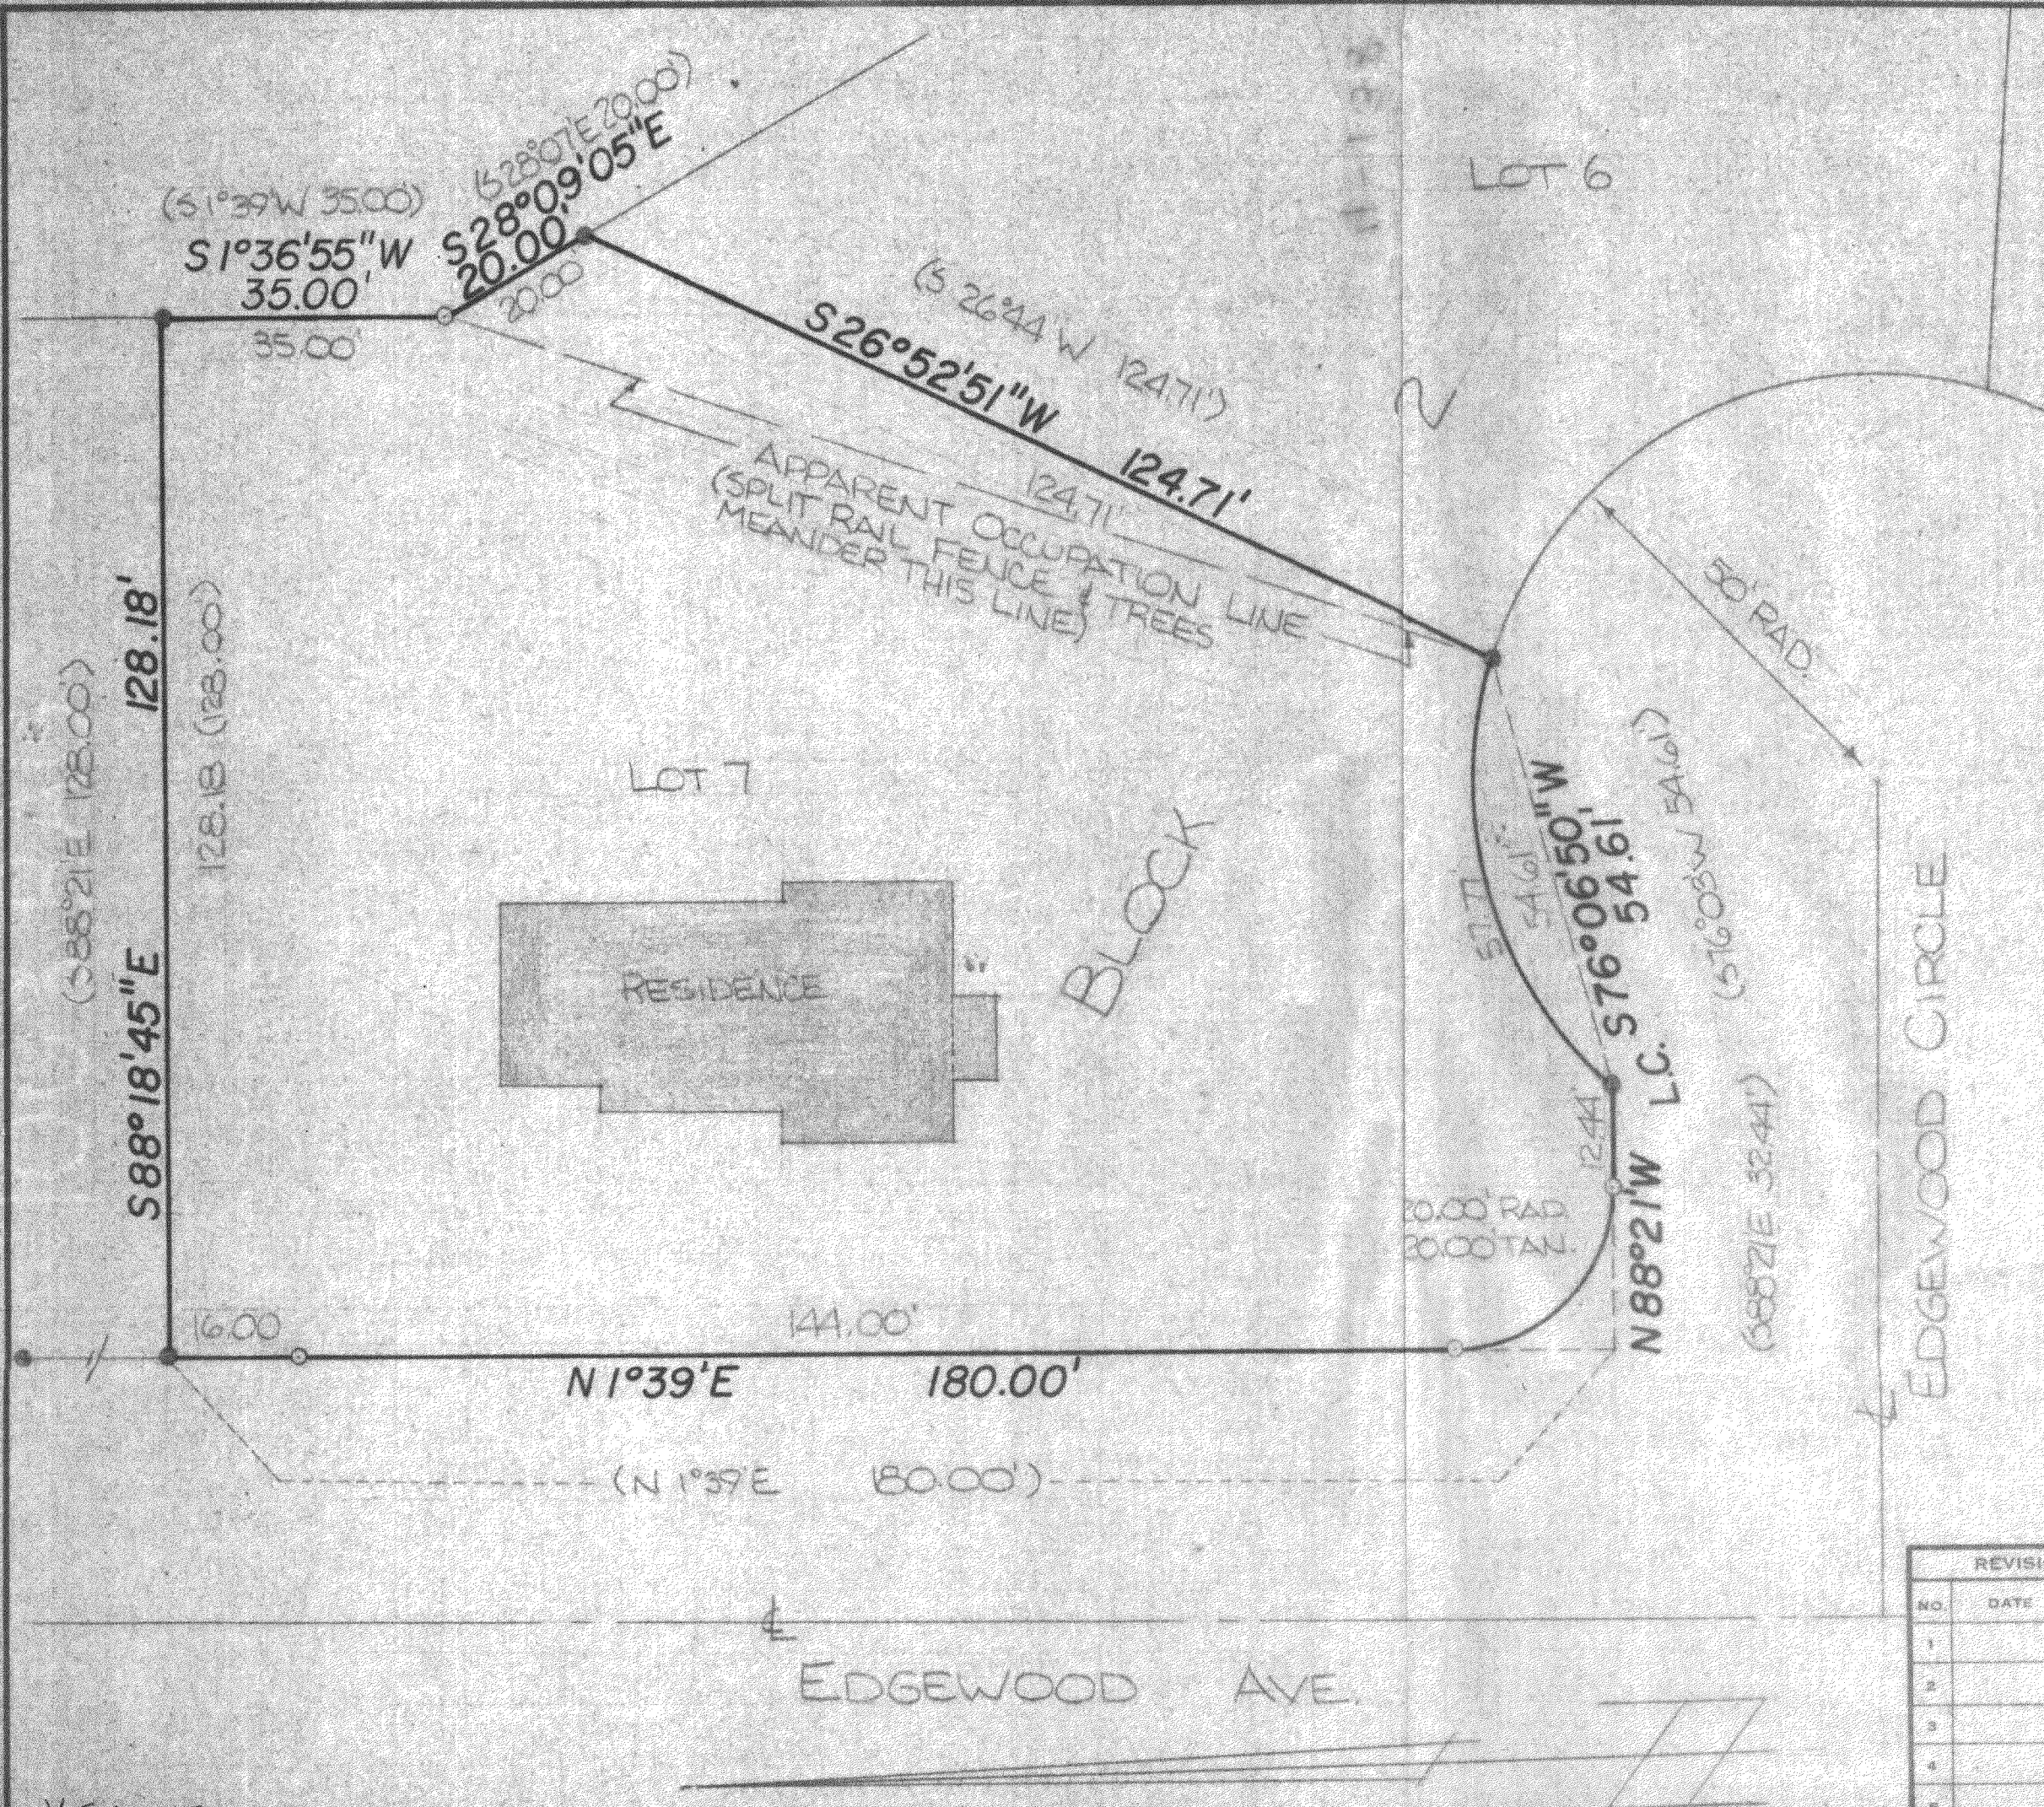


DESCRIPTION:
 LOT 7 OF BLOCK 2 OF
 EDGEWOOD 1ST ADDITION
 IN THE CITY OF ELKHORN,
 WALWORTH COUNTY, WIS-
 CONSIN.

CERTIFICATE:
 I, JOSEPH M. BIAGI, SUR-
 VEYOR, DO HEREBY CER-
 TIFY THAT I HAVE SUR-
 VEYED THE PROPERTY
 HEREON DESCRIBED

DATE:
 AUGUST 29, 1975

Joseph M. Biagi
 JOSEPH M. BIAGI

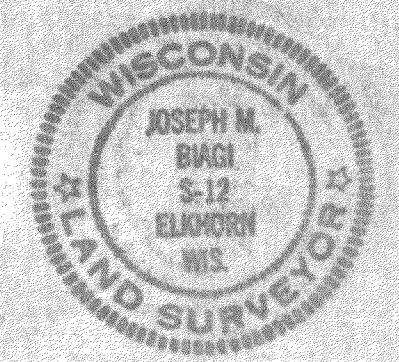

LEGEND
 • IRON PIPE FOUND
 ○ IRON PIPE SET
 () RECORDED AS

REVISIONS			LOT 7 BLK 2 EDGEWOOD 1 ST ADD		
NO.	DATE	BY			
1			FRANK GRONERT		
2			DRAWN BY	SCALE	MATERIAL
3			CHK'D	DATE	DRAWING NO.
4			TRACED	APP'D	
5					