Plat of Survey of Lot 7, Block 2 Edgewood 1st Addition
to the City of Elkhorn, Walworth County, Wisconsin.

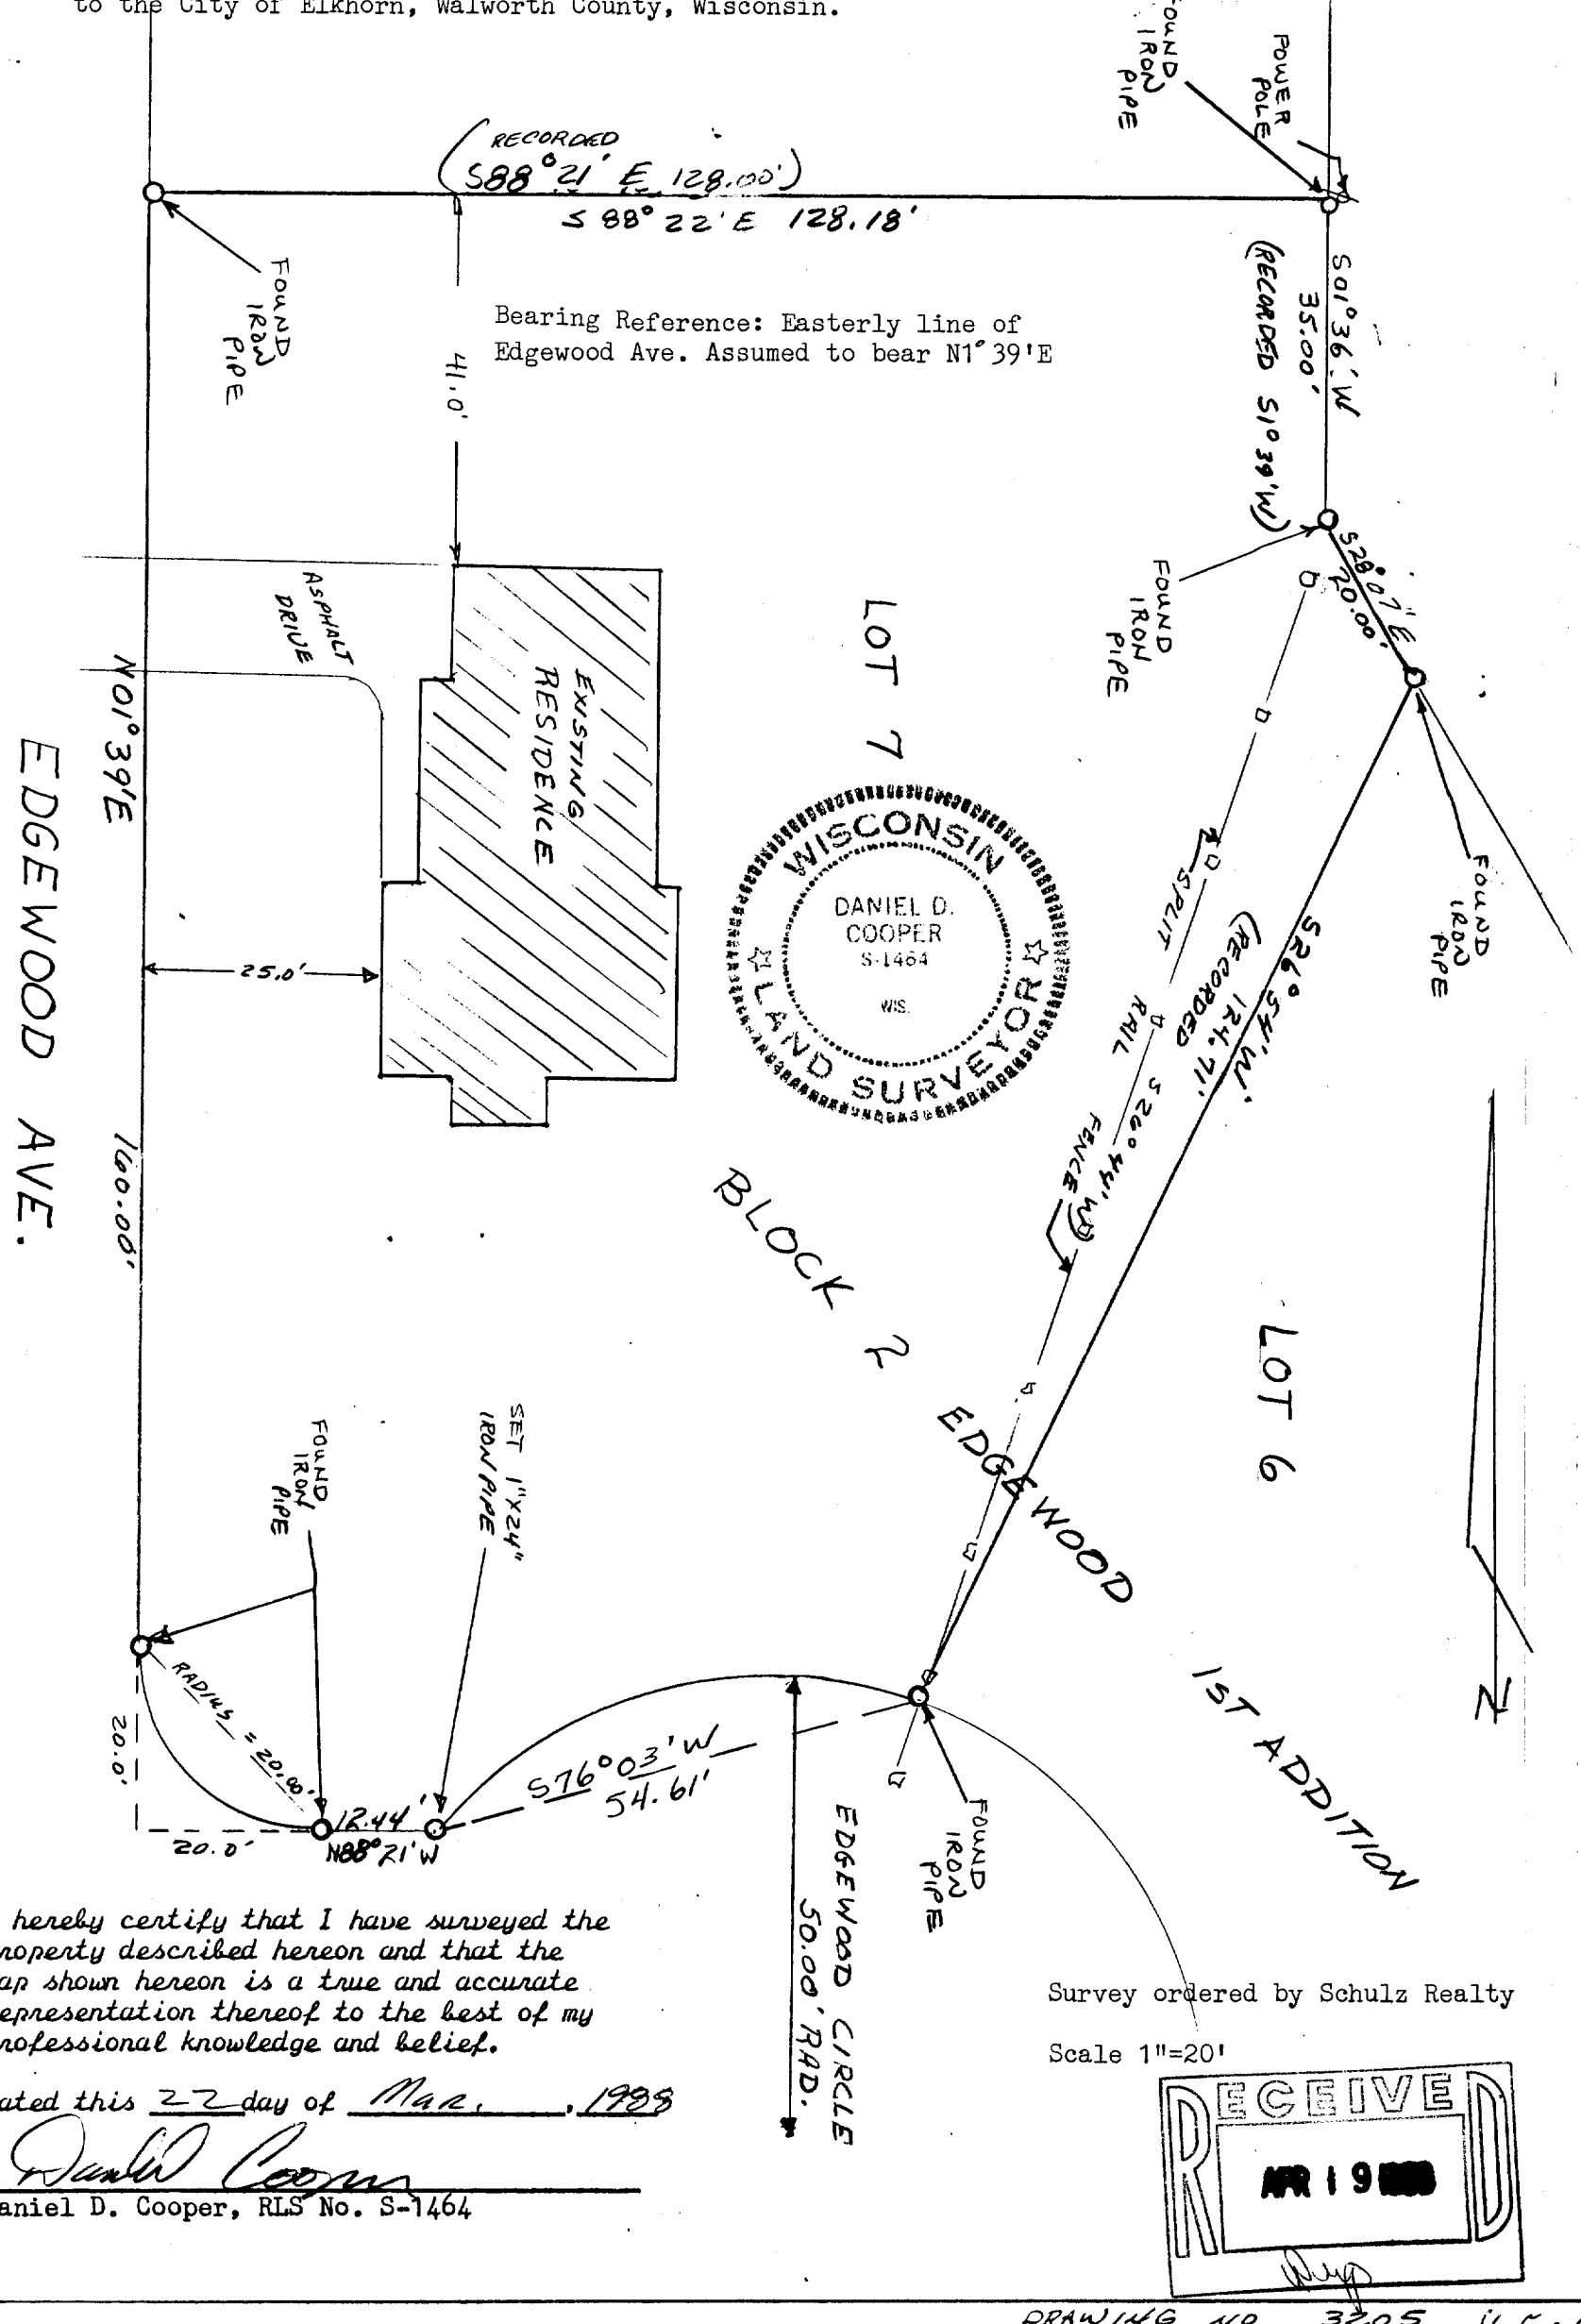

I hereby certify that I have surveyed the property described hereon and that the map shown hereon is a true and accurate representation thereof to the best of my professional knowledge and belief.

Dated this 22 day of Mar., 1988

Daniel D. Cooper

Daniel D. Cooper, RLS No. S-1464

Survey ordered by Schulz Realty

Scale 1"=20'

RECEIVED
APR 19 [redacted]

DRAWING NO. 3205 4-506