NORTH

● IRON STAKE

NORTH WISCONSIN ST

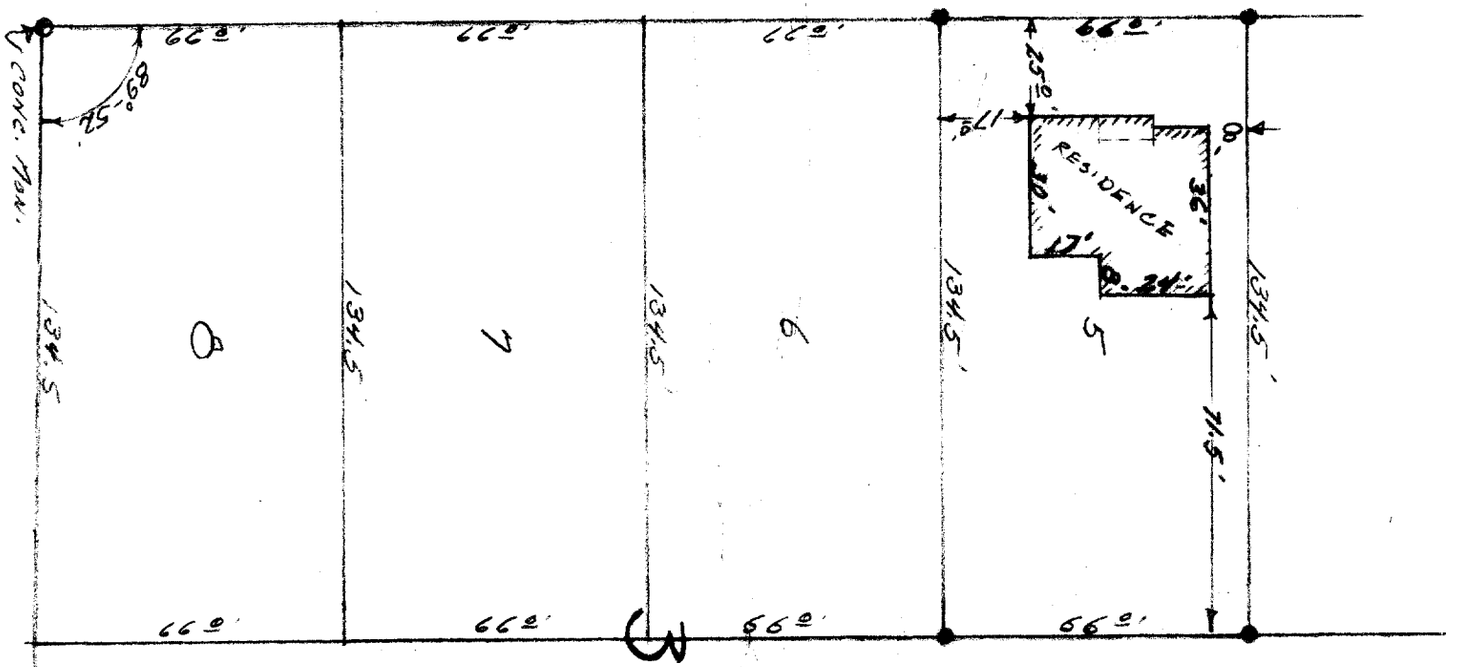

3RD AVENUE

DESCRIPTION: Lot 5, Block 3, of Holton Heights Subdivision of a portion of the City of Elkhorn, Walworth County, Wisconsin. Otherwise known as 609 North Wisconsin Street, Elkhorn, Wisconsin.

CERTIFICATE: I, James F. Biagi. Surveyor, do hereby certify that I have surveyed the property hereon described, and that the location of the improvements on said property are as shown.

SIGNED AND SEALED ON THIS THE 9TH DAY OF JUNE 1960.

James F. Biagi

James F. Biagi. RLS (272)
Elkhorn Wisconsin.

WISCONSIN
JAMES F.
BIAGI
MILWAUKEE,
WIS.
REGISTERED LAND SURVEYOR

YHT-35D

4-103B

4-103B