
49-1

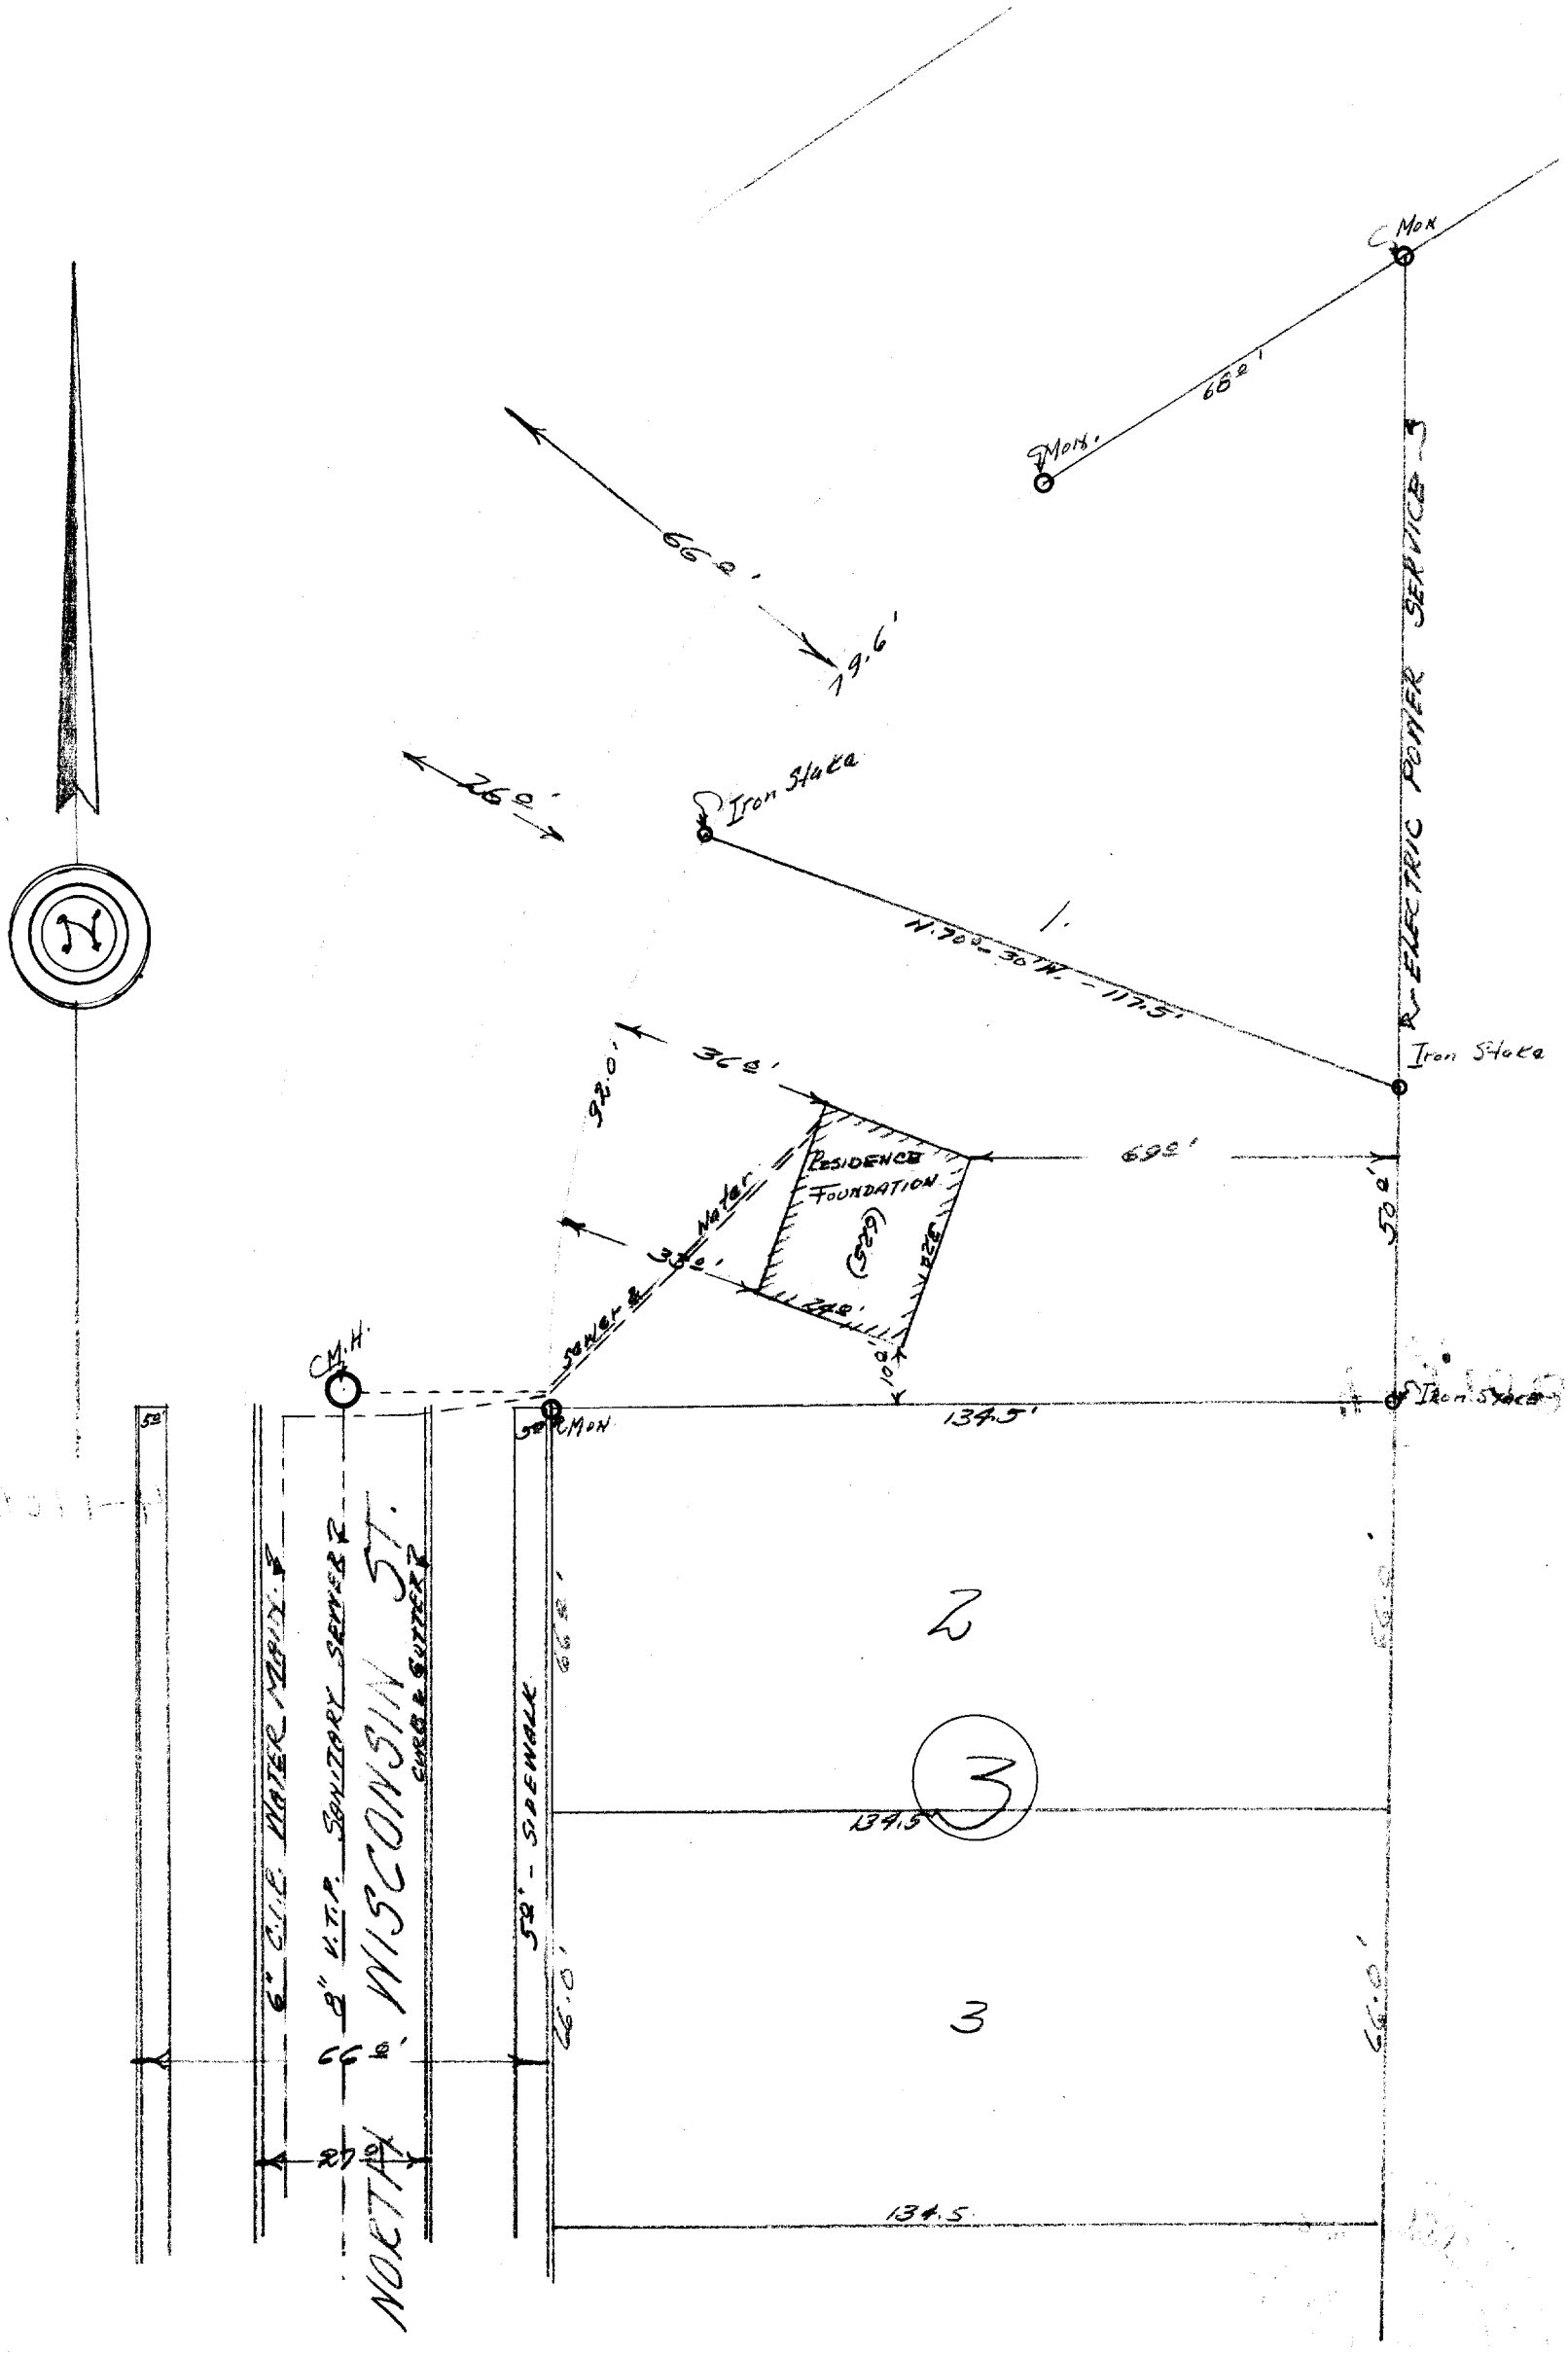

PLOT PLAN
OF

625 NORTH WISCONSIN STREET
ELKHORN WISCONSIN.

DESCRIPTION: Commencing at the southeast corner of Lotl, Block 3, Holton Heights Addition to the City of Elkhorn Wisconsin, thence North along the east line of said lot 1, 50 feet to a point, thence N. 70 30' W., 117.5 feet to a point in the easterly line of North Wisconsin Street, thence south westerly along the easterly line of said street 92 feet to the southwest corner of said lot 1, thence East along the south line of said lot 1, 134.5 feet to the place of beginning.

CERTIFICATE: I, Joseph M. Biagi, do hereby certify that I have made the above survey according to official records; that the survey of the lot and information relative to the building located on said lot, all as shown on the above survey, is true and correct as indicated and marked on the above map.

Dated, June 1, 1949.

Joseph M. Biagi. Professional Engineer
Elkhorn Wisconsin.

HT-35 RVD

4-110 B