
59-33

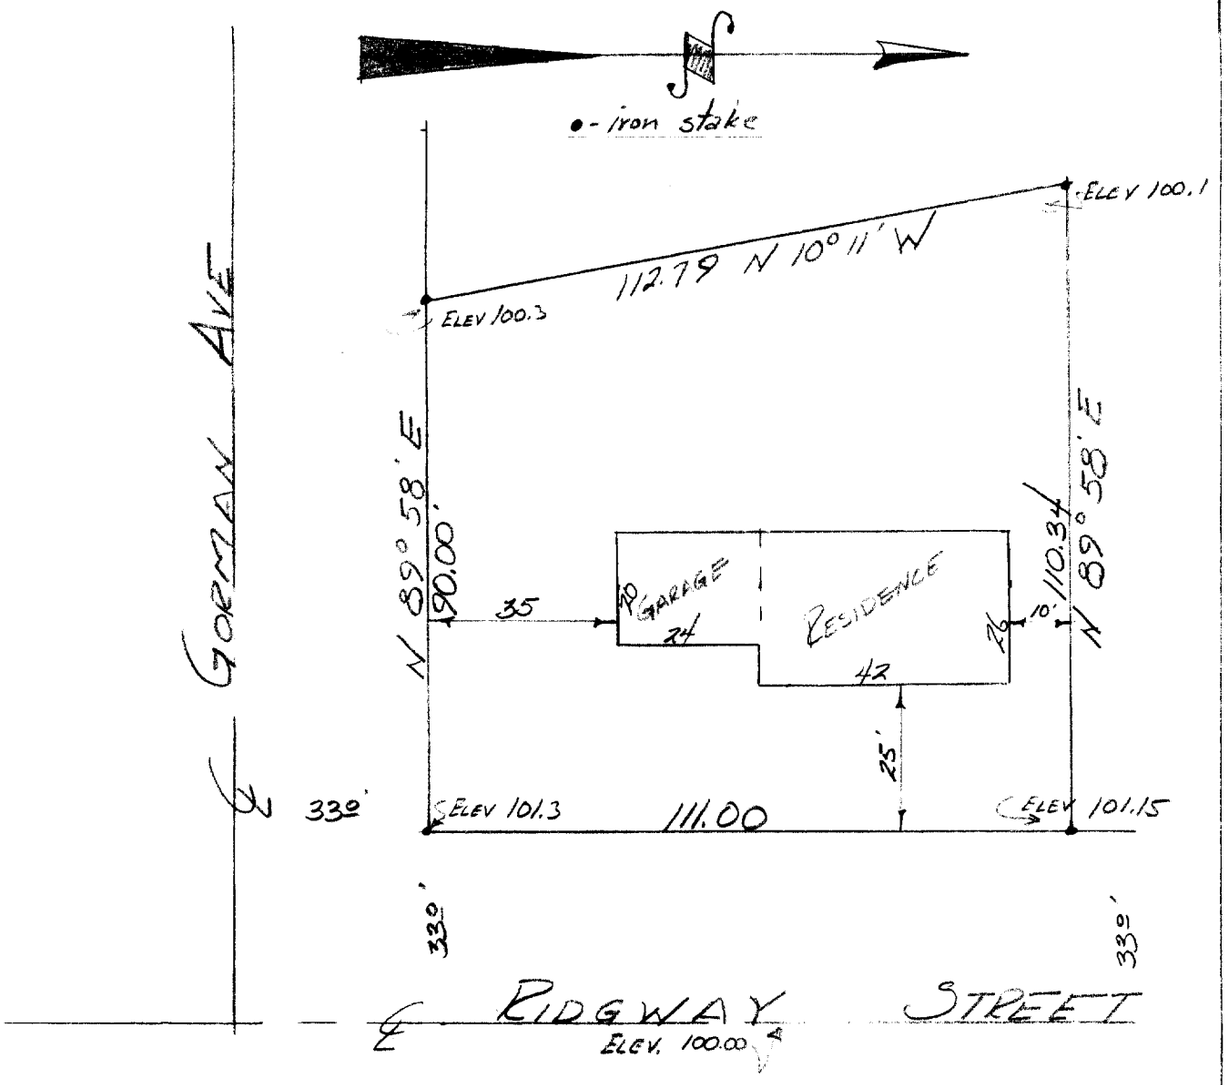

DESCRIPTION: Lot 18 of the Landmark Subdivision in the City of Elkhorn, Walworth County, Wisconsin.

CERTIFICATE: I, James F. Biagi, do hereby certify that I have surveyed the property hereon described, and that the location of the improvements are as shown on the above drawing.

SIGNED AND SEALED THIS 7TH DAY OF OCTOBER 1959.

James F. Biagi
Reg Land Surveyor (272)

WISCONSIN
JAMES F.
BIAGI
MILWAUKEE,
WIS.
LAND SURVEYOR

YL5-18

4-112B