
59-21

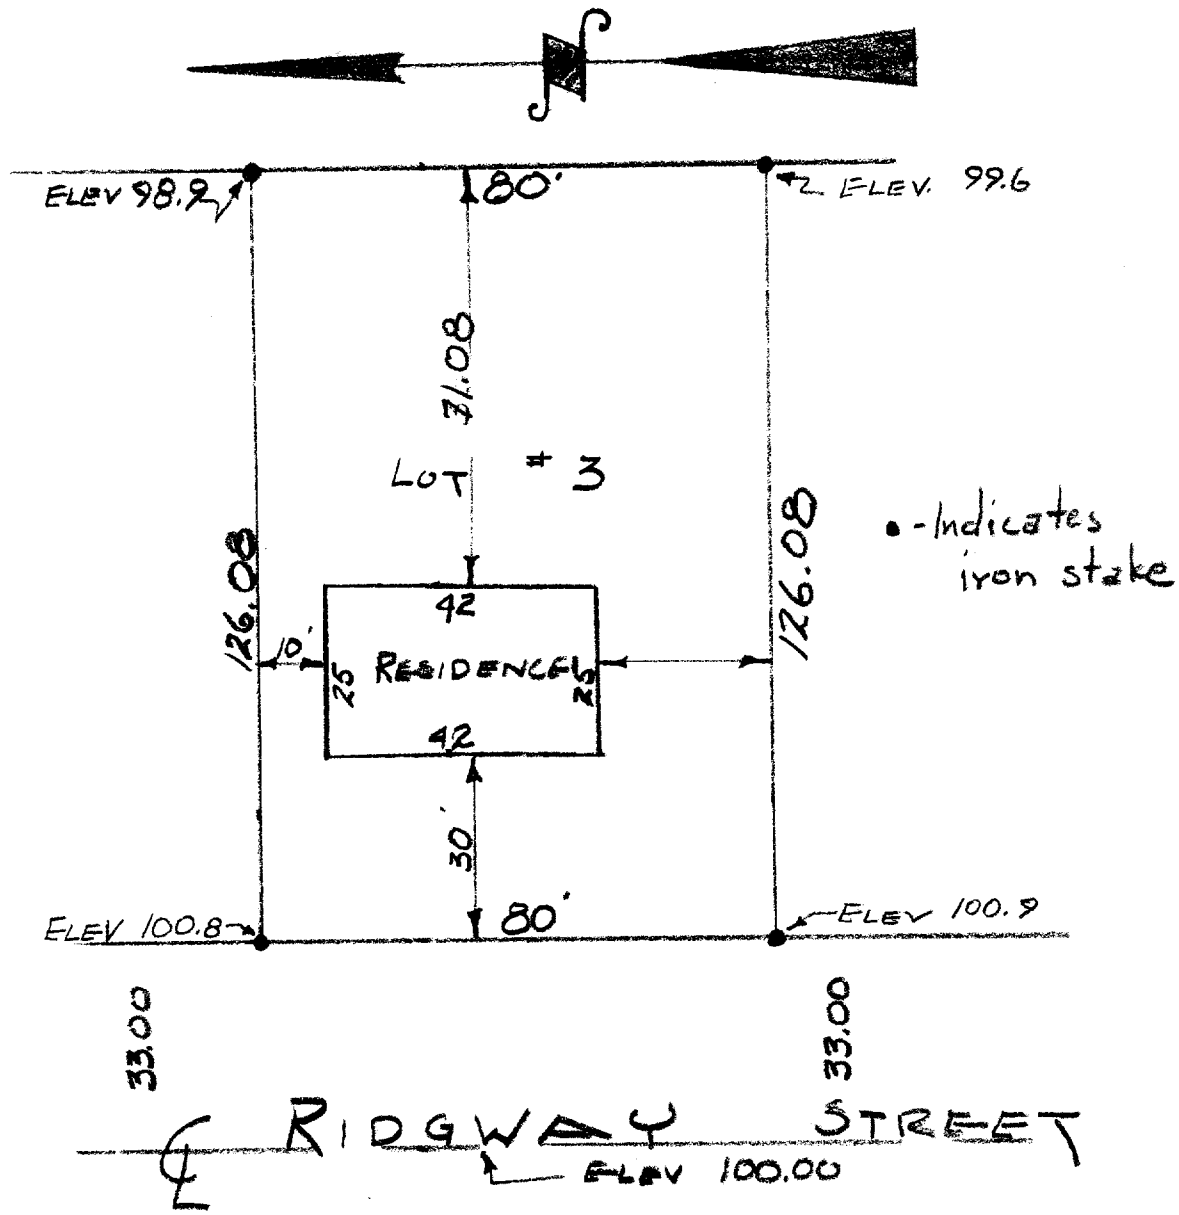

Description: Lot 3 of the Landmark Subdivision in the City of Elkhorn, Walworth County, Wisconsin.

Certificate: I, James F. Biagi, Surveyor, do hereby certify that I have surveyed the property hereon described, and the location of all improvements are as shown.

Signed & Sealed 21 Dec. 1959.

James F. Biagi-RLS (272)

YL5-3

4-113B