
PLAT OF SURVEY

ORDERED BY: GARY ADAY
P.O BOX 495
ELKHORN, WI 53121

DESCRIPTION: LOT 3 CERTIFIED SURVEY MAP 623
A C.S.M. LOCATED IN THE NORTH
EAST 1/4 OF SECTION 1 T2N, R16E
CITY OF ELKHORN, WALWORTH COUNTY
WISCONSIN.

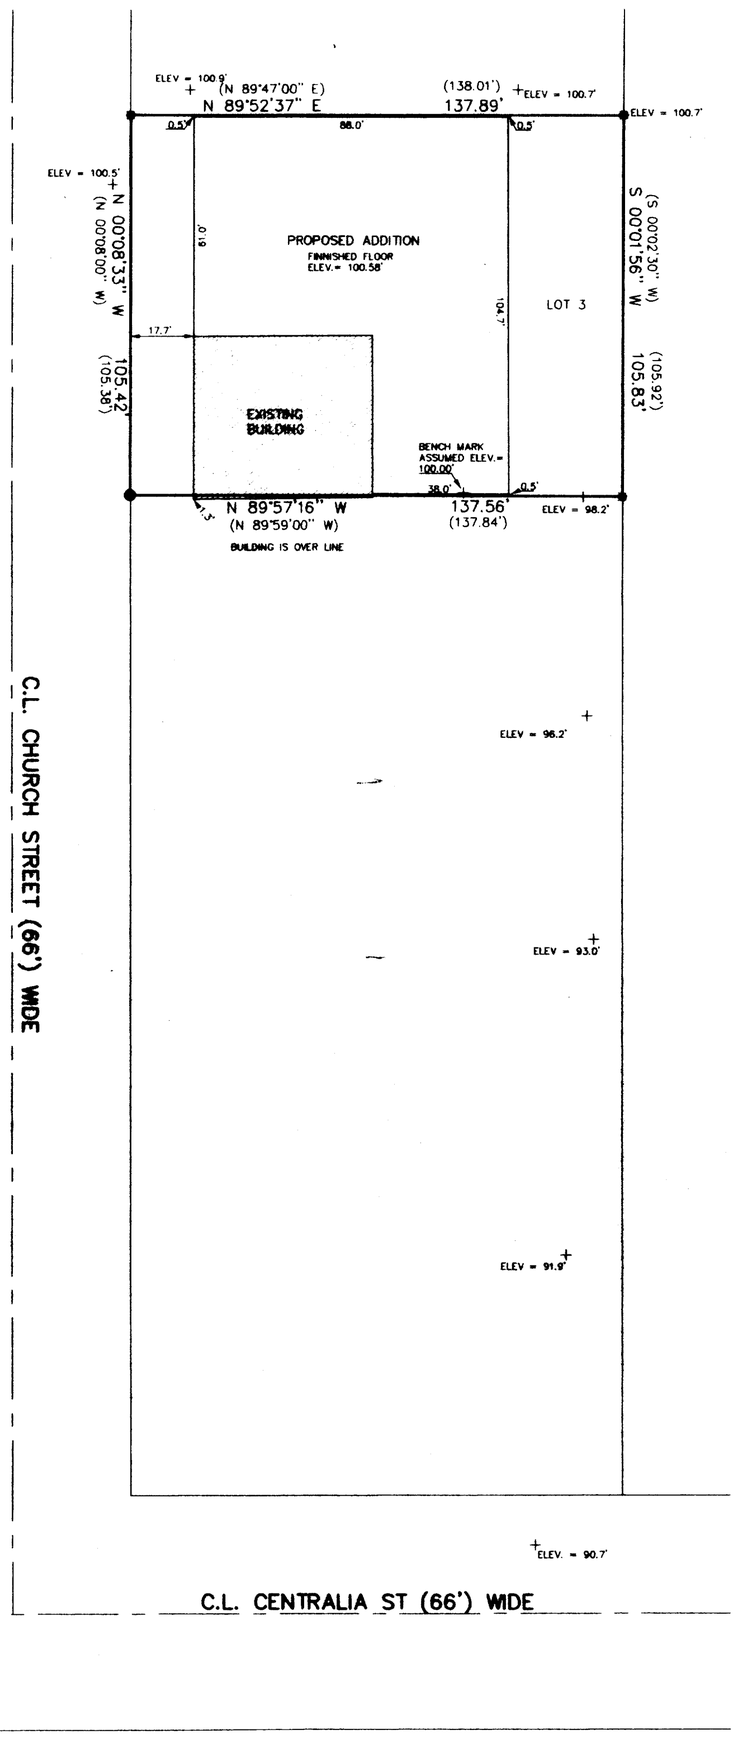

SCALE 1"=30'
BEARINGS REFERENCED TO C.S.M. 623

LEGEND
- ■ FOUND IRON PIN
- ● FOUND RAILROAD SPIKE
- (XXX) RECORDED AS
- \+ SPOT ELEVATION

THE ABOVE MAP IS A TRUE REPRESENTATION THEREOF AND SHOWS THE SIZE AND LOCATION OF ALL THE PROPERTY, EXTERIOR BOUNDARIES, THE LOCATION OF ALL VISIBLE BOUNDARY FENCES , APPARENT EASEMENTS , ROADWAYS AND VISIBLE ENCROACHMENTS , IF ANY.

THIS SURVEY IS MADE FOR THE USE OF THE PRESENT OWNERS OF THE PROPERTY , AND ALSO THOSE WHO PURCHASE , MORTGAGE OR GURANTEE TITLE THERETO WITHIN ONE (1) YEAR FROM DATE HERETO.

John P. Krott
JOHN P. KROTT , R.L.S. 2258

RECEIVED
JUN 24 1999

WISCONSIN
JOHN P. KROTT
S-2258
MUKWONAGO, WIS.
LAND SURVEYOR

DATE: 5-12-1999

PATHFINDER SURVEYING
FORMERLY KOLB LAND CONSULTING
929 WILLIAMS STREET LAKE GENEVA, WI. 53147
(414) 248-3697

NOTE: THIS IS NOT A CERTIFIED COPY UNLESS SEAL IS IN RED.

JOB NUMBER 99092 ELK YA 623 00003

004-1174 YA-623-3