
61-53

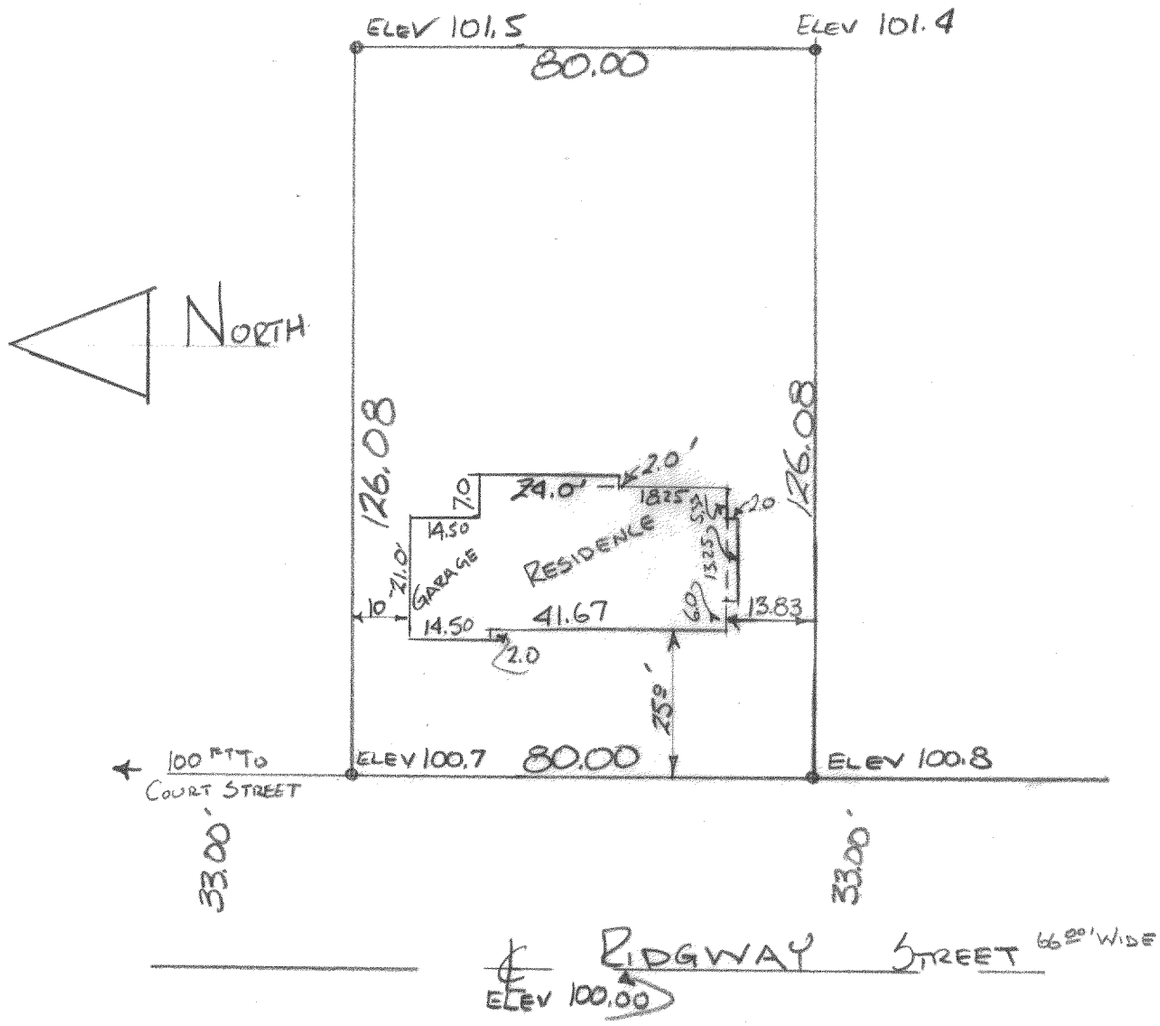

DESCRIPTION:

Lot 9, Landmark Subdivision of a portion of the City of Elkhorn, Walworth County, Wisconsin.

CERTIFICATE:

I, James F. Biagi, Surveyor, do hereby certify that I have surveyed the property hereon described, and that the location of the improvements are as shown on the above drawing.

SIGNED AND SEALED ON THIS THE 14TH DAY OF APRIL 1961.

James F. Biagi, RLS (272)

YLS-9

4-1198