
PLAT OF SURVEY

OF "WALWORTH COUNTY COURT HOUSE SQUARE", A PART OF THE "ORIGINAL PLAT" LOCATED IN THE CITY OF ELKHORN, COUNTY OF WALWORTH, STATE OF WISCONSIN


ORDERED BY: COUNTY OF WALWORTH

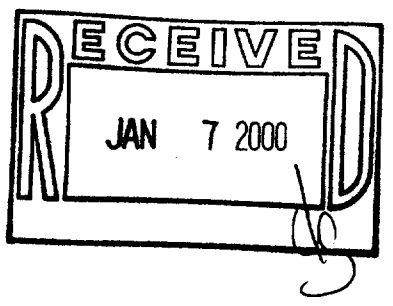

I, JEFFREY A. NIPPLE, DO HEREBY CERTIFY THAT I HAVE SURVEYED THE PROPERTY HEREON DESCRIBED ACCORDING TO THE OFFICIAL RECORDS, AND THAT THE PLAT HEREON IS A CORRECT REPRESENTATION OF THE PROPERTY LINES TO THE BEST OF MY KNOWLEDGE AND BELIEF.

N

1" = 100'

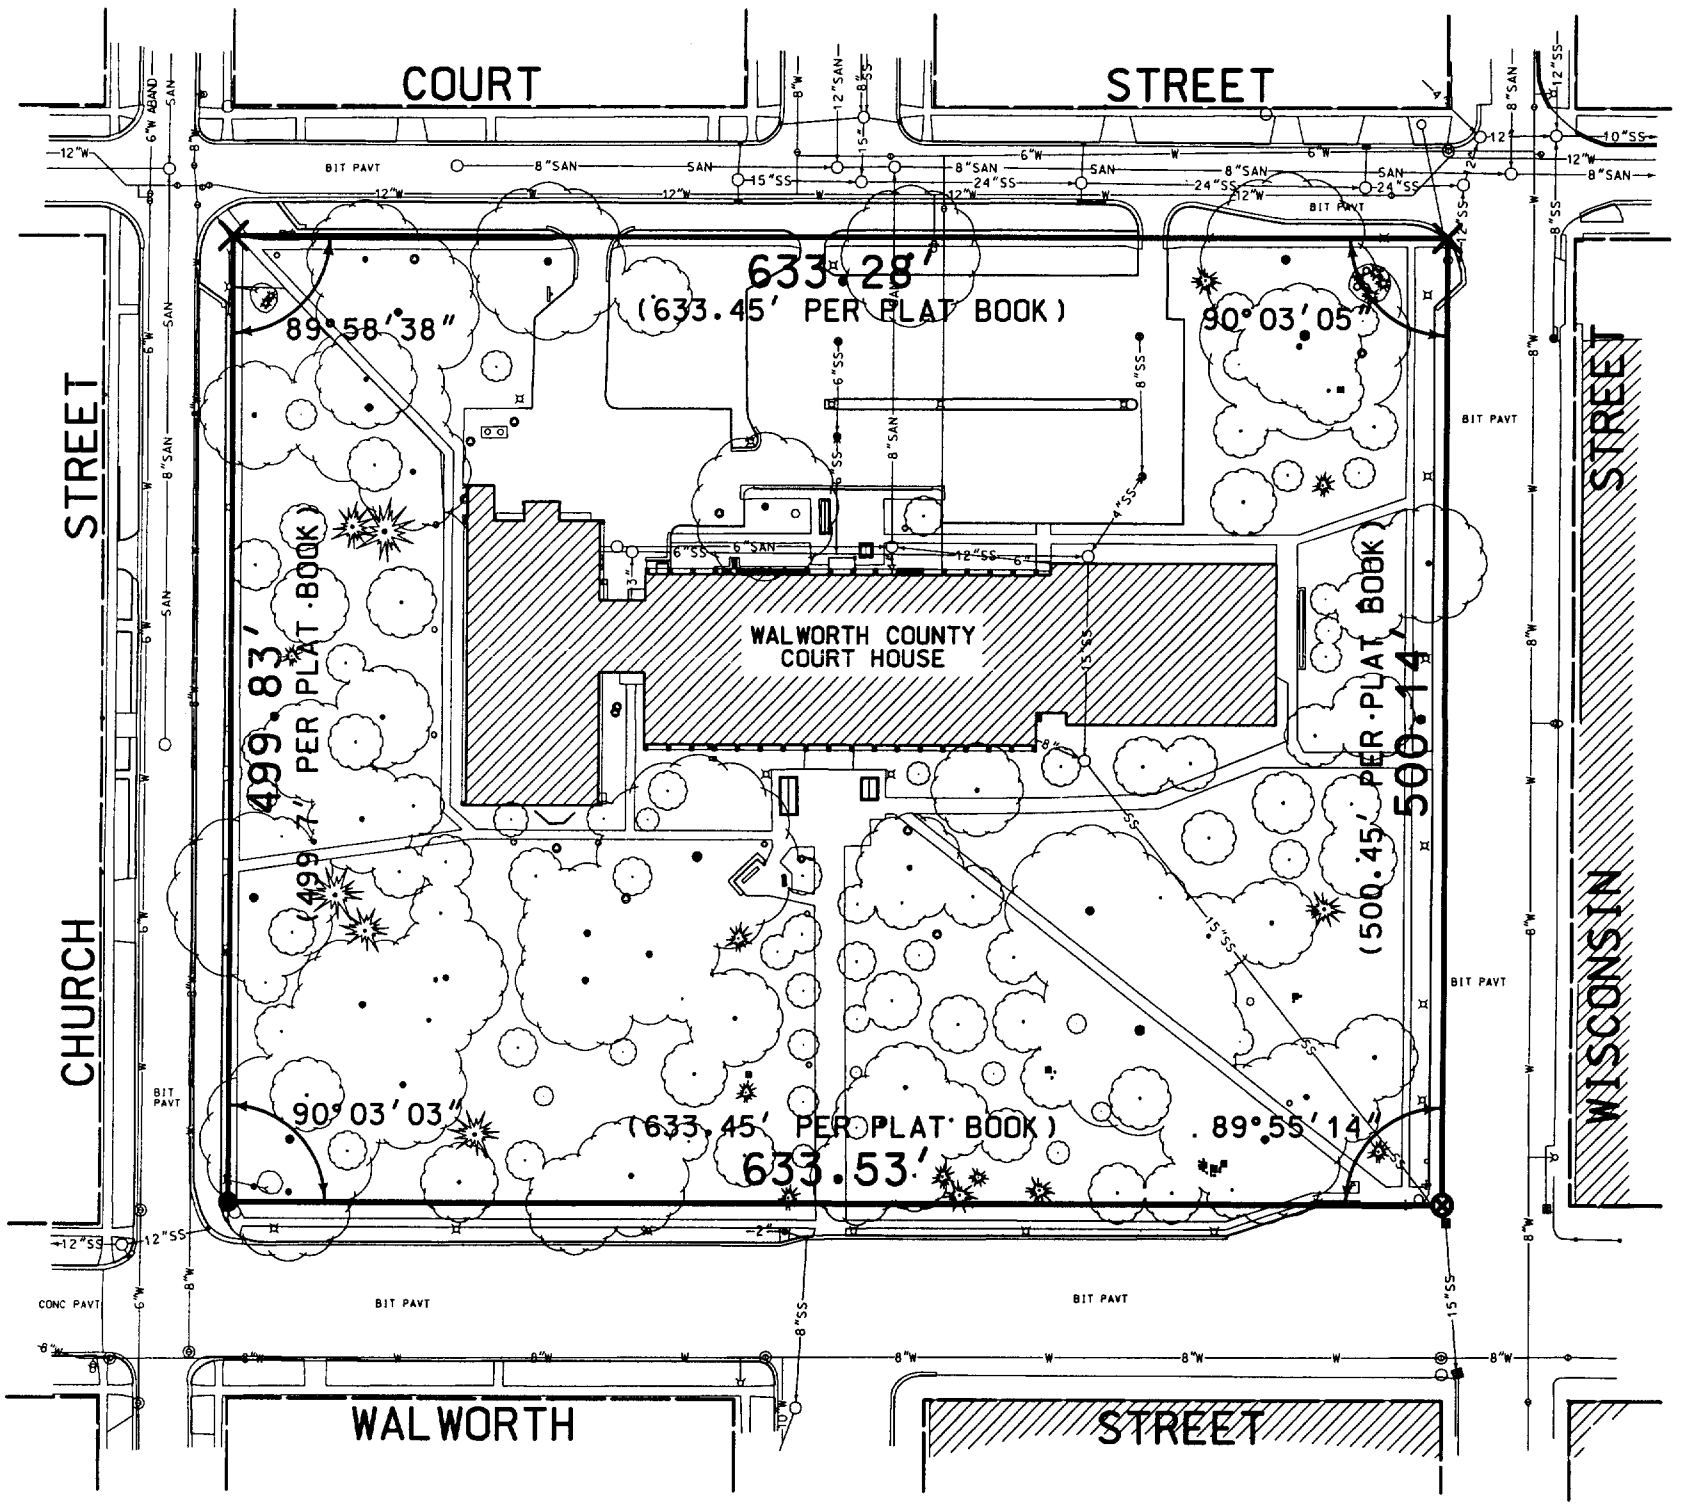

Jeffrey A. Nipple

JEFFREY A. NIPPLE
WISCONSIN REGISTERED LAND SURVEYOR, S-1929
CRISPELL - SNYDER, INC.
ELKHORN, WISCONSIN

1/5/00
DATE

WISCONSIN
JEFFREY A. NIPPLE S-1929 ELKHORN, WI
LAND SURVEYOR

LEGEND

- ⊗ SET PK NAIL
- × CHISELED "X"
- ● SET A 3/4" X 24" IRON ROD WEIGHING 1.50 lbs/LIN. FT.
- ( ) RECORDED AS

NOP-140A

004-1217