
#132-65

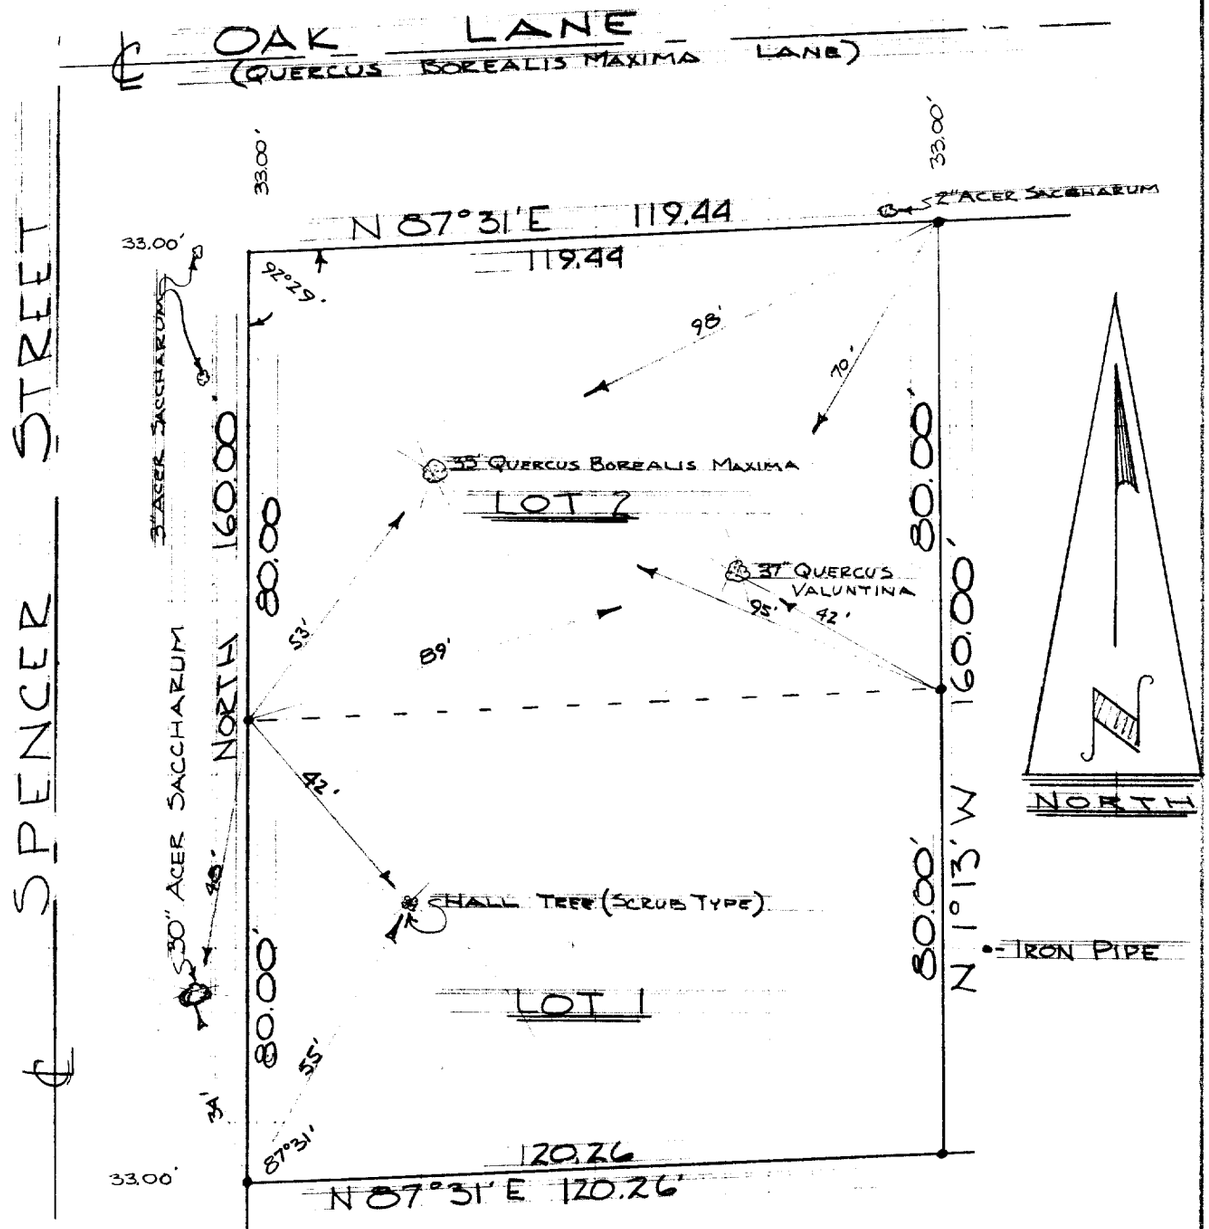

DESCRIPTION: Lots 2 and 1 of Oakland Subdivision in the City of Elkhorn, Walworth County, Wisconsin.

CERTIFICATE: I, James F. Biagi, surveyor, do hereby certify that I have surveyde the property hereon described and that the location of the trees are as shown.

April 14, 1965.

WISCONSIN
JAMES F.
[illegible]
MILWAUKEE, WIS.
LAND SURVEYOR

James F. Biagi RLS 272

Yo-1, 2

4-122B