
46-20

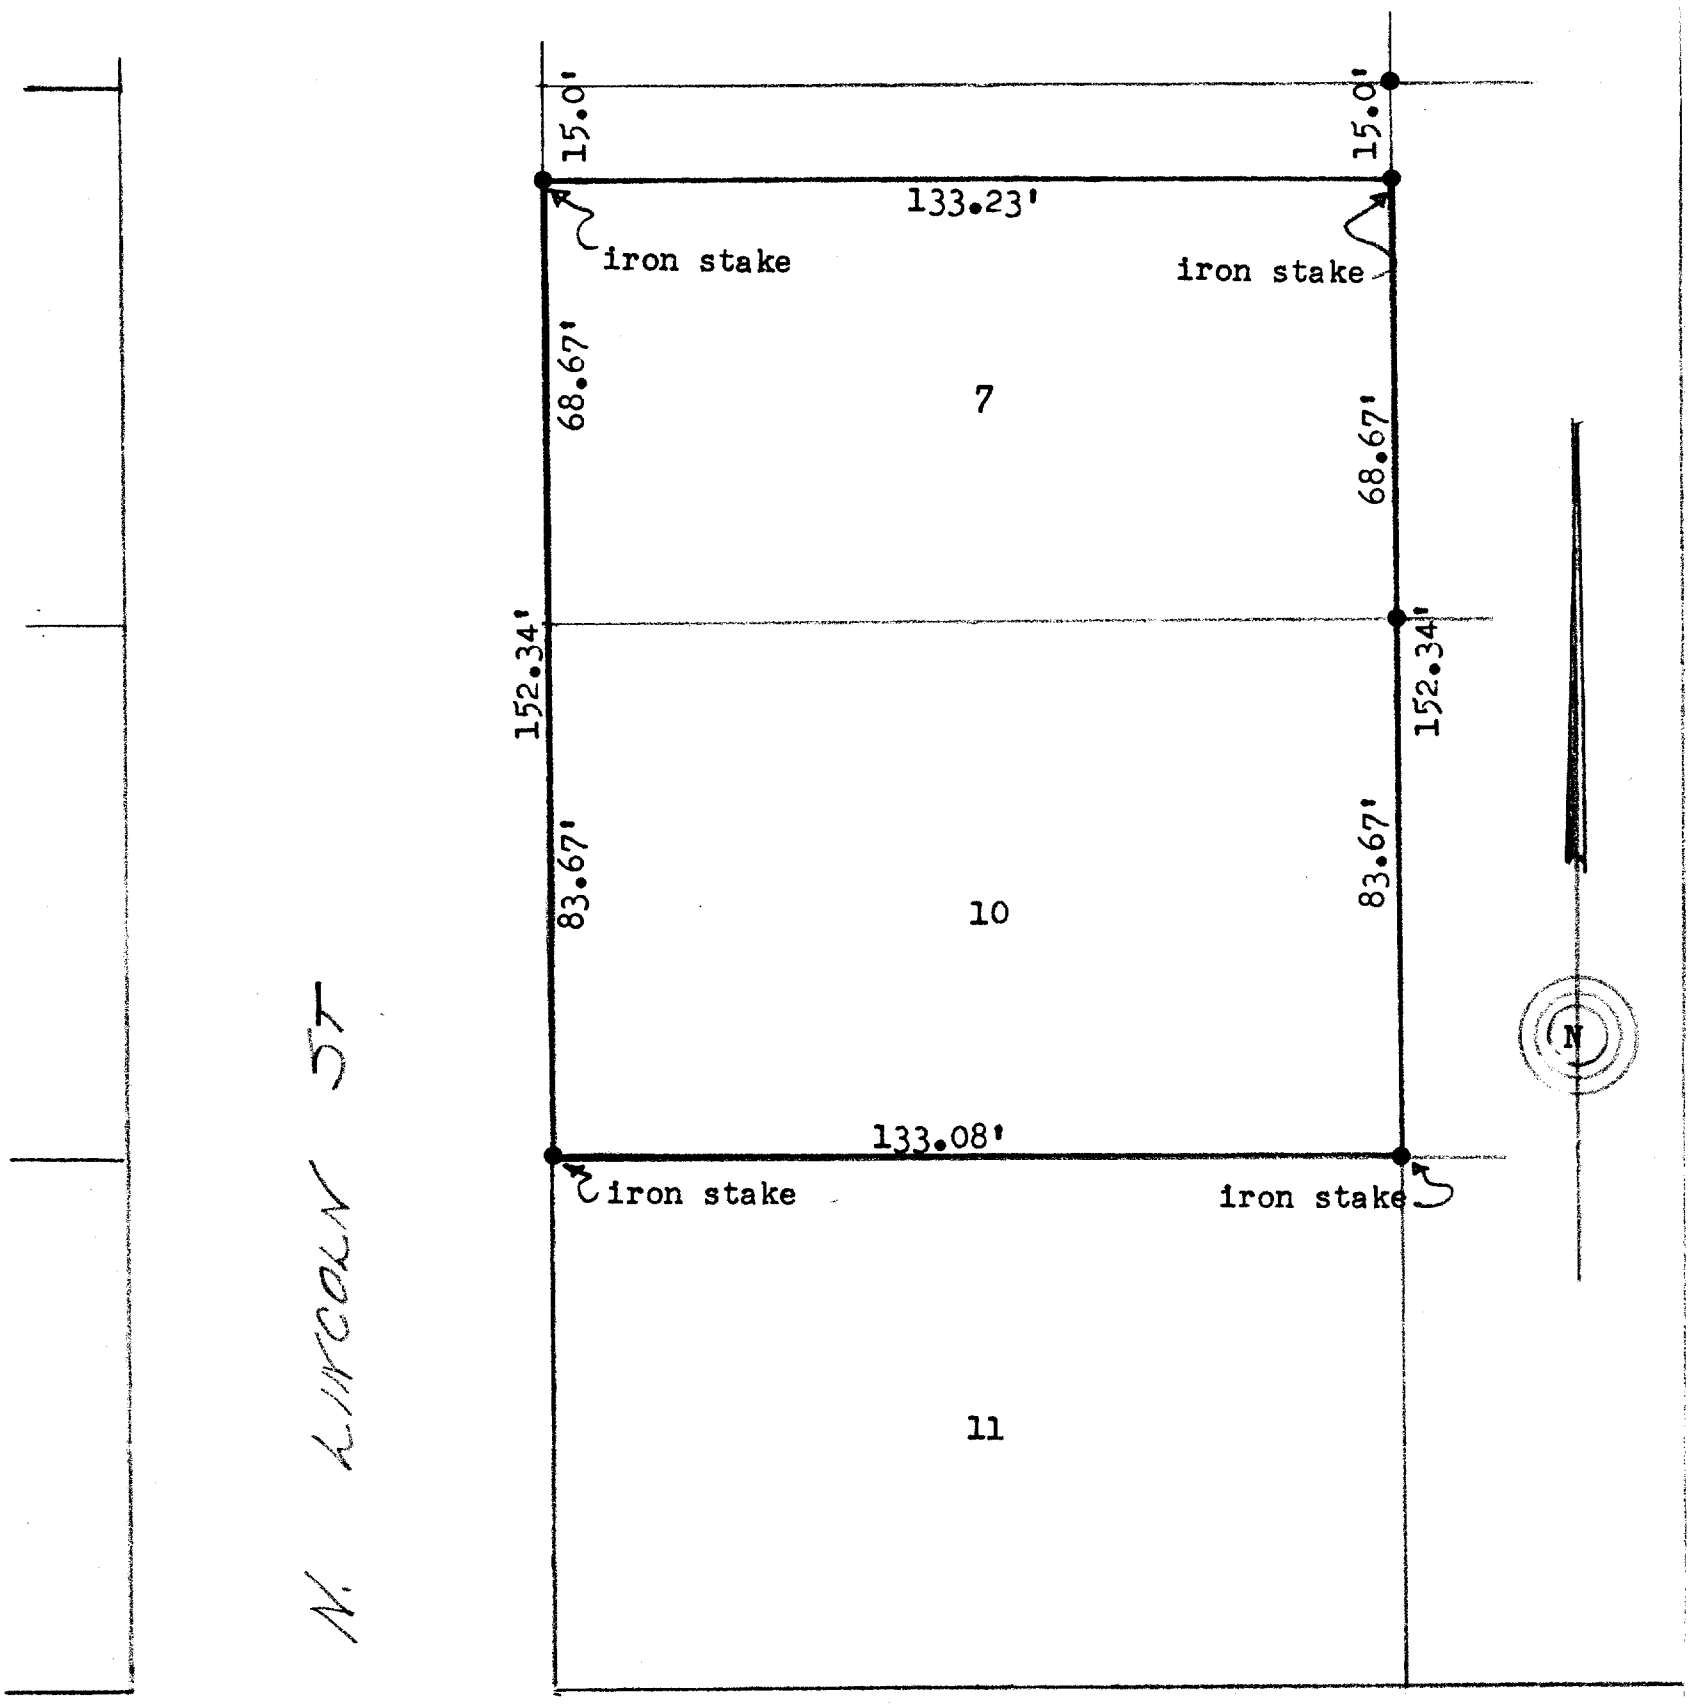

DESCRIPTION: Lot 10 and the south 68.67 feet of Lot 7 of Block 12 Original Plat of the City of Elkhorn Walworth County, Wisconsin.

CERTIFICATE: I, hereby certify that I have on this the 10th day of August 1946, surveyed the above described property.
SIGNED AND SEALED THIS 12TH DAY OF AUGUST 1946.

Joseph M. Biagi.
Professional Engineer.
Elkhorn Wisconsin.

RW- 7
" 7A

4-125