
# Plat of Survey

of

## Lot 43 of Jackson Creek East Subdivision,

located in the Southwest 1/4 of Section 7, Town 2 North, Range 17 East, City of Elkhorn, Walworth County, Wisconsin.

Surveyed for: **Lazzaroni Builders, Inc.**
N4236 County Road NN
Elkhorn, Wisconsin. 53121

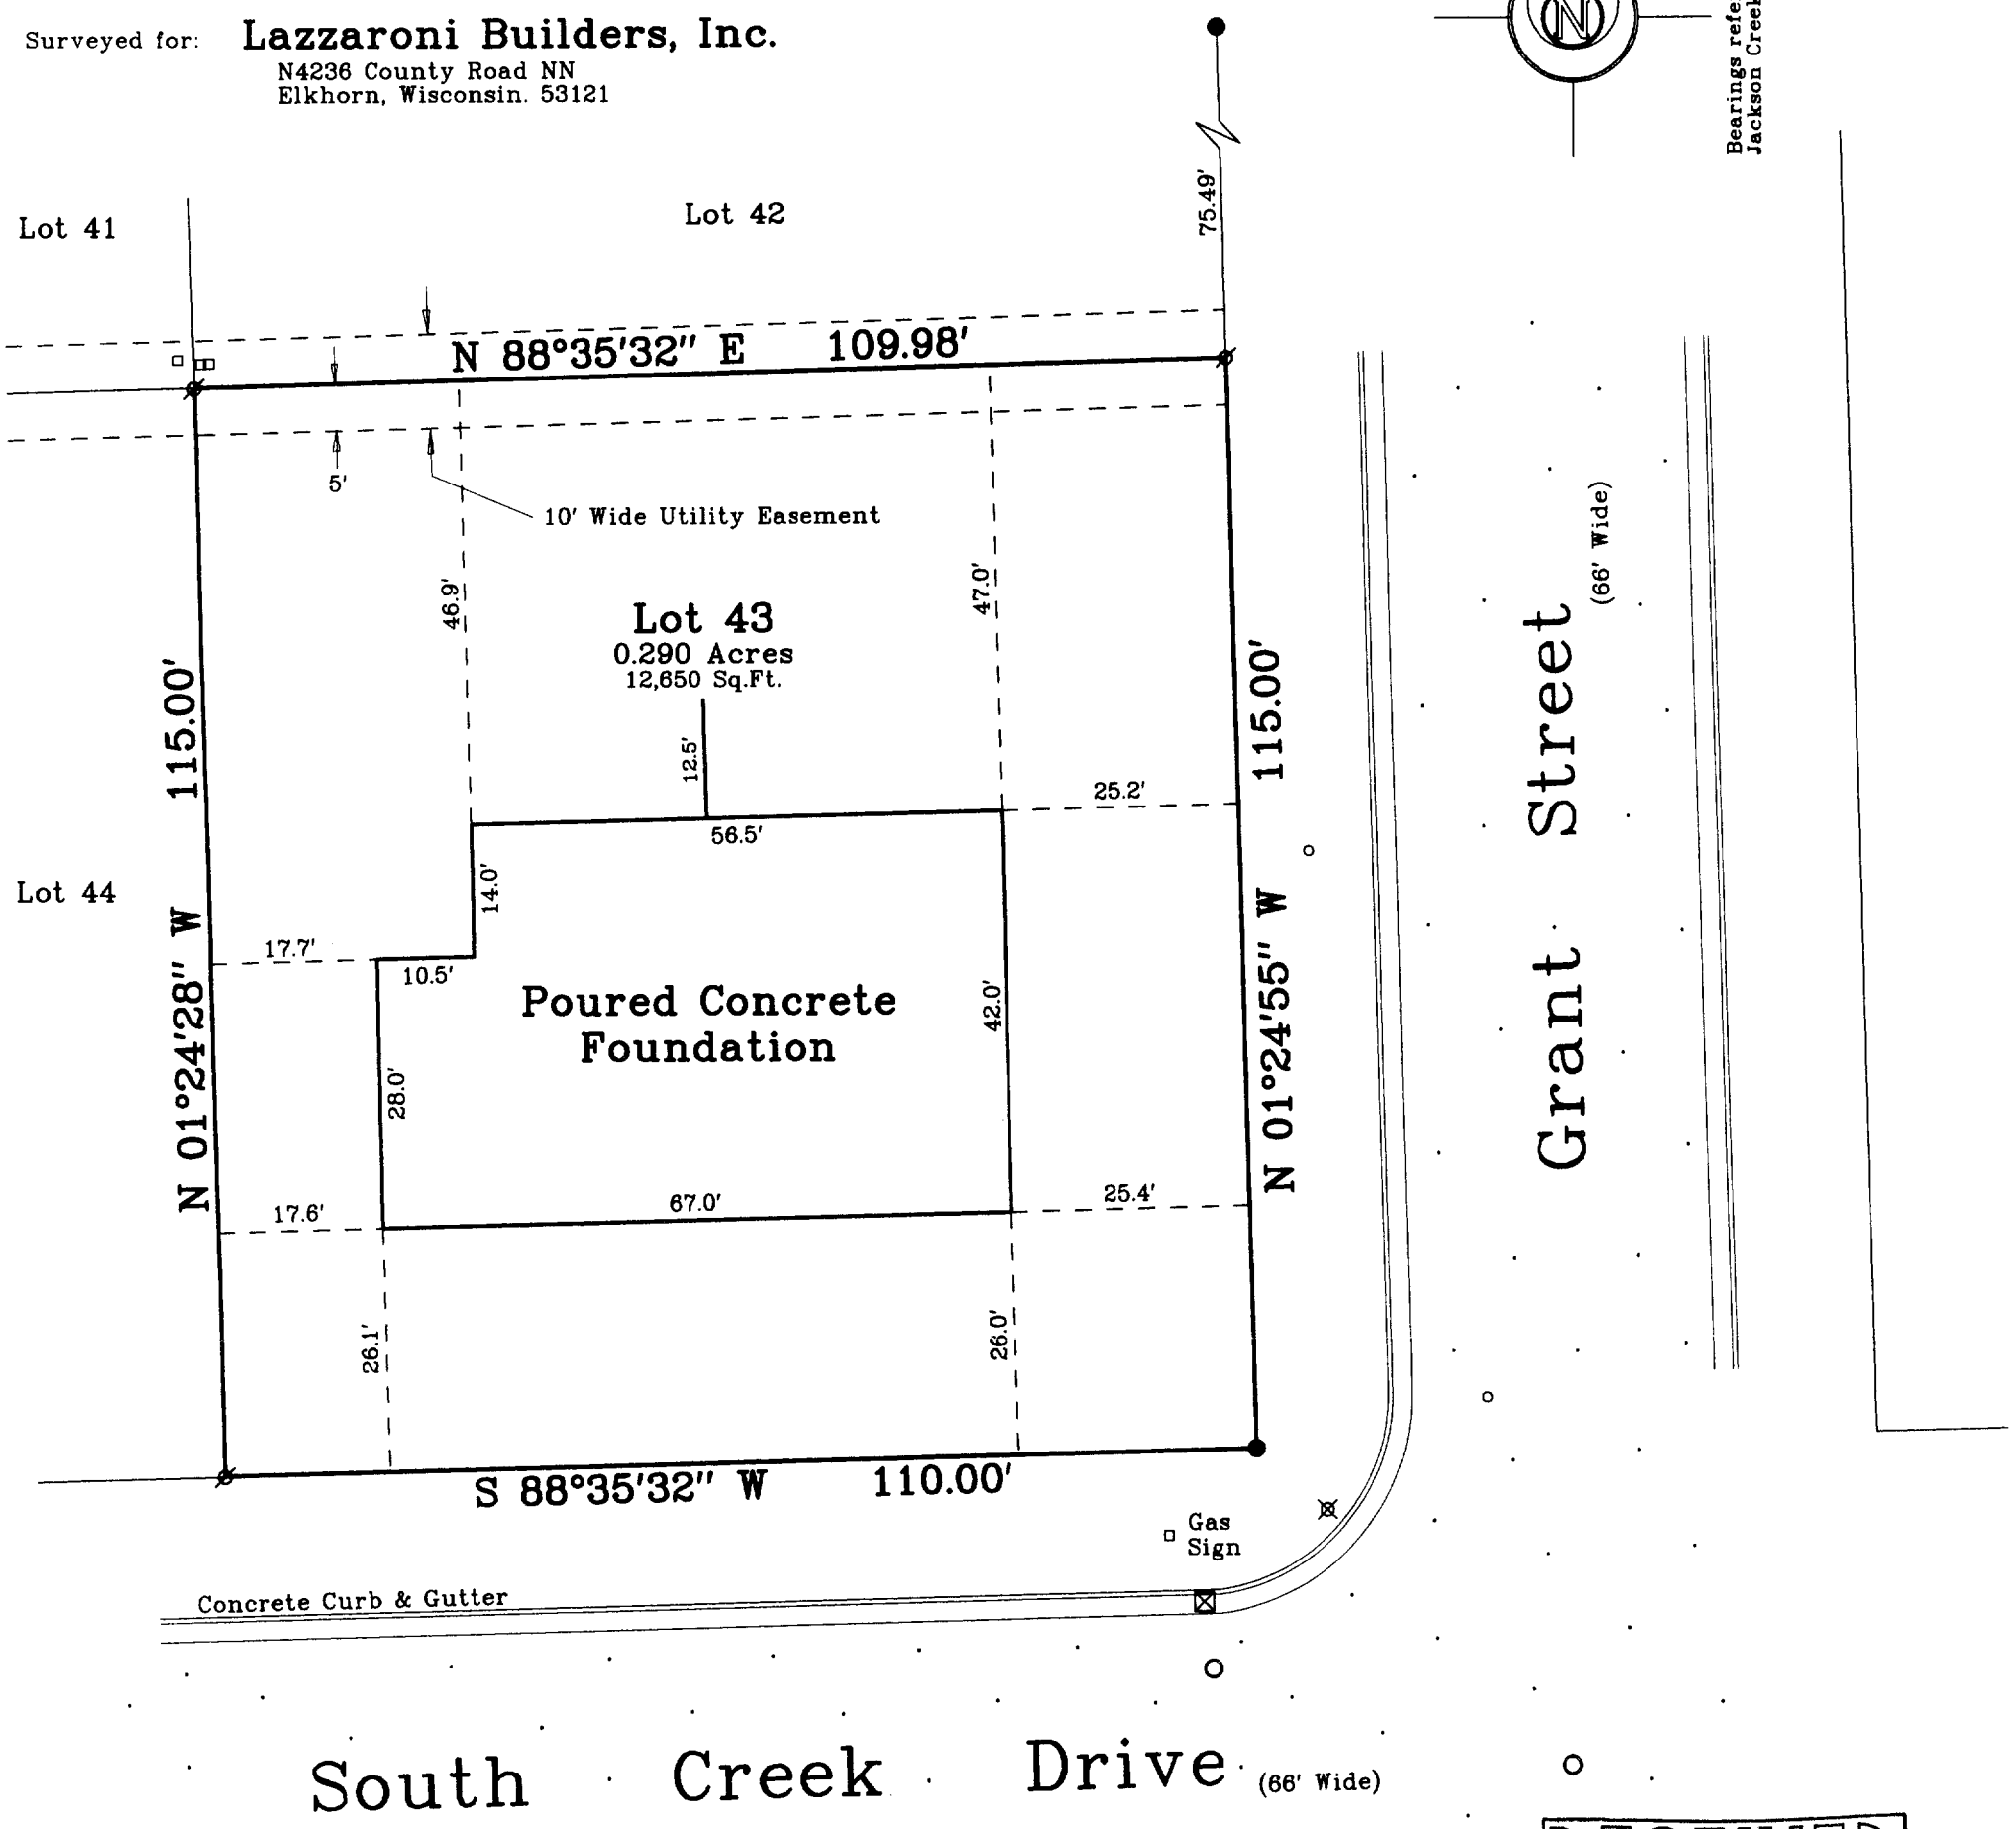


RECEIVED
JUL 13 2000

WISCONSIN
DOUGLAS G. OLSON
S-2093
ELKHORN, WI
LAND SURVEYOR
Not certified unless Stamped in Red.

**Notes:**

1) This survey plat is not certified unless signed and sealed in red ink.
2) This survey is subject to Wisconsin lien laws. This Plat of Survey is the notice of intent to file lien. Lien waiver required.

Copyright c 2000 by Jensen & Olson Land Surveying, LLC.

All rights reserved. No part of this survey plat may be reproduced or transmitted in any form by any means - graphic, electronic, or mechanical, including photocopying, tracing, or information storage and retrieval systems - without permission in writing from Douglas G. Olson, Jensen & Olson Land Surveying, LLC.

I, Douglas G. Olson, Wisconsin Registered Land Surveyor, do hereby certify that this survey was performed by me or under my direction in full compliance with the owner's/agent's instructions and Chapter A-E 7 of the Wisconsin Administrative Code "Minimum Standards for Property Surveys"; and that this map is an accurate representation thereof to the best of my knowledge and belief.

Douglas G. Olson
Wisconsin Registered Land Surveyor - 2093

### Legend

- ● Found Iron Rod, 1 3/16" dia.
- ⌀ Found Iron Rod, 3/4" dia.
- ( ) Recorded Information
- ○ Manhole
- ⊠ Catch Basin
- ⊗ Light Pole
- ○ Water Valve
- ▫ Utility Pedestal
- Asphalt Surface

**Jensen & Olson Land Surveying, LLC**
45 South Wisconsin Street P.O. Box 322
Elkhorn, Wisconsin. 53121
Telephone: (262) 723-3434
Facsimile: (262) 723-8044

Scale: 1" = 20'

0' 10' 20' 40' 60'

YJCE-43
004-1266

Survey date: June 19, 2000.
Revisions:

Sheet 1 of 1 Sheets.

Job Reference Number:
**2000.081**