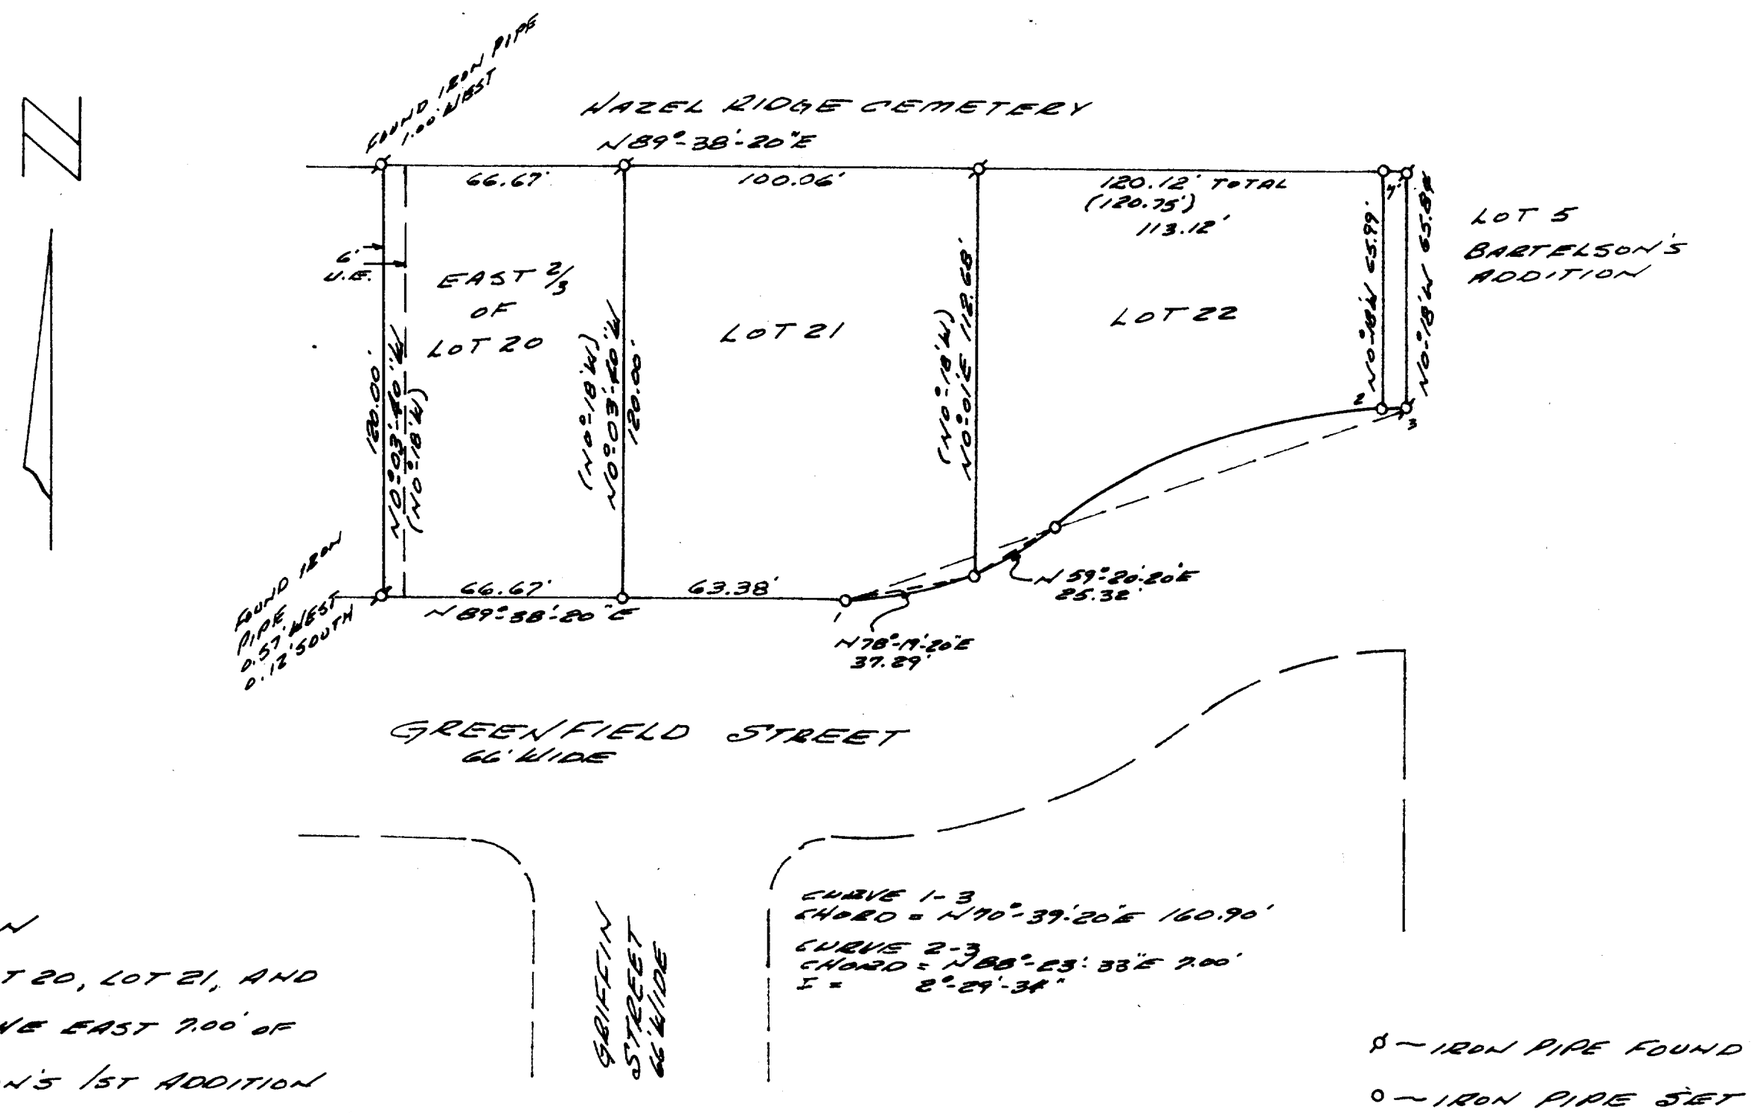

DESCRIPTION

THE EAST 2/3 OF LOT 20, LOT 21, AND LOT 22 EXCEPT THE EAST 7.00' OF LOT 22, BARTELSON'S 1ST ADDITION LOCATED IN THE NW¼ OF THE SW¼ OF SECTION 36, T3N R16E, CITY OF ELKHORN, WALWORTH COUNTY, WISCONSIN.

Δ — IRON PIPE FOUND

O — IRON PIPE SET

OWNER = R. BARTELSON

SURVEYED FOR = E. CARLSON

I CERTIFY: THAT I HAVE SURVEYED THE ABOVE DESCRIBED PROPERTY AND THAT THE PLAT SHOWN HEREON IS AN ACCURATE SURVEY AND A TRUE REPRESENTATION THEREOF AND CORRECTLY SHOWS THE EXTERIOR BOUNDARY LINES AND ALL DIVISIONS OF SAID PROPERTY.

WISCONSIN THOMAS P. A. JENSEN S 1084 ELKHORN, WIS. LAND SURVEYOR

Thomas P. A. Jensen

PLAT OF SURVEY

OF

LOT 21, AND PART OF LOT 20, AND LOT 22, BARTELSON'S 1ST. ADD. SECTION 36, T3N R16E, CITY OF ELKHORN, WALWORTH COUNTY, WISCONSIN.

Thomas P. A. Jensen
SURVEYOR

SCALE 1" = 40'

DATE June 19, 1975

NO. 175H 300 9-68

BA-7, 6.5

4-129 J