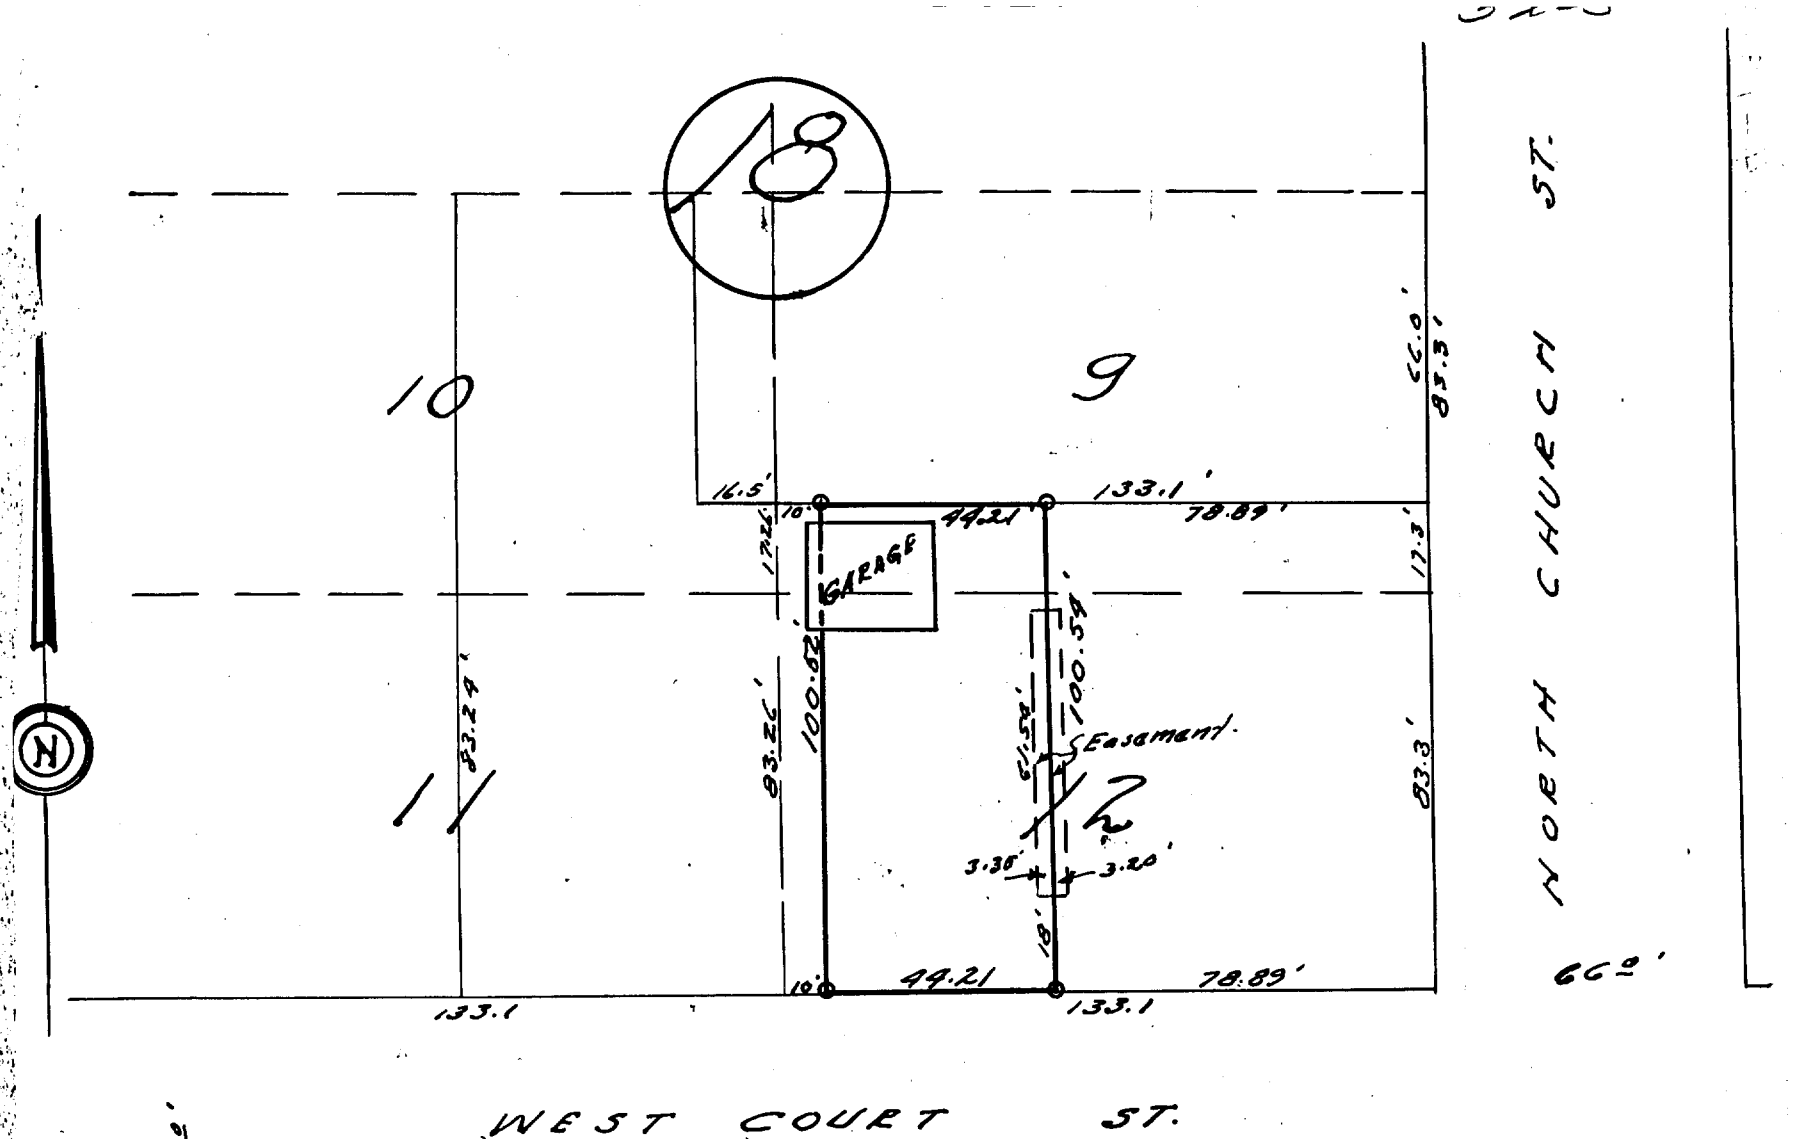


DESCRIPTION.

Commencing at an iron stake in the south line of Lot 12 Block 18 of the Original Plat of the City of Elkhorn, Walworth County, Wisconsin, that is 78.89 feet west of the southeast corner of the said Lot 12, thence West in the south line of said Lot 12, 44.21 feet to an iron stake, thence North 100.52 feet to an iron stake, thence East 44.21 feet to an iron stake, thence South 100.54 feet to the place of beginning.

Easement from Christiano. Commencing at a point that is 78.89 feet west of and 18 feet north of the southeast corner of the said Lot 12, thence West 3.35 feet, thence north 61.54 feet, thence East 3.35 feet, thence South 61.54 feet to the P.O.B.

Easement to Christiano. Commencing at a point that is 78.89 feet west of and 18 feet north of the southeast corner of the said Lot 12, thence East 3.20 feet, thence North 61.54 feet, thence West 3.20 feet, thence South 61.54 feet to the P.O.B.

CERTIFICATE:

I, hereby certify that I have on this the 3rd day of May 1952 surveyed the above described property, and that the above is a true and correct representation of said survey, and that the garage located upon the above described and portrayed property encroaches 30 inches upon the property adjacent to and west of the above described property.

SIGNED AND SEALED THIS 7TH DAY OF MAY 1952.

Joseph M. Biagi. Professional Engineer.
Elkhorn, Wisconsin.

904-131B
4-131B

YOR-134A