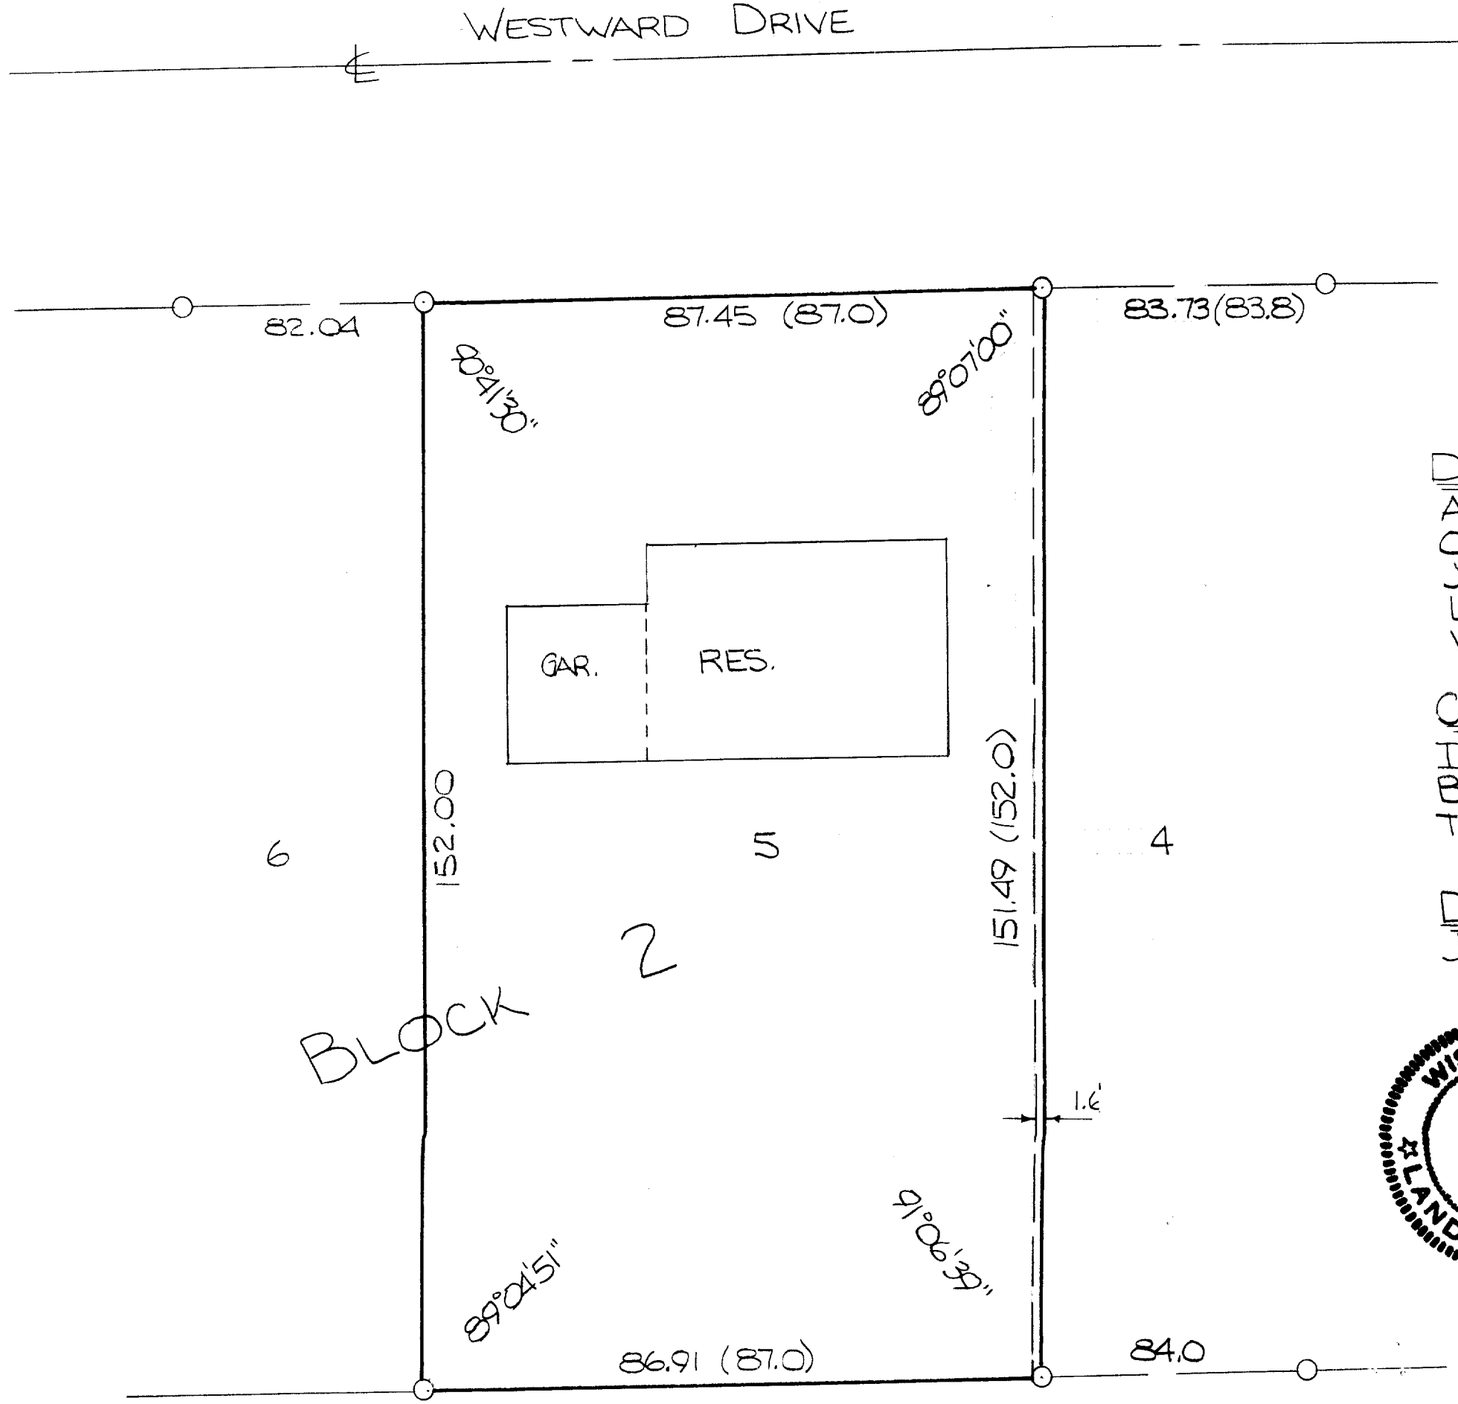


O - IRON PIPE FOUND
( )-RECORDED AS

DESCRIPTION:
ALL OF LOT 5 AND THE WEST 1.6 FEET OF LOT 4 ALL IN BLOCK 2 OF JAMES JONES 2ND ADDITION; A SUBDIVISION LOCATED IN THE CITY OF ELKHORN, WALWORTH COUNTY, WISCONSIN

CERTIFICATE:
I, JOSEPH M. BIAGI, SURVEYOR, DO HEREBY CERTIFY THAT I HAVE SURVEYED THE LANDS HEREON DESCRIBED.

DATE:
JUNE 4, 1975

WISCONSIN
JOSEPH M. BIAGI
S-12
ELKHORN
WIS.
LAND SURVEYOR

JOSEPH M. BIAGI S-12

REVISIONS		
NO.	DATE	BY
1		
2		
3		
4		
5		

DELORME GRAY

LOT 5 & W 1.6' LOT 4 BLK 2 J. JONES 2ND

DRAWN BY GW	SCALE 1"=20'	MATERIAL
CHK'D	DATE 6/4/75	DRAWING NO. 57-75 4-139
TRACED	APP'D	

TELEDYNE POST 18AE-10E—12X18 JA2 - 20