Plat of Survey

of

Lots 22, 23, 24, 25 and the West 1/2 of vacated Washington Street which adjoins said Lots 23 and 24, all in Block 3 of Preston's Addition to the City of Elkhorn, Walworth County, Wisconsin.

Surveyed for: **REMAX Lakes Area Realtors**
1815 North Shore Drive
Delavan, Wisconsin. 53115

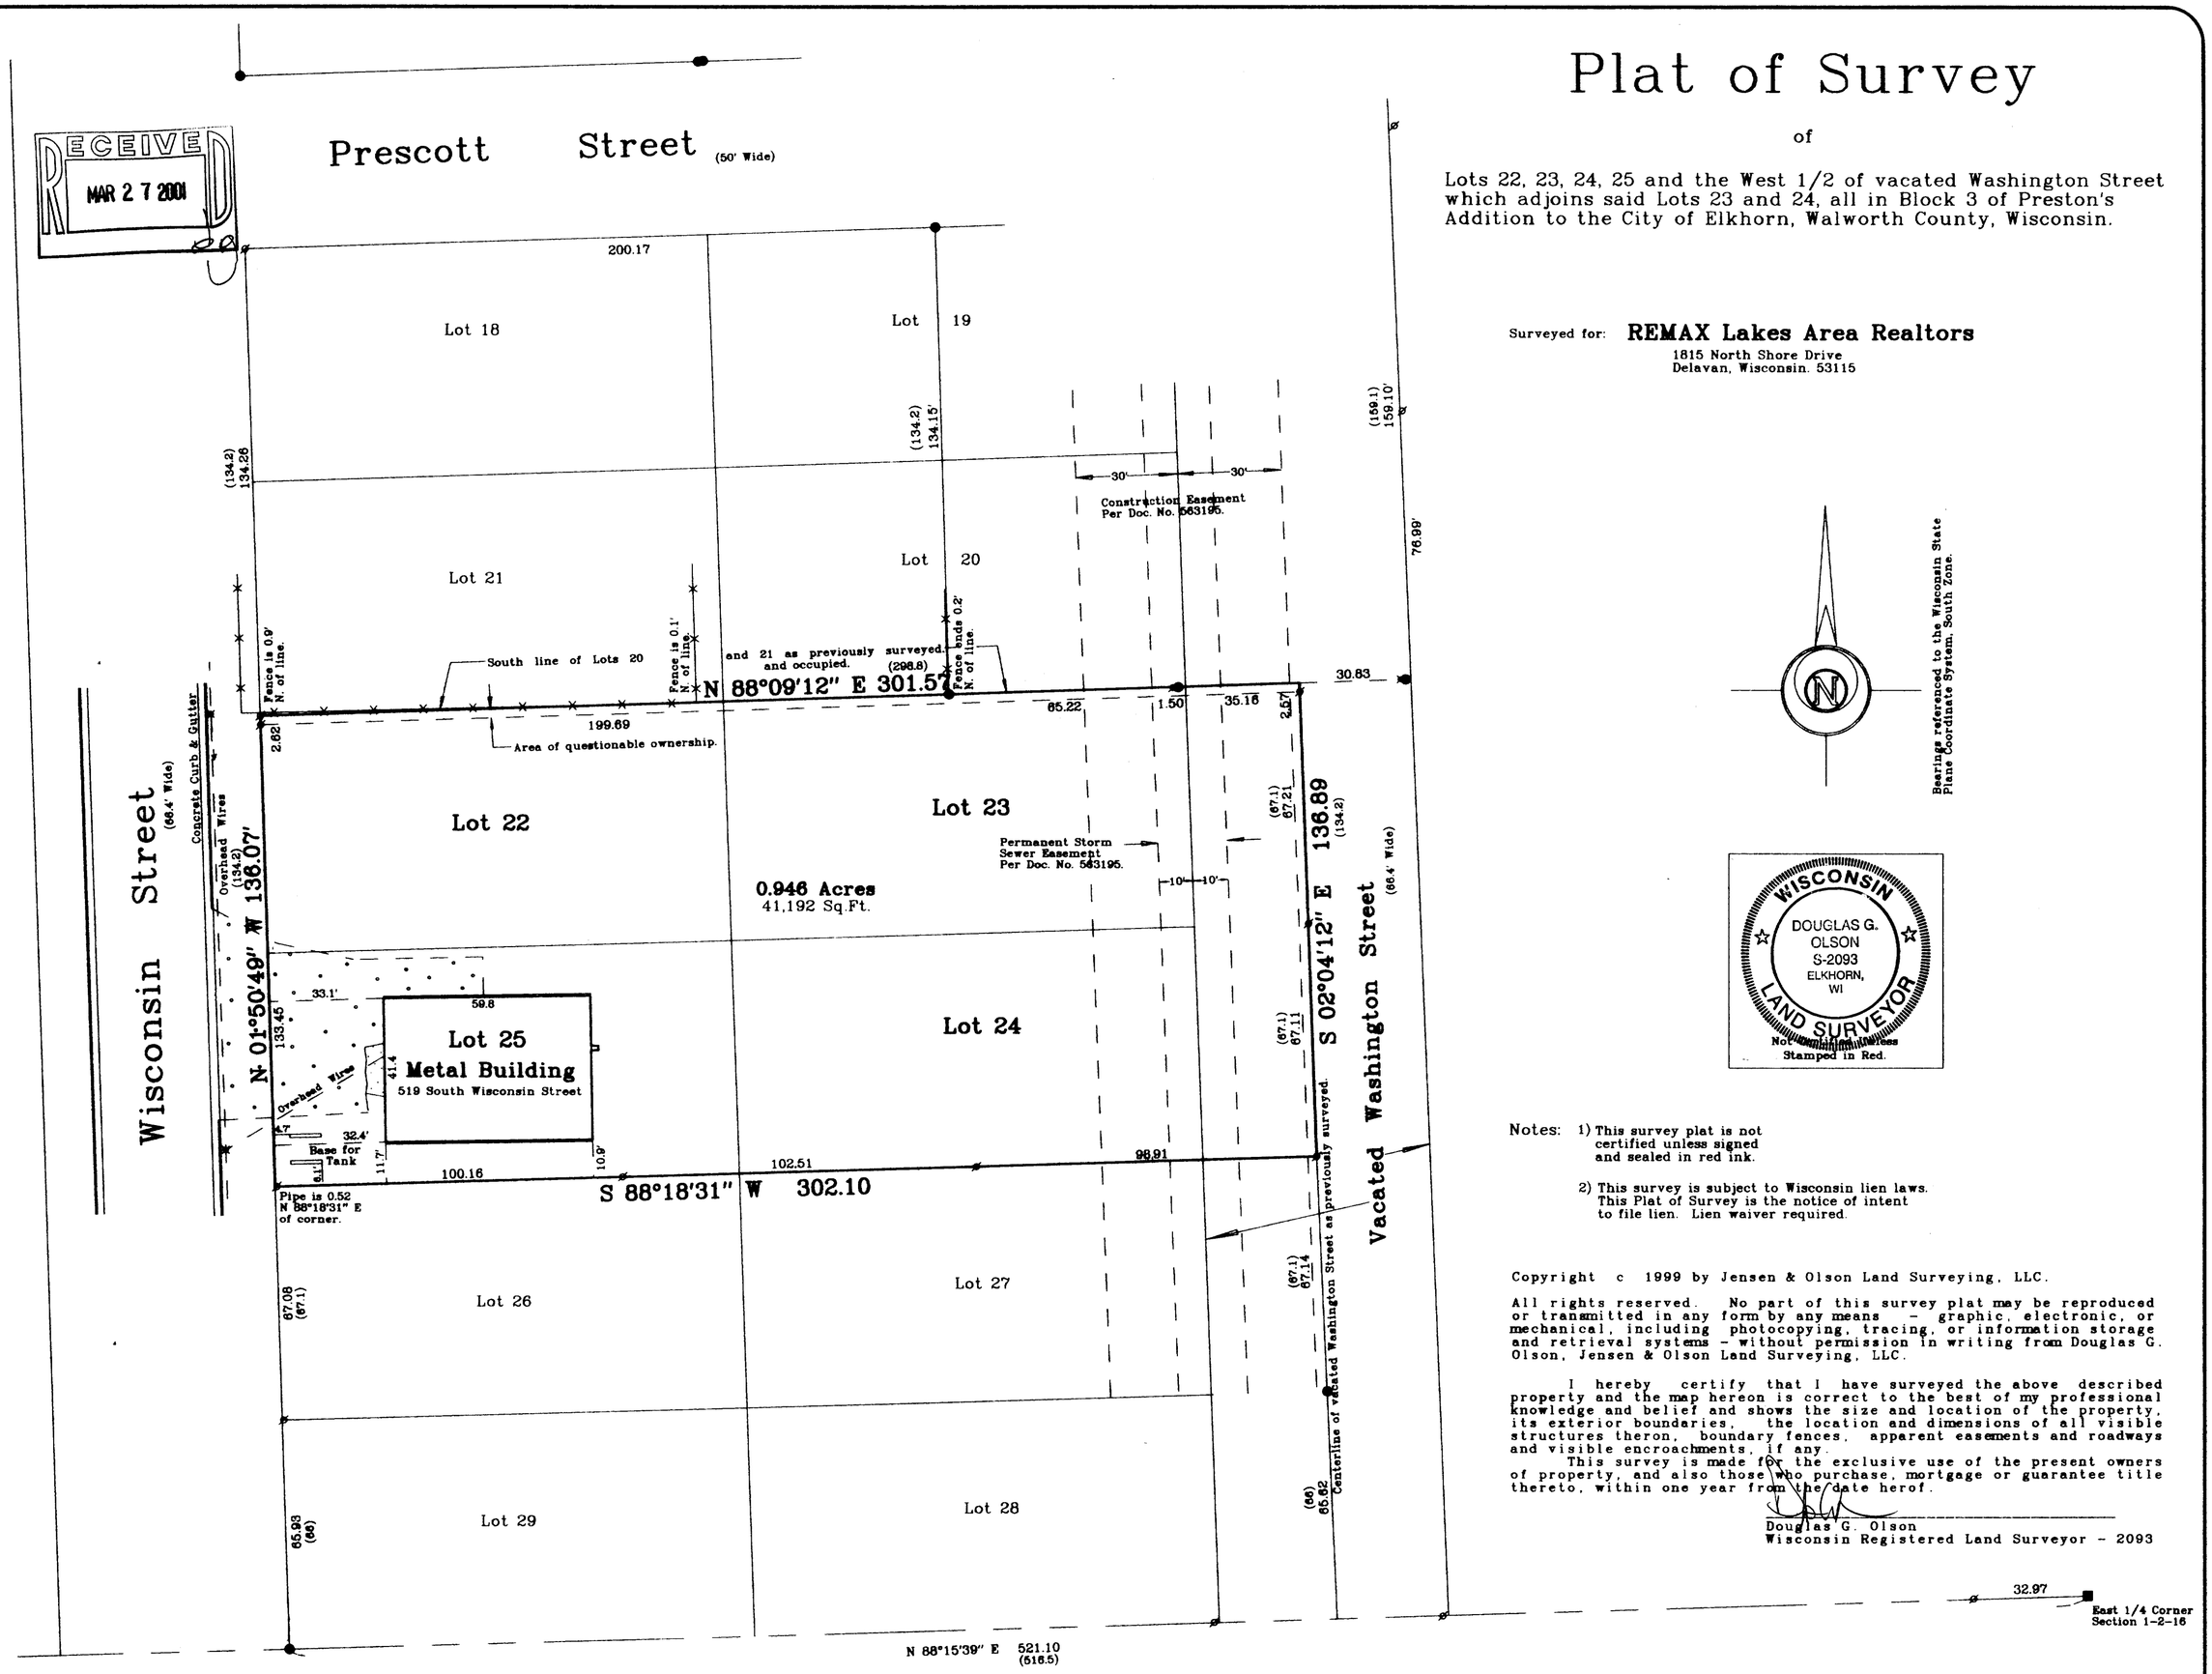

Bearings referenced to the Wisconsin State Plane Coordinate System, South Zone.

WISCONSIN LAND SURVEYOR
DOUGLAS G. OLSON
S-2093
ELKHORN, WI
Not valid unless Stamped in Red.

Notes: 1) This survey plat is not certified unless signed and sealed in red ink.

2) This survey is subject to Wisconsin lien laws. This Plat of Survey is the notice of intent to file lien. Lien waiver required.

Copyright c 1999 by Jensen & Olson Land Surveying, LLC.

All rights reserved. No part of this survey plat may be reproduced or transmitted in any form by any means - graphic, electronic, or mechanical, including photocopying, tracing, or information storage and retrieval systems - without permission in writing from Douglas G. Olson, Jensen & Olson Land Surveying, LLC.

I hereby certify that I have surveyed the above described property and the map hereon is correct to the best of my professional knowledge and belief and shows the size and location of the property, its exterior boundaries, the location and dimensions of all visible structures theron, boundary fences, apparent easements and roadways and visible encroachments, if any.

This survey is made for the exclusive use of the present owners of property, and also those who purchase, mortgage or guarantee title thereto, within one year from the date herof.

Douglas G. Olson
Wisconsin Registered Land Surveyor - 2093

Survey Date: Nov. 15, 1999.
Revisions:

Scale in Feet
1" = 30'
0' 15' 30' 60'

Jensen & Olson Land Surveying, LLC
45 South Wisconsin Street P.O. Box 322
Elkhorn, Wisconsin. 53121
Telephone (262) 723-3434
Facsimile (262) 723-8044

Legend
- Found County Section Corner
- Found Iron Pipe
- Found Iron Rod
- Recorded Information
- Chain Link Fence
- Concrete Surface
- Gravel Surface
- Utility Pole

Sheet 1 of 1 Sheets

Job Reference Number
1999.132

1999.132

YP-161 004-1338