
WALWORTH COUNTY
SURVEYING & MAPPING
P. O. BOX 1115
LAKE GENEVA, WISCONSIN
414-248-0505

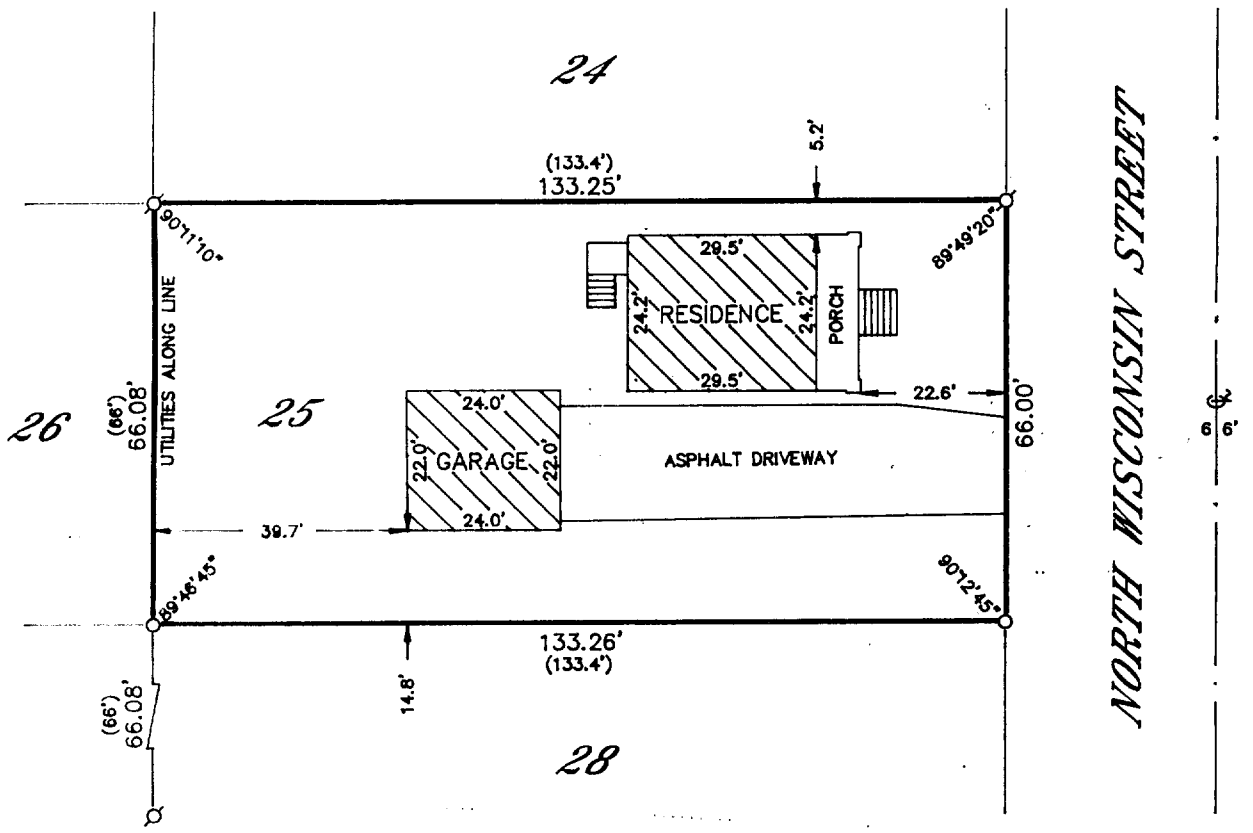



SCALE IN FEET

0 30 60

LEGEND

- ○—IRON PIPE FOUND
- ⌀—IRON ROD FOUND
- ●—CONCRETE MONUMENT FOUND
- ○—IRON PIPE PLACED
- ()—RECORDED AS

PLAT OF SURVEY OF

LOT 25, BLOCK 1 OF HOLTON HEIGHTS, A SUBDIVISION LOCATED IN THE NORTH-WEST 1/4 OF SECTION 36, T 3 N, R 16 E, CITY OF ELKHORN, WALWORTH COUNTY, WISCONSIN.

ORDERED BY: FIVE LAKES BUILDERS
39 MILL STREET
EVANSVILLE, WISCONSIN
53536

RECEIVED
[illegible] 2001

I HEREBY CERTIFY THAT I HAVE SURVEYED THE ABOVE DESCRIBED PROPERTY AND THAT THE ABOVE MAP IS A TRUE REPRESENTATION THEREOF AND SHOWS THE SIZE AND LOCATION OF THE PROPERTY, ITS EXTERIOR BOUNDARIES, THE LOCATION OF ALL VISIBLE STRUCTURES AND DIMENSIONS OF ALL PRINCIPAL BUILDINGS THEREON, BOUNDARY FENCES, APPARENT EASEMENTS, ROADWAYS AND VISIBLE ENCROACH-MENTS, IF ANY, TO THE BEST OF MY KNOWLEDGE AND BELIEF.

THIS SURVEY IS MADE FOR THE USE OF THE PRESENT OWNERS OF THE PROPERTY AND ALSO THOSE WHO PURCHASE, MORTGAGE OR GUARANTEE THE TITLE THERETO WITHIN ONE (1) YEAR FROM DATE HEREOF.

Robert M. Baerenwald

ROBERT M. BAERENWALD
WISCONSIN REGISTERED LAND SURVEYOR, S-1508

DATE July 24, 1997 JOB NO. 5548

NOTE: THIS IS NOT A CERTIFIED COPY UNLESS SEALED.

YHT-14
004-1344