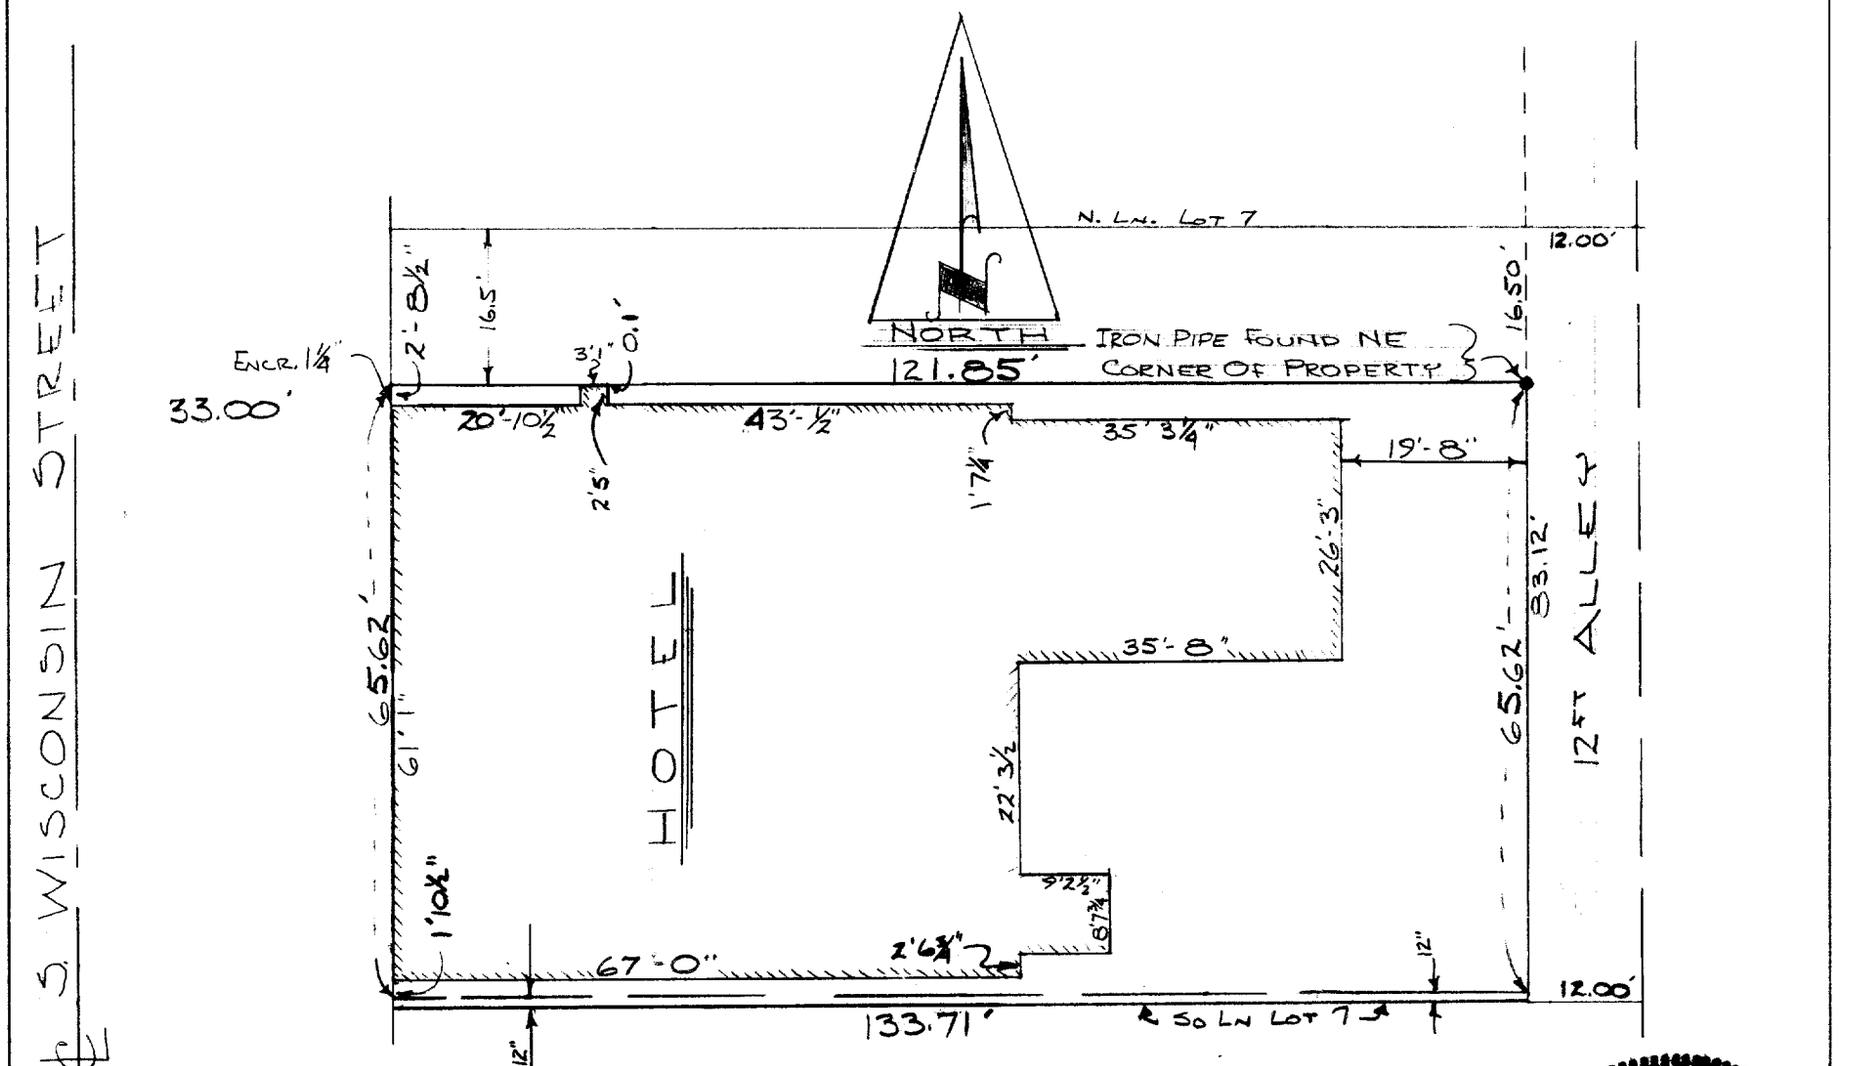


DESCRIPTION: Lot 7 of Block 25 of the Original Plat of the City of Elkhorn, Walworth County, excepting the North 16.50 feet of said lot and the East 12.00 feet of said lot. and the South 1.00 feet of said Lot.

CERTIFICATE: I, James F. Biagi, surveyor, do hereby certify that I have surveyed the property hereon described and that the location of the improvements are as shown.

August 6, 1964.
Revised November 17, 1965.

James F. Biagi

James F. Biagi RLS 272

WISCONSIN JAMES F. BIAGI MILWAUKEE, WIS. LAND SURVEYOR

YOP-211

4-135 B