
PLAT OF SURVEY

LOT 1 OF C.S.M. 2653

LOCATED IN PART OF THE NE 1/4 OF SECTION 25, TOWN 3 NORTH, RANGE 16 EAST, CITY OF ELKHORN, WALWORTH COUNTY, WISCONSIN

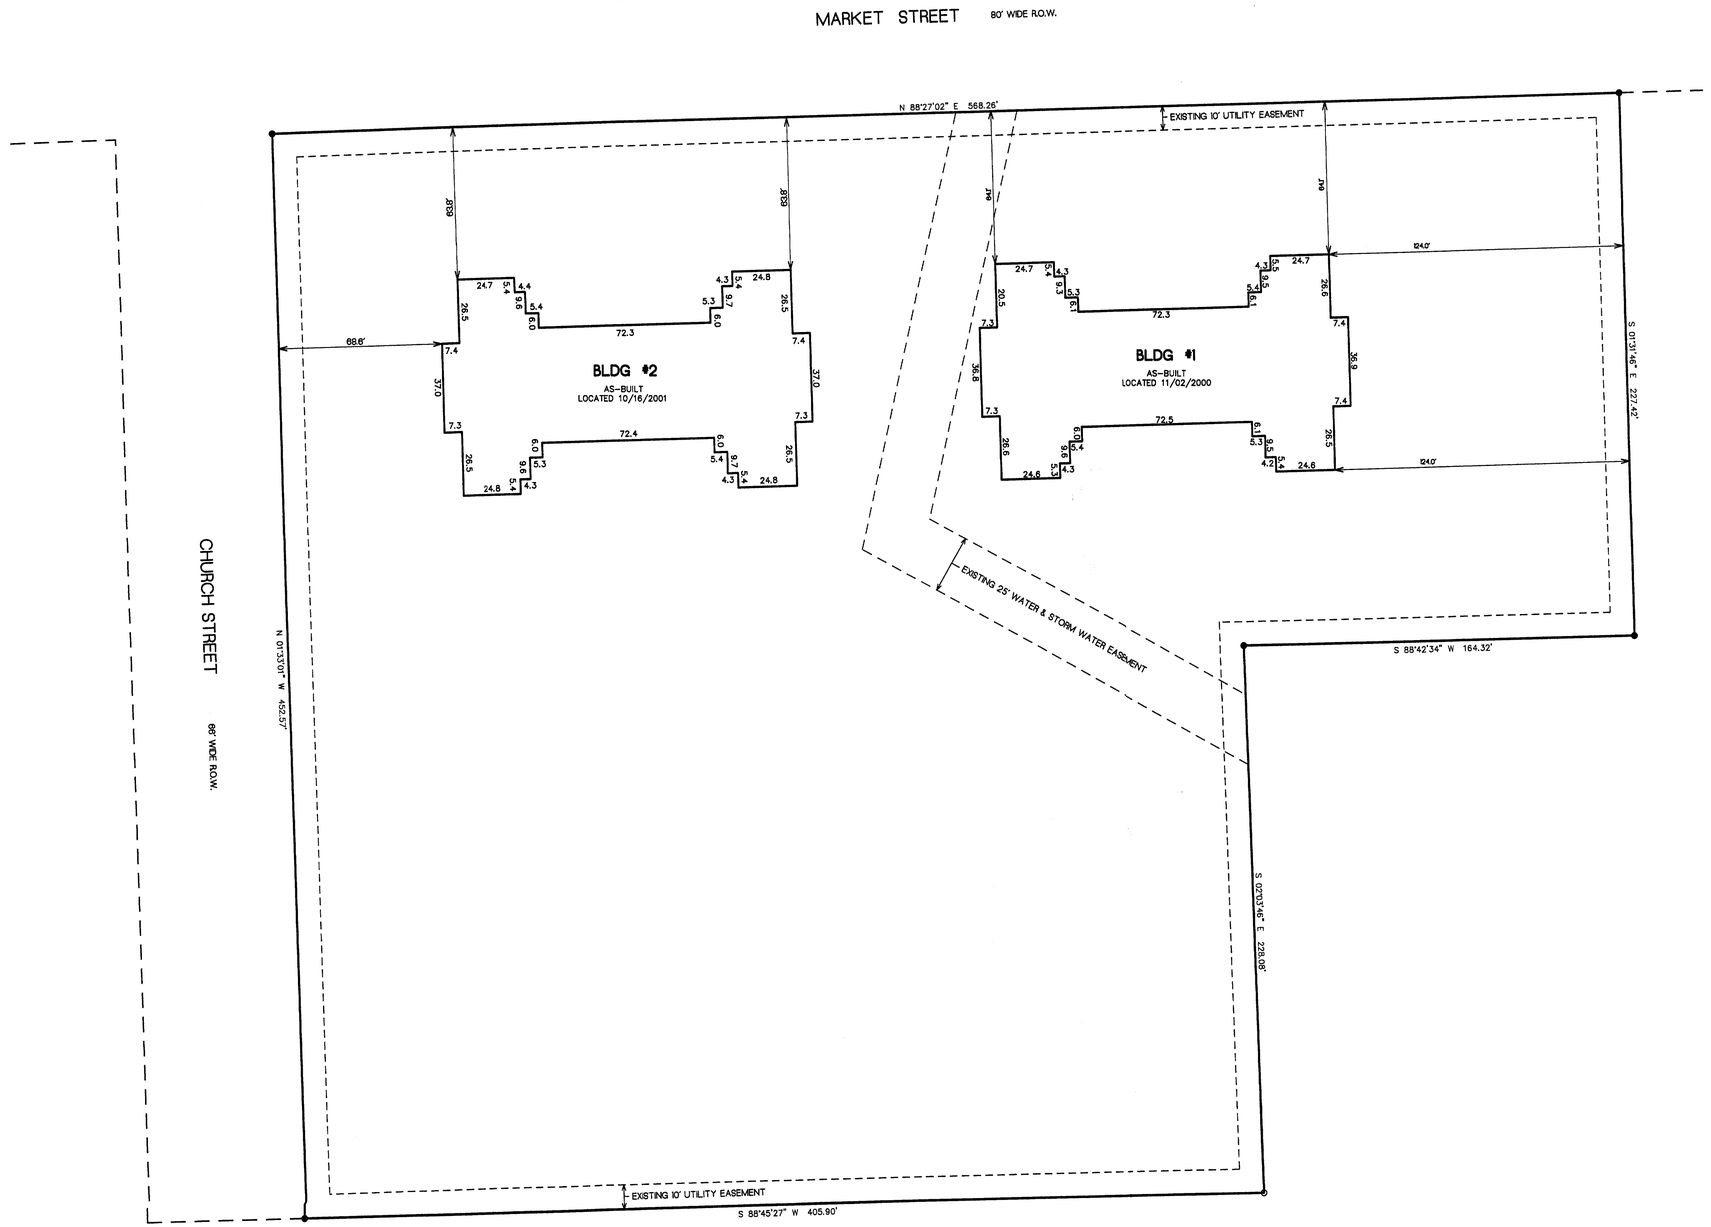

BEARING BASIS PER C.S.M. 2653

LEGEND

- o = FOUND IRON PIPE STAKE
- ● = FOUND IRON REBAR STAKE
- {XXX} = RECORDED AS

RECEIVED
NOV 6 2001

NOTE: COPIES OF THIS MAP TO WHICH THE FOLLOWING CERTIFICATE WILL APPLY SHOW THE SURVEYOR'S ORIGINAL SEAL AND SIGNATURE IN RED INK. COPIES BY ANY OTHER MEANS MAY HAVE ALTERATIONS WHICH DO NOT REPRESENT THE SURVEYOR'S WORK PRODUCT.

I HEREBY CERTIFY THAT THE ABOVE DESCRIBED PROPERTY HAS BEEN SURVEYED UNDER MY DIRECTION AND THAT THE ABOVE MAP IS A TRUE REPRESENTATION THEREOF AND SHOWS THE SIZE AND LOCATION OF THE PROPERTY AND ITS EXTERIOR BOUNDARIES. THIS SURVEY IS MADE FOR THE USE OF THE PRESENT OWNERS OF THE PROPERTY, AND ALSO THOSE WHO PURCHASE, MORTGAGE, OR GUARANTEE THE TITLE THERETO WITHIN ONE YEAR FROM THE DATE HEREOF.

DATED: 10/17/2001

PETER S. GORDON R.L.S. 2101

100 90 80 70 60 50 40 30 20 10 0 50 100

MAP SCALE IN FEET ORIGINAL 1" = 30'

OCT 17 2001

004-1435

VA-2653-1

MARKET STREET VILLAGE

APARTMENT DEVELOPMENT
MARKET STREET
CITY of ELKHORN, WALWORTH CO., WISCONSIN

FARRIS, HANSEN & ASSOCIATES, INC.
ENGINEERING – ARCHITECTURE – SURVEYING
P.O. BOX 437
1 RIDGWAY COURT
ELKHORN, WISCONSIN 53121
OFFICE: (262) 723-2098 FAX: (262) 723-5886

REVISIONS

PROJECT NO. 5444

DATE 10/17/2001

SHEET NO. 1 OF 1