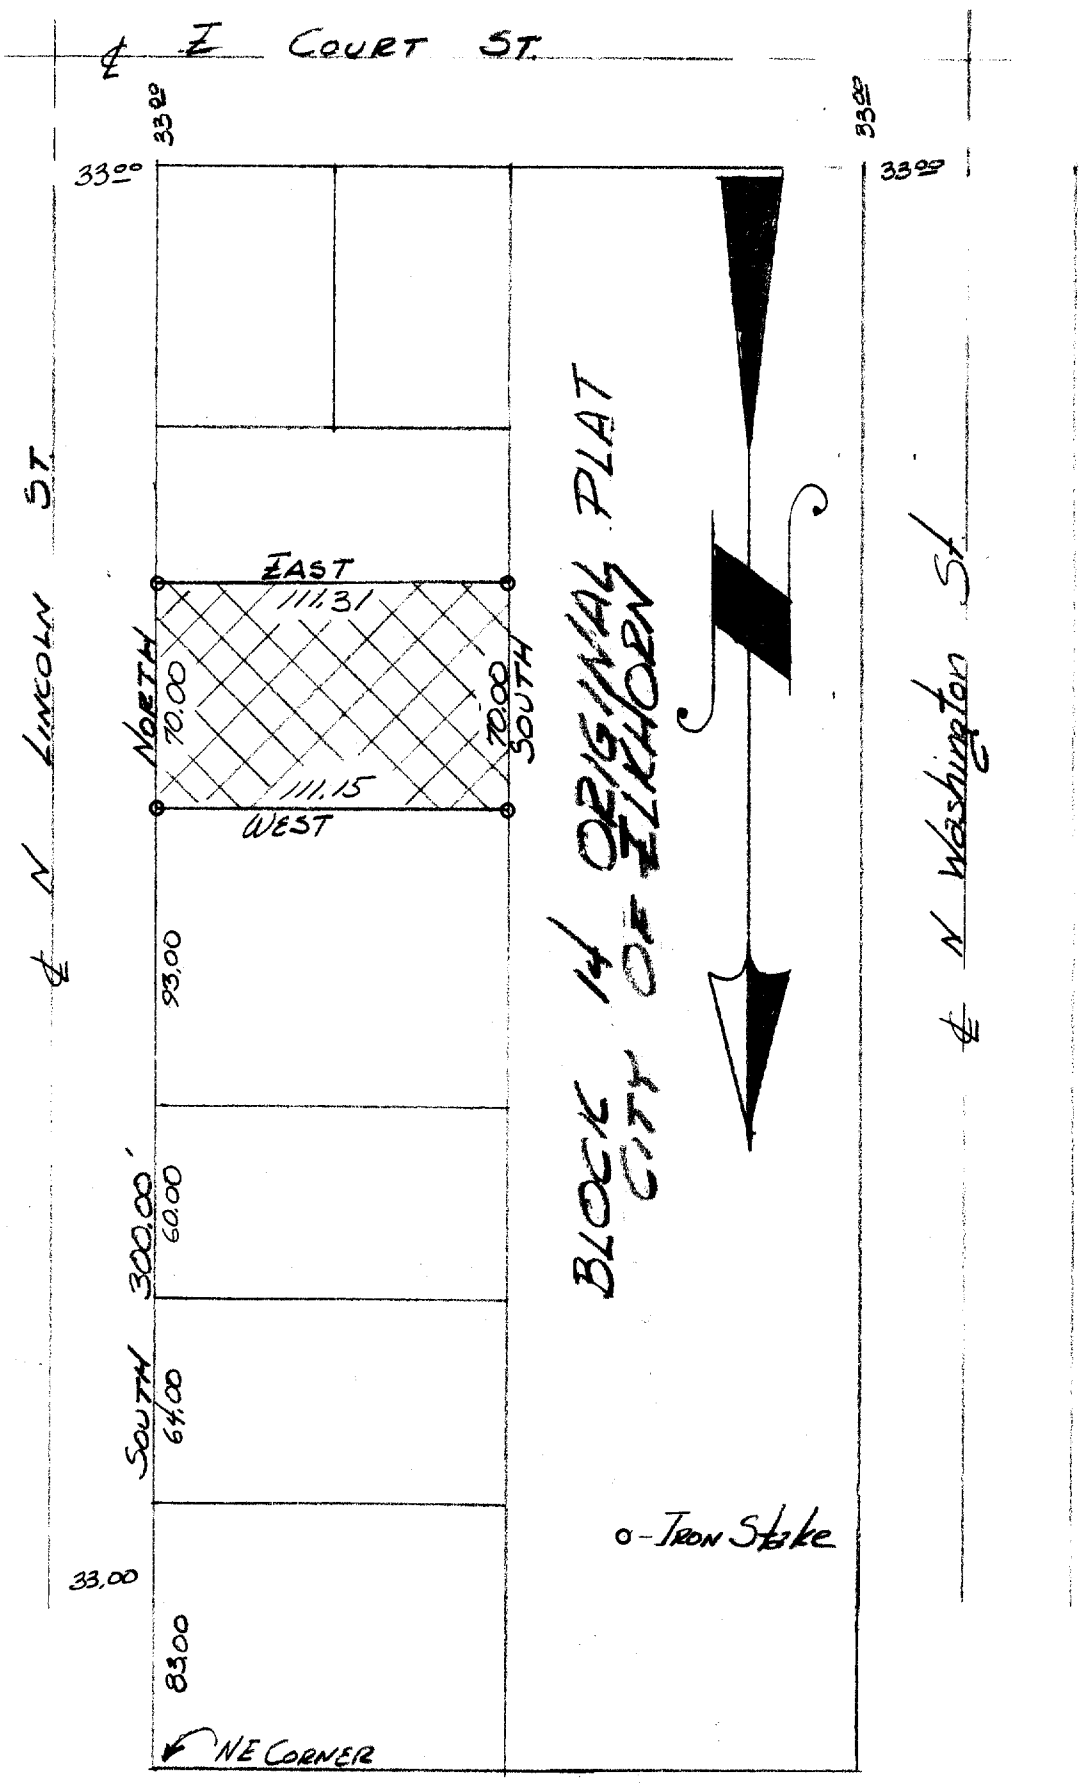


DESCRIPTION: Commencing at an iron stake in the West line of North Lincoln Street that is 300.00 feet South of the NE corner of Block 14 of the Original Plat of the City of Elkhorn, Walworth County, Wisconsin, thence West 111.15 to an iron stake, thence South 70.00 feet to an iron stake, thence East 111.31 feet to an iron stake in the West line of Lincoln Street, thence North 70.00 feet to the place of beginning.

CERTIFICATE: I hereby certify that I have on this 30th day of October 1958 surveyed the property hereon described and drawn, and that said description corresponds with the description as found in the deed to the property; I further certify that the drawing shown above is an accurate portrayal of the survey as conducted in the field.

SIGNED AND SEALED 31, OCTOBER, 1958.

James F. Bagg

OP-83

4-146 B