
PLAT OF SURVEY

- OF -

BEGINNING AT A POINT IN THE WEST LINE OF NORTH CHRUCH STREET IN THE CITY OF ELKHORN, THAT IS 595.8 FEET NORTH OF THE INTERSECTION OF THE NORTH LINE OF SECOND AVENUE WITH THE WEST LINE OF NORTH CHURCH STREET , IN SAID CITY, THENCE NORTH 75.00 FEET ; THENCE WEST 135.00 FEET ; THENCE SOUTH 75.00 FEET ;THENCE EAST 135.00 FEET TO THE PLACE OF BEGINNING.

PREPARED FOR: DIANNE SHOWALTER
C-21 SKANDIA
822 E GENEVA
DELAVAN, WI, 53115

J.K. SURVEYING INC.
N3705 WILLOWBEND LANE
LAKE GENEVA, WI, 53147
262-248-3697

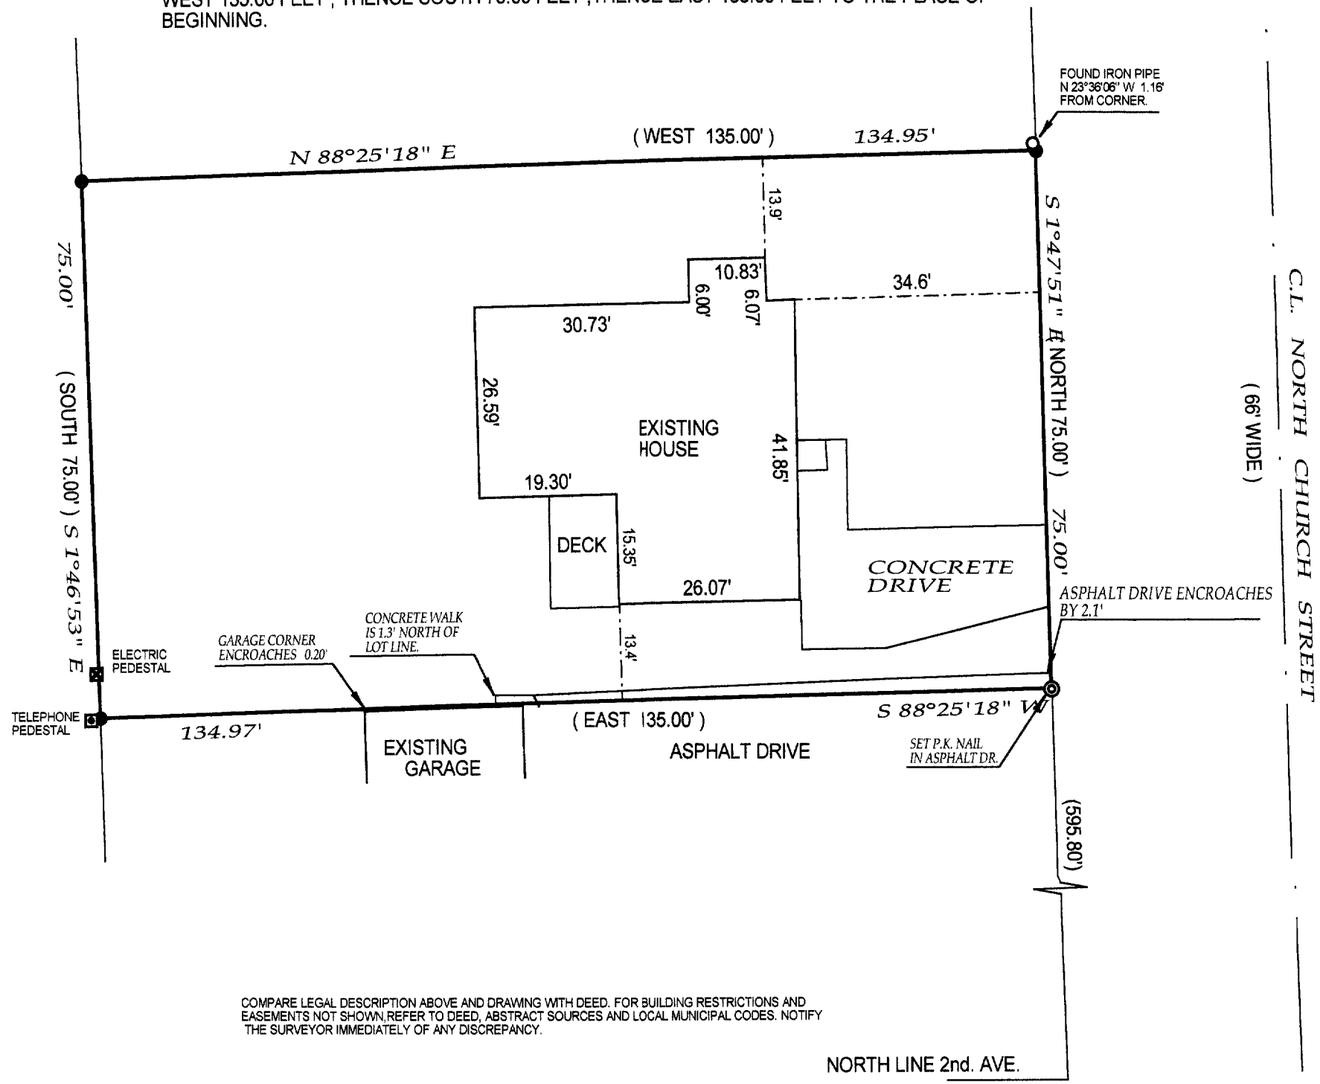

( )= recorded as

□ = found iron bar

○ = found iron pipe

● = set iron pipe

■ = set iron bar

SCALE 1" = 20'

JOB # 02-294A

TAX ID # YU NW 00035

COMPARE LEGAL DESCRIPTION ABOVE AND DRAWING WITH DEED. FOR BUILDING RESTRICTIONS AND EASEMENTS NOT SHOWN,REFER TO DEED, ABSTRACT SOURCES AND LOCAL MUNICIPAL CODES. NOTIFY THE SURVEYOR IMMEDIATELY OF ANY DISCREPANCY.

"I hereby certify that I have surveyed the above described property and that the above map is a true representation thereof and shows the size and location of all visible structures, apparent easements and encroachments if any."
This survey is made for the present owners of the property, and those who purchase, mortgage, or guarantee the title thereto, within one year from the date hereof. DATED THIS 5 TH, DAY OF JUNE 20 02 .

AUG 16 2002

WISCONSIN
JOHN P. KROTT S-2258 MUKWONAGO, WIS.
LAND SURVEYOR

JOHN KROTT S - 2258
Wisconsin Registered Land Surveyor
(original if signed in red)

4-1495


PLAT OF SURVEY

- OF -

BEGINNING AT A POINT IN THE WEST LINE OF NORTH CHRUCH STREET IN THE CITY OF ELKHORN, THAT IS 595.8 FEET NORTH OF THE INTERSECTION OF THE NORTH LINE OF SECOND AVENUE WITH THE WEST LINE OF NORTH CHURCH STREET , IN SAID CITY, THENCE NORTH 75.00 FEET ; THENCE WEST 135.00 FEET ; THENCE SOUTH 75.00 FEET ;THENCE EAST 135.00 FEET TO THE PLACE OF BEGINNING.

PREPARED FOR: DIANNE SHOWALTER
C-21 SKANDIA
822 E GENEVA
DELAVAN, WI, 53115

J.K. SURVEYING INC.
N3705 WILLOWBEND LANE
LAKE GENEVA, WI, 53147
262-248-3697

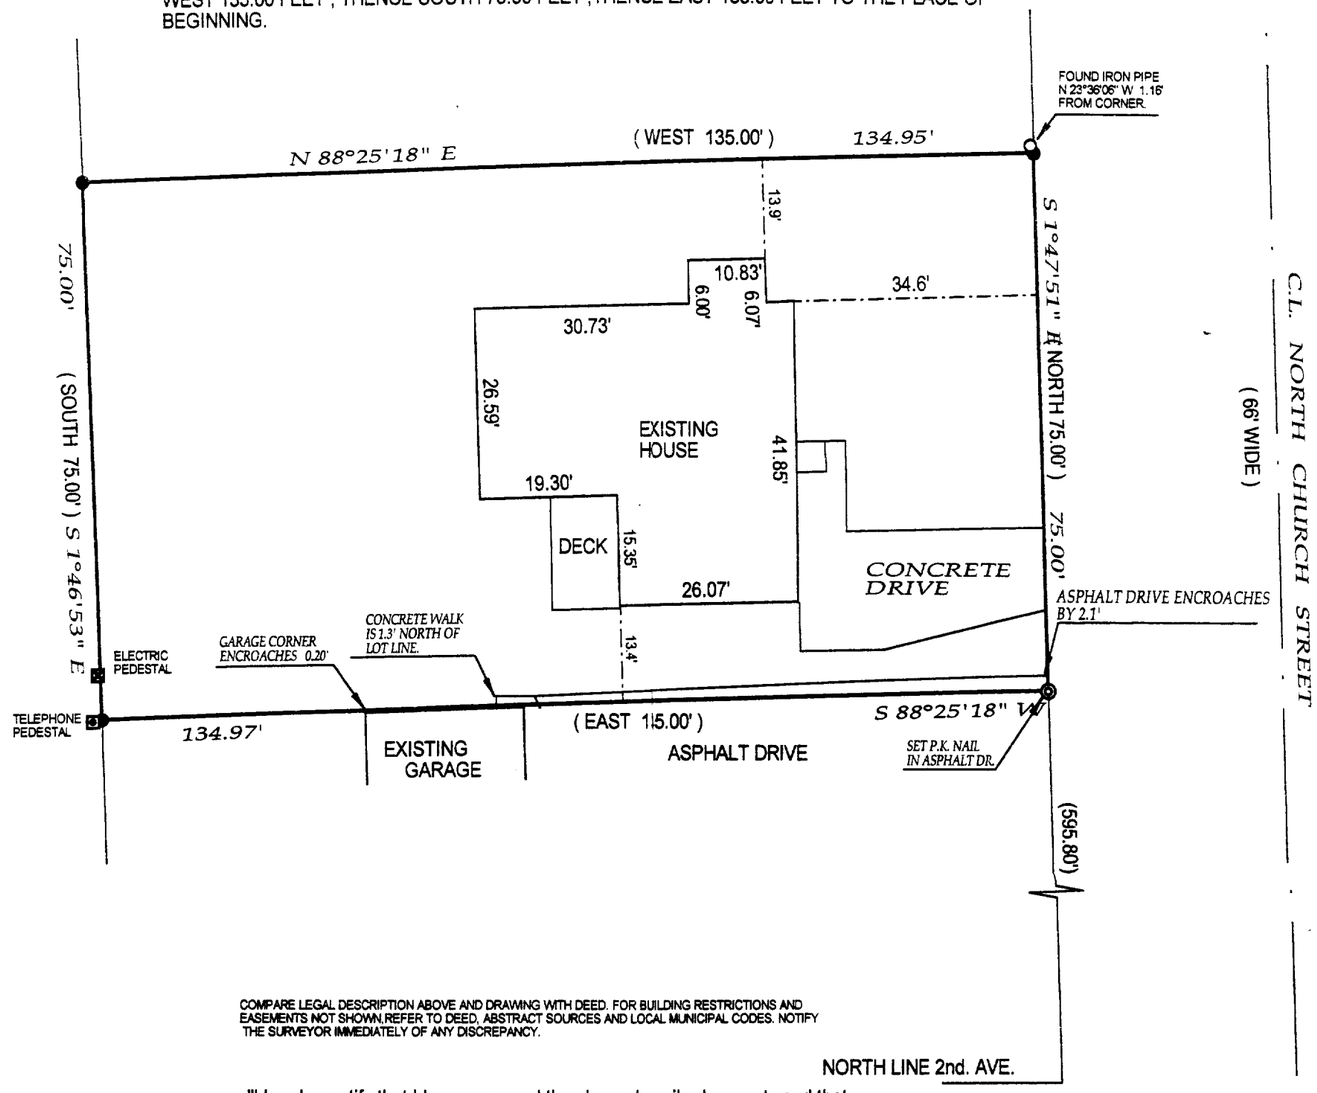

( )= recorded as

□ = found iron bar

○ = found iron pipe

● = set iron pipe

■ = set iron bar

SCALE 1" = 20'

JOB # 02-294A

TAX ID # YU NW 00035

COMPARE LEGAL DESCRIPTION ABOVE AND DRAWING WITH DEED. FOR BUILDING RESTRICTIONS AND EASEMENTS NOT SHOWN,REFER TO DEED, ABSTRACT SOURCES AND LOCAL MUNICIPAL CODES. NOTIFY THE SURVEYOR IMMEDIATELY OF ANY DISCREPANCY.

"I hereby certify that I have surveyed the above described property and that the above map is a true representation thereof and shows the size and location of all visible structures, apparent easements and encroachments if any."
This survey is made for the present owners of the property, and those who purchase, mortgage, or guarantee the title thereto, within one year from the date hereof. DATED THIS 5 TH, DAY OF JUNE 20 02 .

RECEIVED
JUN 16 2002

WISCONSIN
JOHN P. KROTT
S-2258
MUKWONAGO, WIS.
LAND SURVEYOR

JOHN KROTT S - 2258
Wisconsin Registered Land Surveyor
(original if signed in red)

1495