PLAT OF SURVEY

OF

LOT 3 OF CERTIFIED SURVEY NO. 65 LOCATED IN THE NW¼ OF THE NE¼ OF SECTION ~~33~~ 36, T3N R16E, CITY OF ELKHORN, WALWORTH COUNTY, WISCONSIN

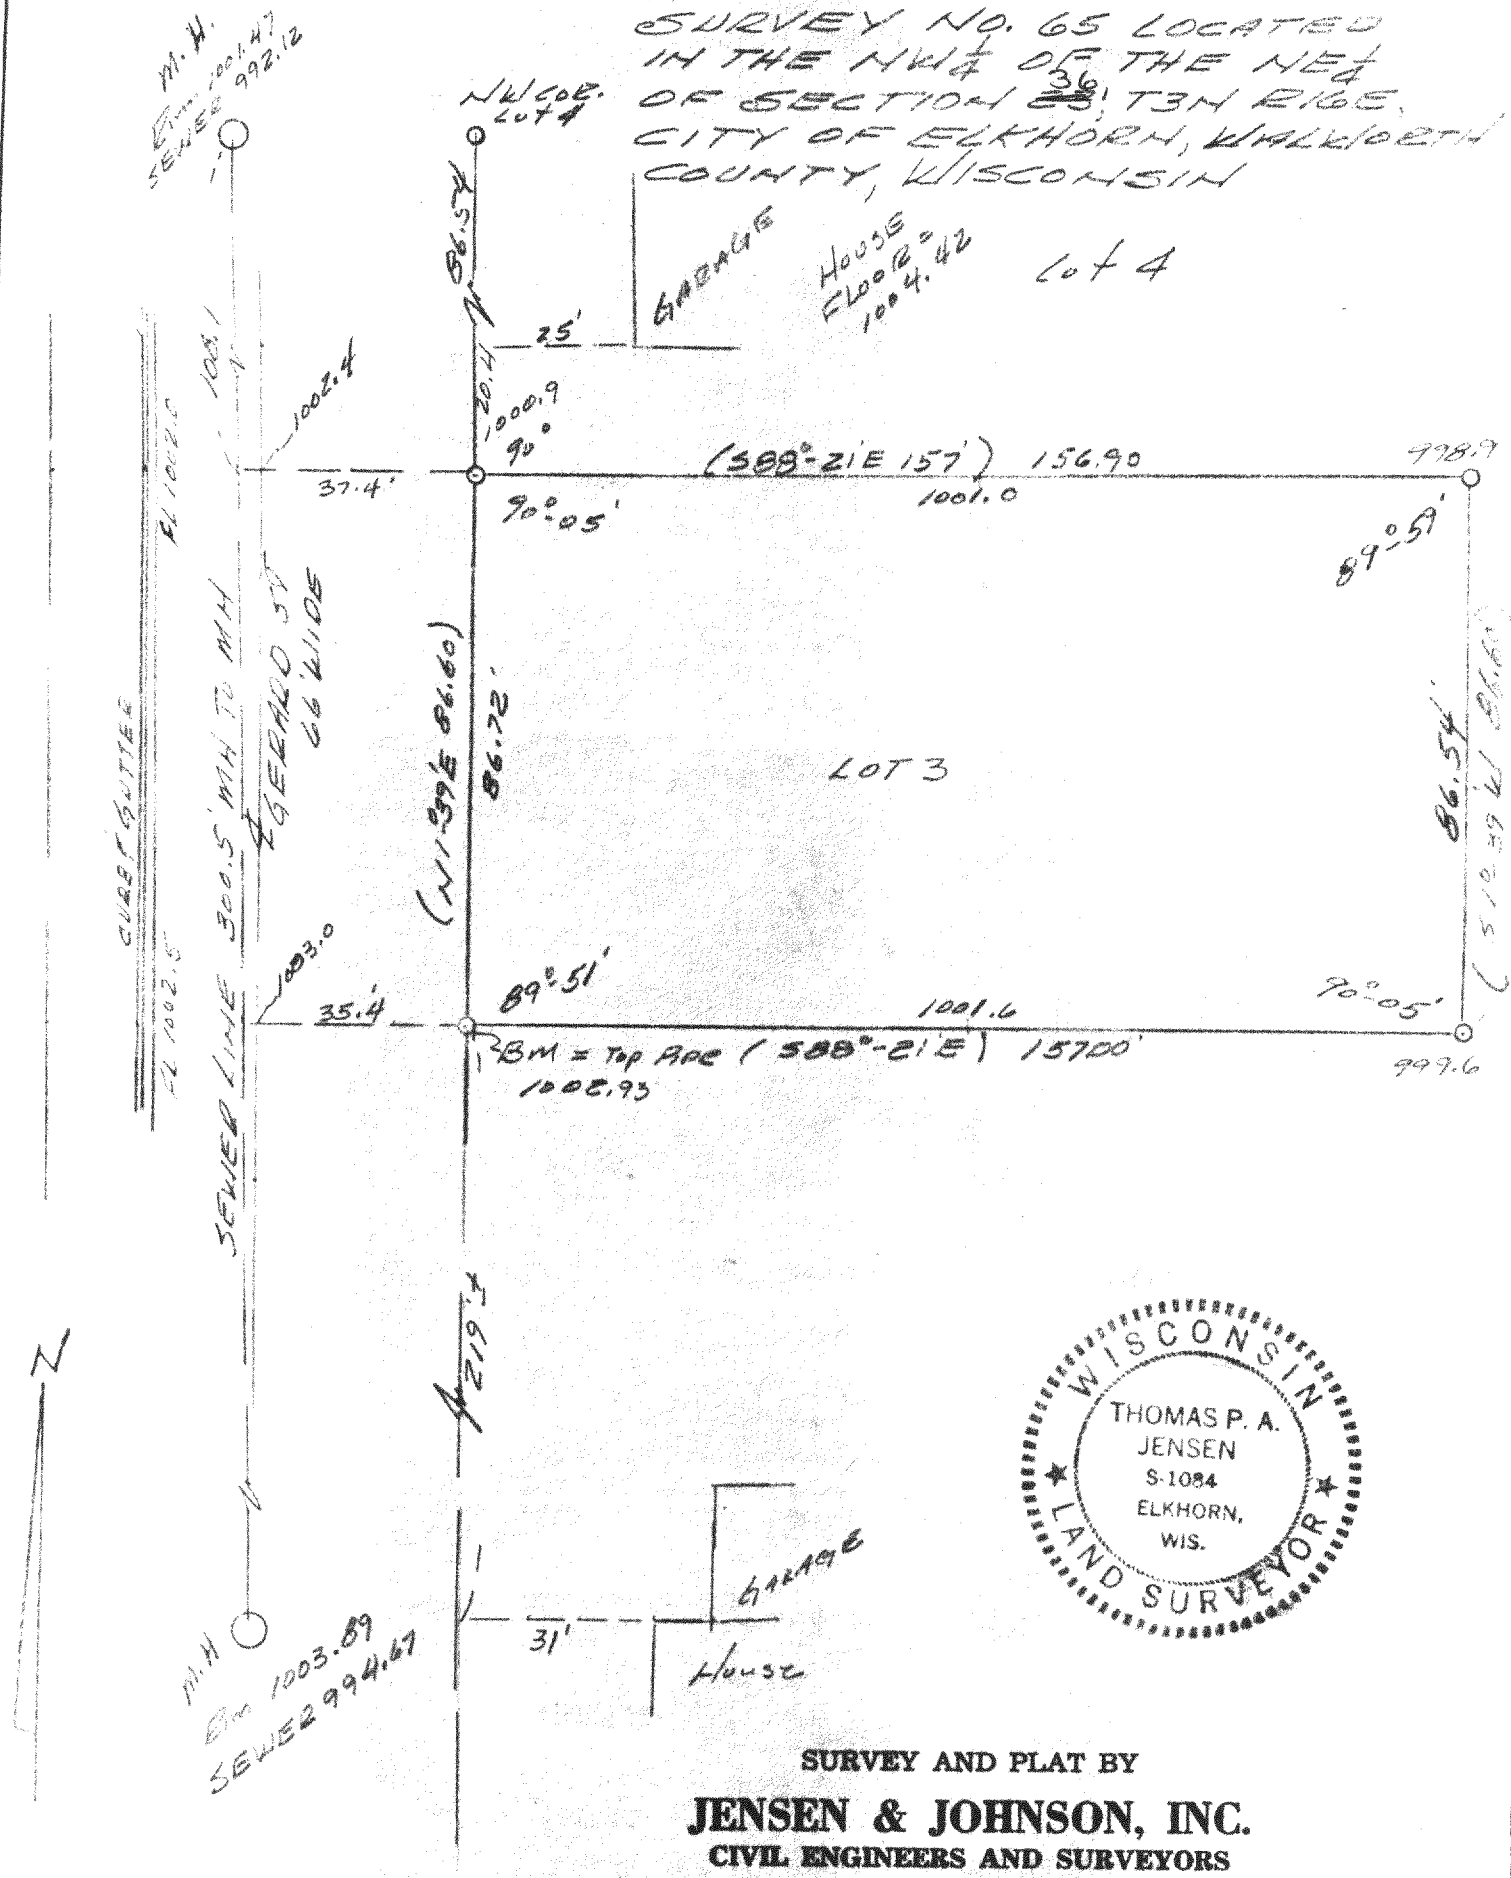

LEGEND

○ — Iron Pipe FOUND

● — Concrete Monument

Scale 1" = 30'

BM = BENCH MARK

( ) = RECORDED AS

SURVEY AND PLAT BY

JENSEN & JOHNSON, INC.

CIVIL ENGINEERS AND SURVEYORS

Elkhorn, Wisconsin

WE CERTIFY: That we have surveyed the above described property and that the plat shown hereon is an accurate survey and a true representation thereof and correctly shows the exterior boundary lines and all divisions of said property.

Date JUNE 5, 1974

Thomas P. A. Jensen

4-149J

[redacted]

Wisconsin Registered Land Surveyor, No. S-[redacted]

WISCONSIN
THOMAS P. A. JENSEN
S-1084
ELKHORN, WIS.
LAND SURVEYOR