
61-59

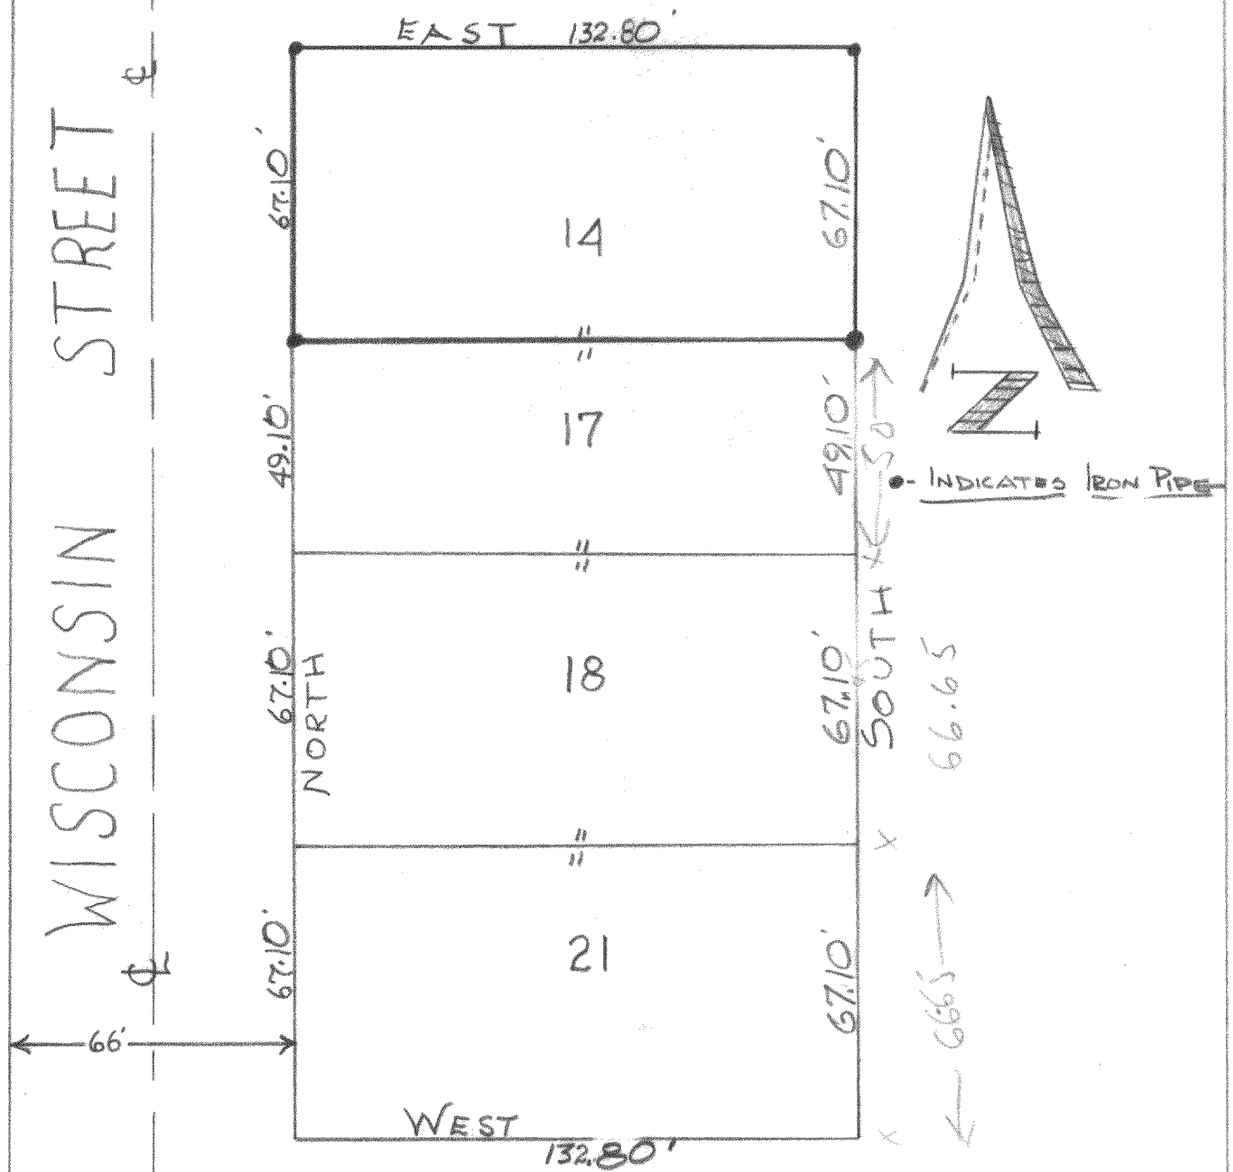

DISCRIPTION:

Lots # 14, 17, 18, 21 in Block #3, of Preston's addition, City of Elkhorn, county of Walworth, Wisconsin.

WISCONSIN JAMES F. BIAGI MILWAUKEE, WIS. LAND SURVEYOR

CERTIFICATE:

I James F. Biagi, Surveyor, do hereby certify that I have surveyed the property herson described.

SIGNED AND SEALED 20 JULY 1961.

James F. Biagi RLS 272

YP; 12, 15

4-150 B