
#111-63

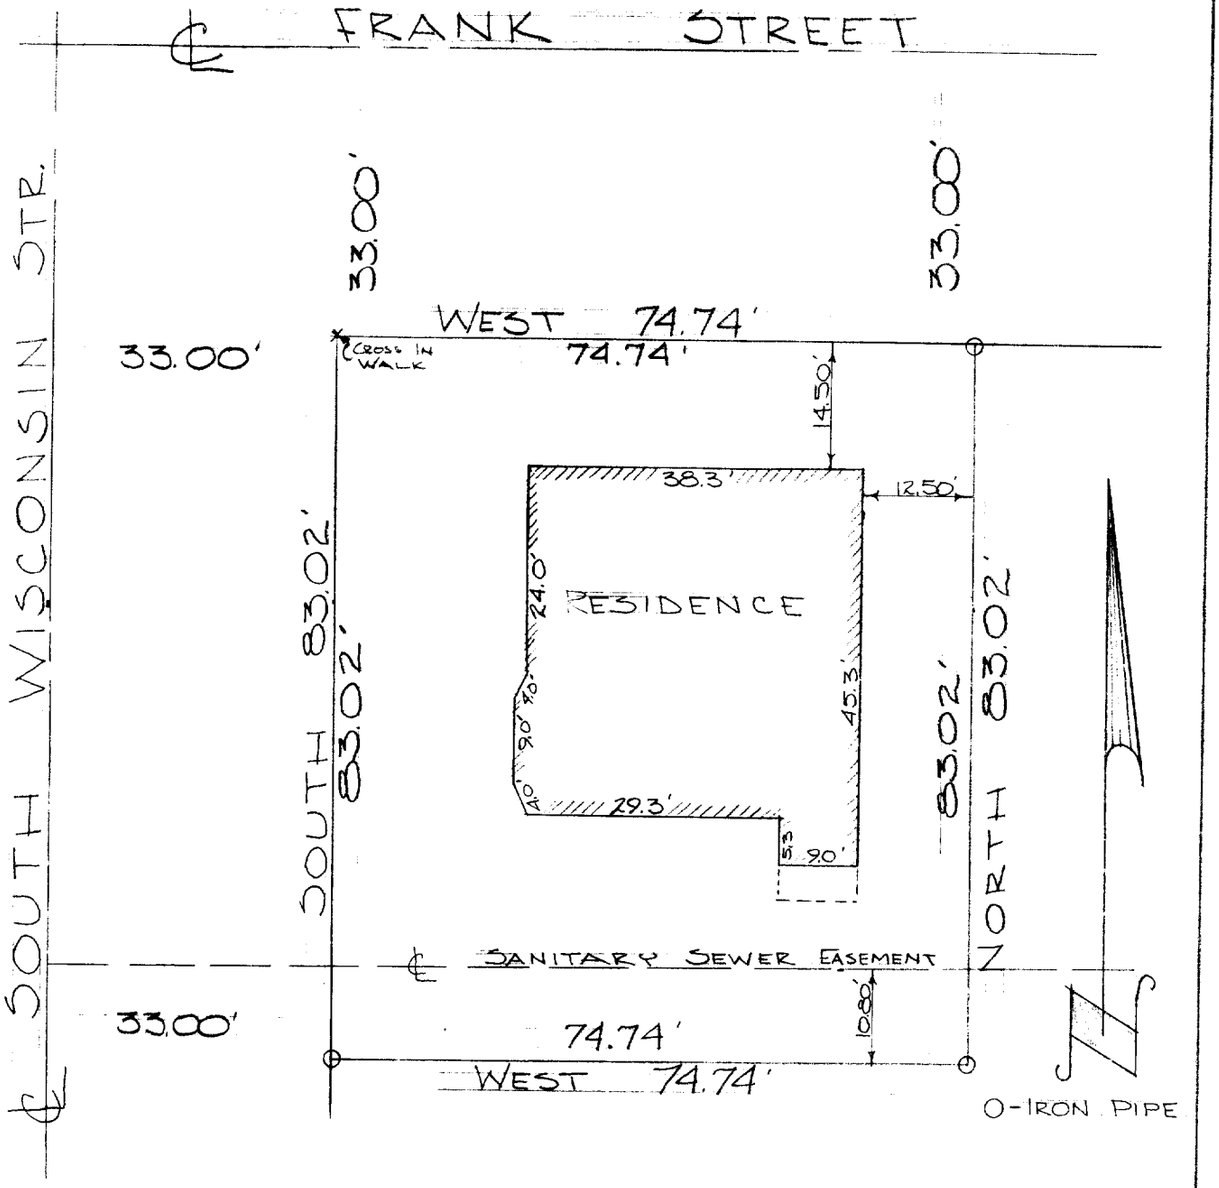

DESCRIPTION: The West 74.74 feet of Lot 2 of Block 49 of Rockwells Second Addition to the City of Elkhorn, Walworth County, Wisconsin.

EASEMENT: A Sanitary Sewer Easement 10.00 feet in width the center line being 10.80 feet North of the South lot line of Lot 2 Block 49, Rockwells Second Addition.

CERTIFICATE: I, James F. Biagi, surveyor, do hereby certify that I have surveyed the property hereon described, and that the location of the improvements are as shown.

September 16, 1963.

James F. Biagi

James F. Biagi RL.S. 272

WISCONSIN JAMES F. BIAGI MILWAUKEE, WIS. LAND SURVEYOR

RW2-18

4-157B