
34-66

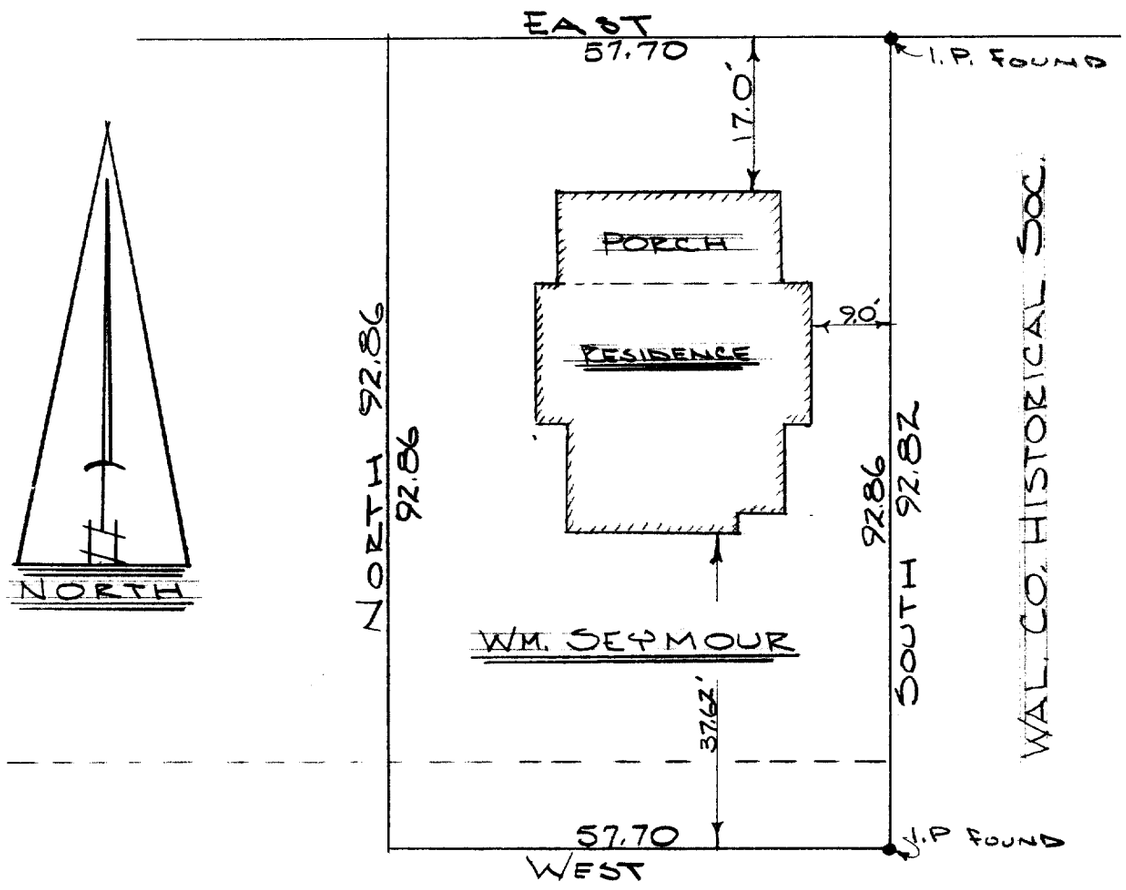

DESCRIPTION: The East 57.70 feet of Lot 2 and the North 10.00 feet ot the East 57.70 feet of Lot 3 of Block 48 of Rockwell's Second Addition to the City of Elkhorn, Walworth County, Wisconsin.

CERTIFICATE: I, James F. Biagi, surveyor do hereby certify that I have surveyed the property hereon described and that the location of the improvements is as shown.

March 14, 1966.

WISCONSIN
JAMES F. BIAGI
MILWAUKEE, WIS.
LAND SURVEYOR

James F. Biagi, RLS 272

RW 2-7

4-158