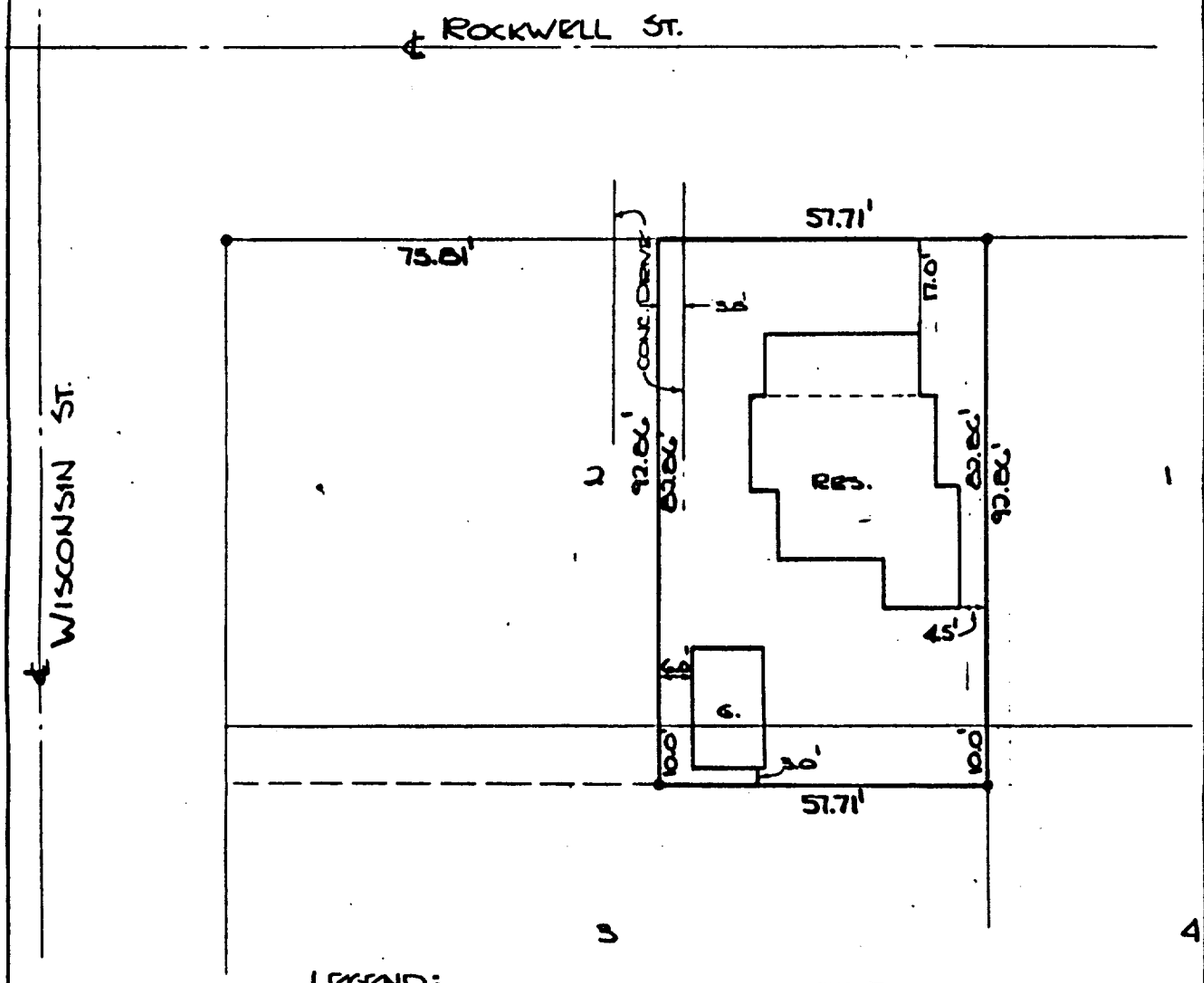


LEGEND:
• - IRON PIPE FOUND

SCALE 1" = 20'

DESCRIPTION:
THE EAST 57.7 FEET OF LOT 2 AND THE NORTH 10.0 FEET OF THE EAST 57.7 FEET OF LOT 3 OF BLOCK 48 OF ROCKWELL'S SECOND ADDITION TO THE CITY OF ELKHORN, WALWORTH COUNTY, WISCONSIN.

CERTIFICATE:
I, JAMES F. BIAGI, SURVEYOR, DO HEREBY CERTIFY THAT I HAVE SURVEYED THE PROPERTY HEREON DESCRIBED, AND THAT THE LOCATION OF THE IMPROVEMENTS IS AS SHOWN.

DATE:
JULY 31, 1979

WISCONSIN JAMES F. BIAGI MILWAUKEE, WIS. LAND SURVEYOR

JAMES F. BIAGI S-272

YRW 2-7

4-158 RL