


DUNHAM SURVEYING, S.C.
SURVEYING & SUBDIVIDING
DELAVER, WISCONSIN 53115

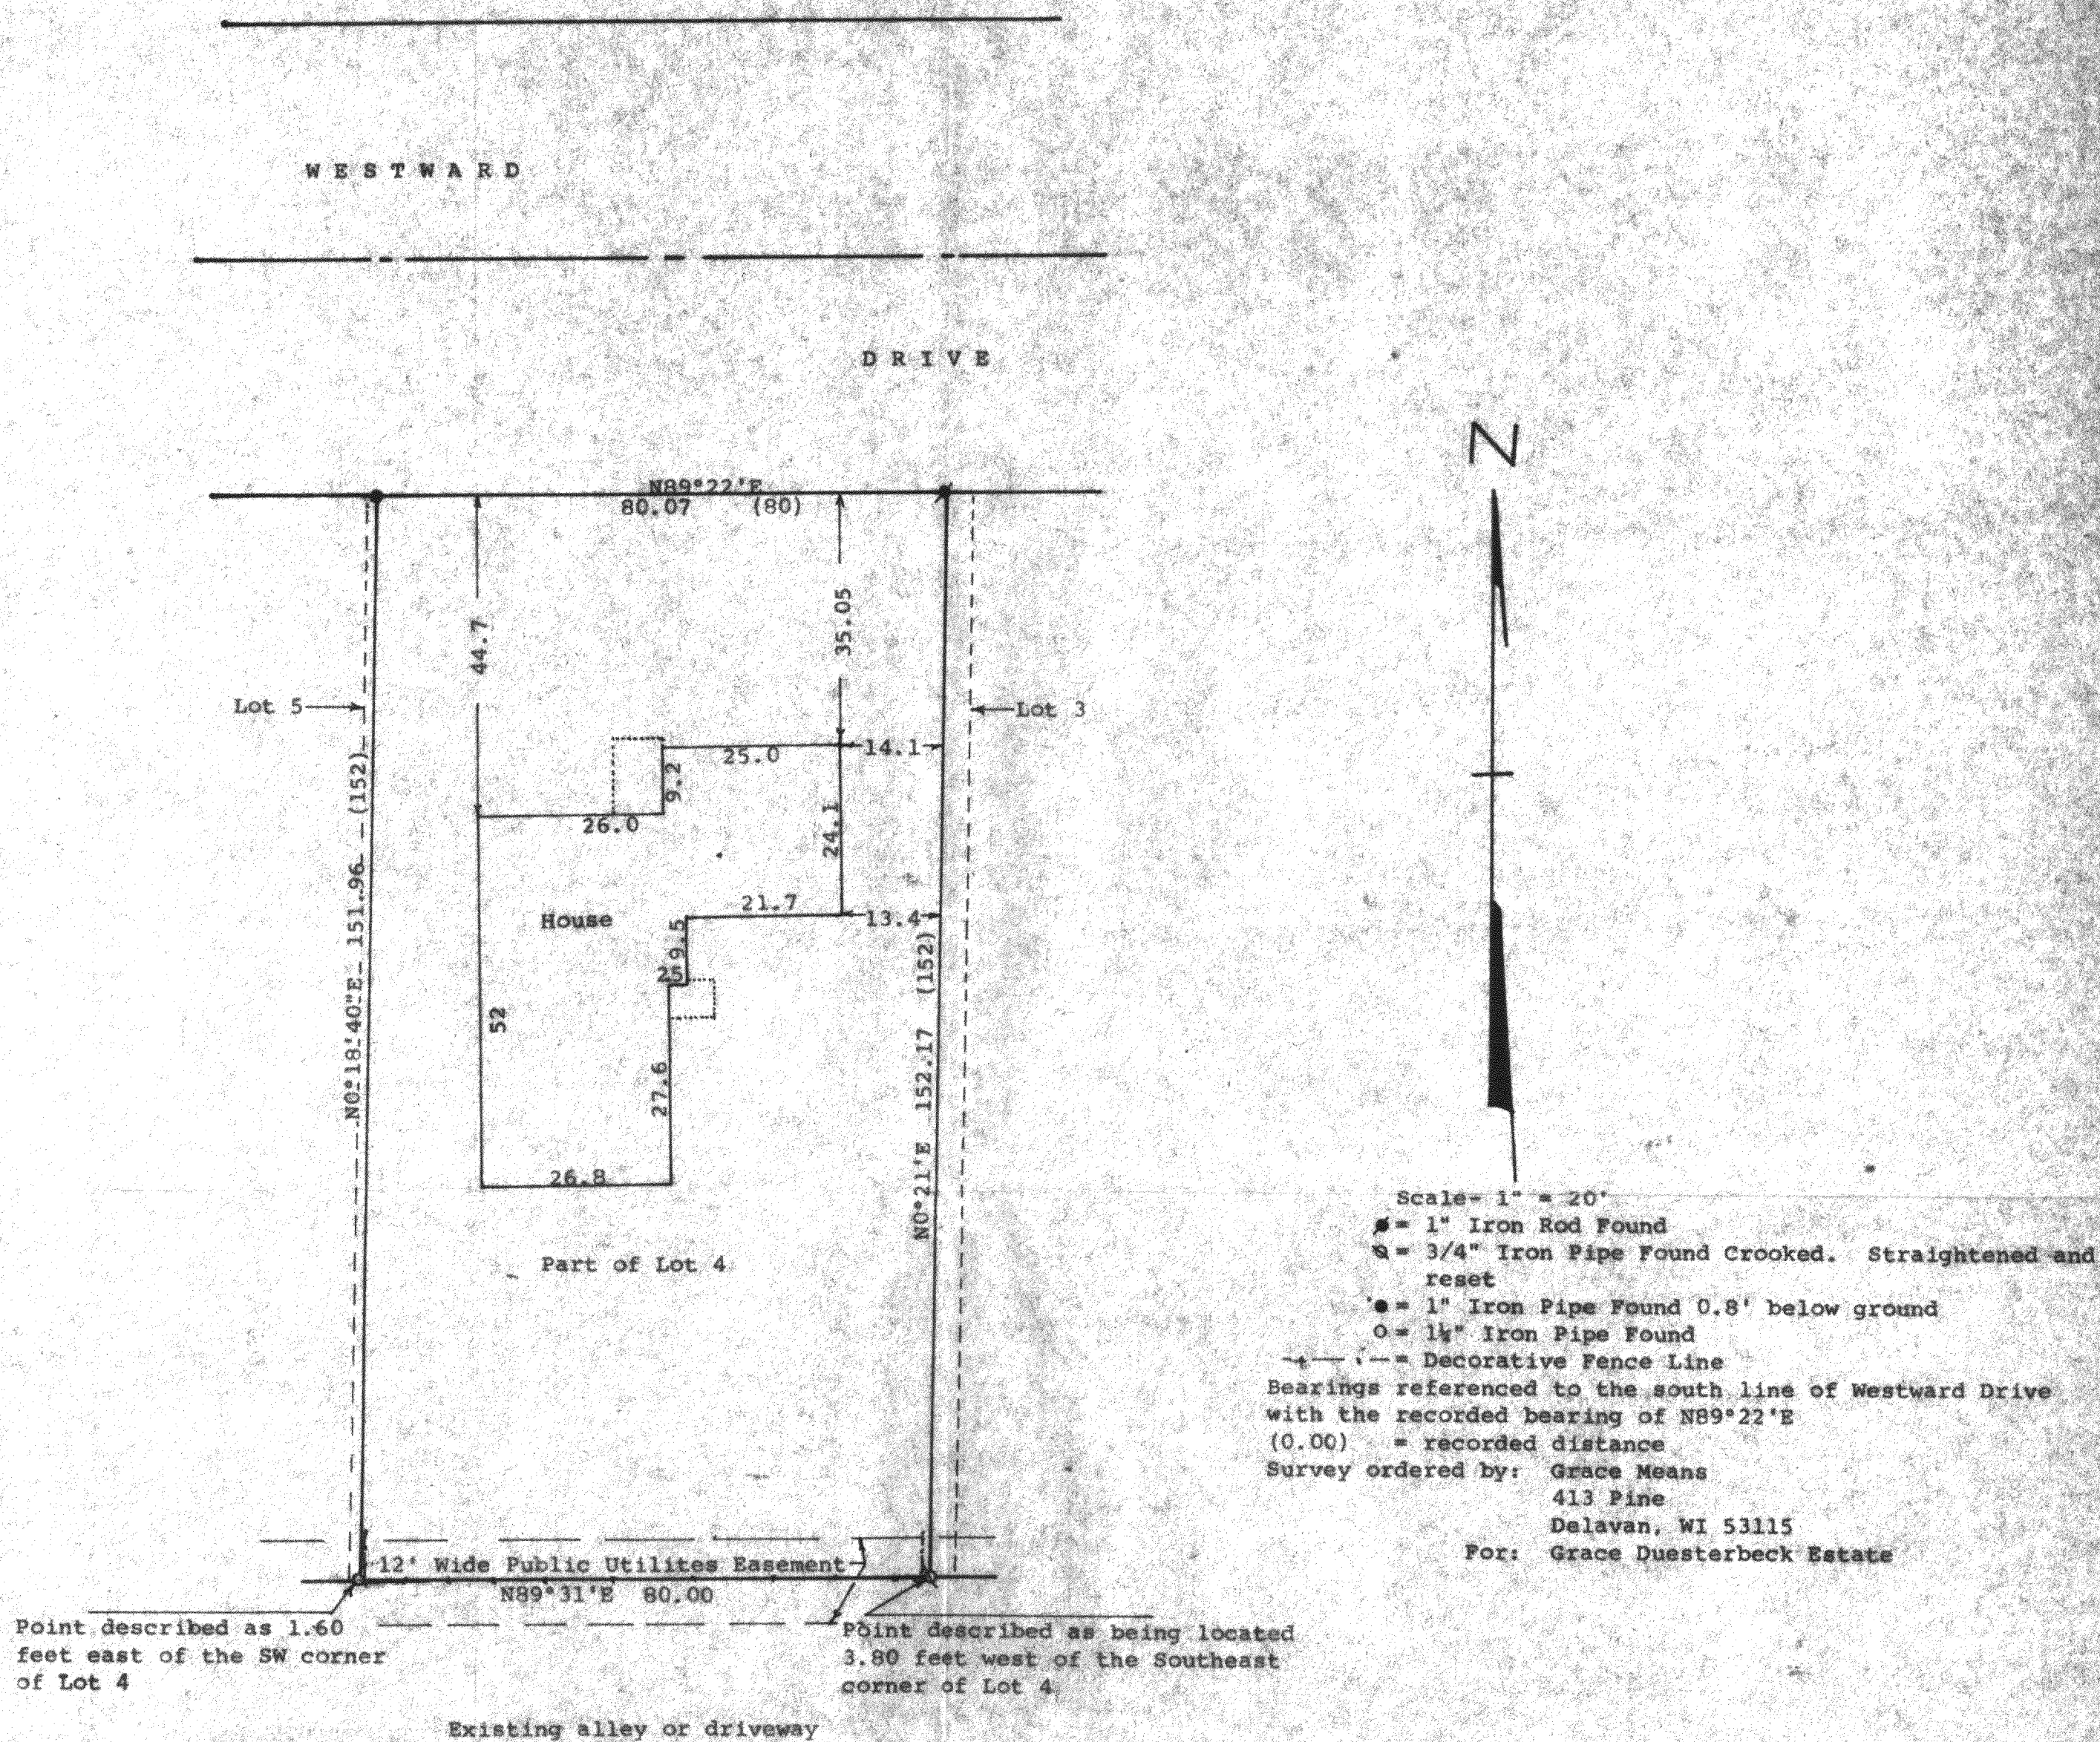

STATE OF WISCONSIN) SS
COUNTY OF WALWORTH)

I, George T. Dunham, Surveyor, certify that I have surveyed the property described as follows:

That part of Lot 4 in Block 2 of James Jones Second Addition in the City of Elkhorn, Walworth County, Wisconsin, described as follows: Beginning at a point 1.60 feet East of the Southwest Corner of Lot 4, Block 2, James Jones Second Addition; thence East 80 feet; thence North to the North line of said Lot 4; thence West to a point 1.60 feet from the northwest corner of Lot 4; thence South to the place of beginning.

and that the plat shown hereon is a correct representation thereof, and shows the size and location of the property, its exterior boundaries, the location of all visible structures and dimensions of all principal buildings thereon, boundary fences, apparent easements, roadways and visible encroachments, if any, and that I have surveyed the property hereon described, according to the official records, to the best of my knowledge and belief,
July 29, 1997

George T. Dunham
George T. Dunham, Surveyor

