
HOLLAND & THOMAS, L.L.C. - LAND SURVEYORS
202 West Street Johnson Creek, WI 53038 (920) 699-3305

PLAT OF SURVEY

FOR LOT 61 OF JACKSON CREEK EAST SUBDIVISION, LOCATED IN THE SW 1/4 AND SE 1/4 OF THE SW 1/4 OF SECTION 7, TOWN 2 NORTH, RANGE 17 EAST, CITY OF ELKHORN, WALWORTH COUNTY, WISCONSIN.

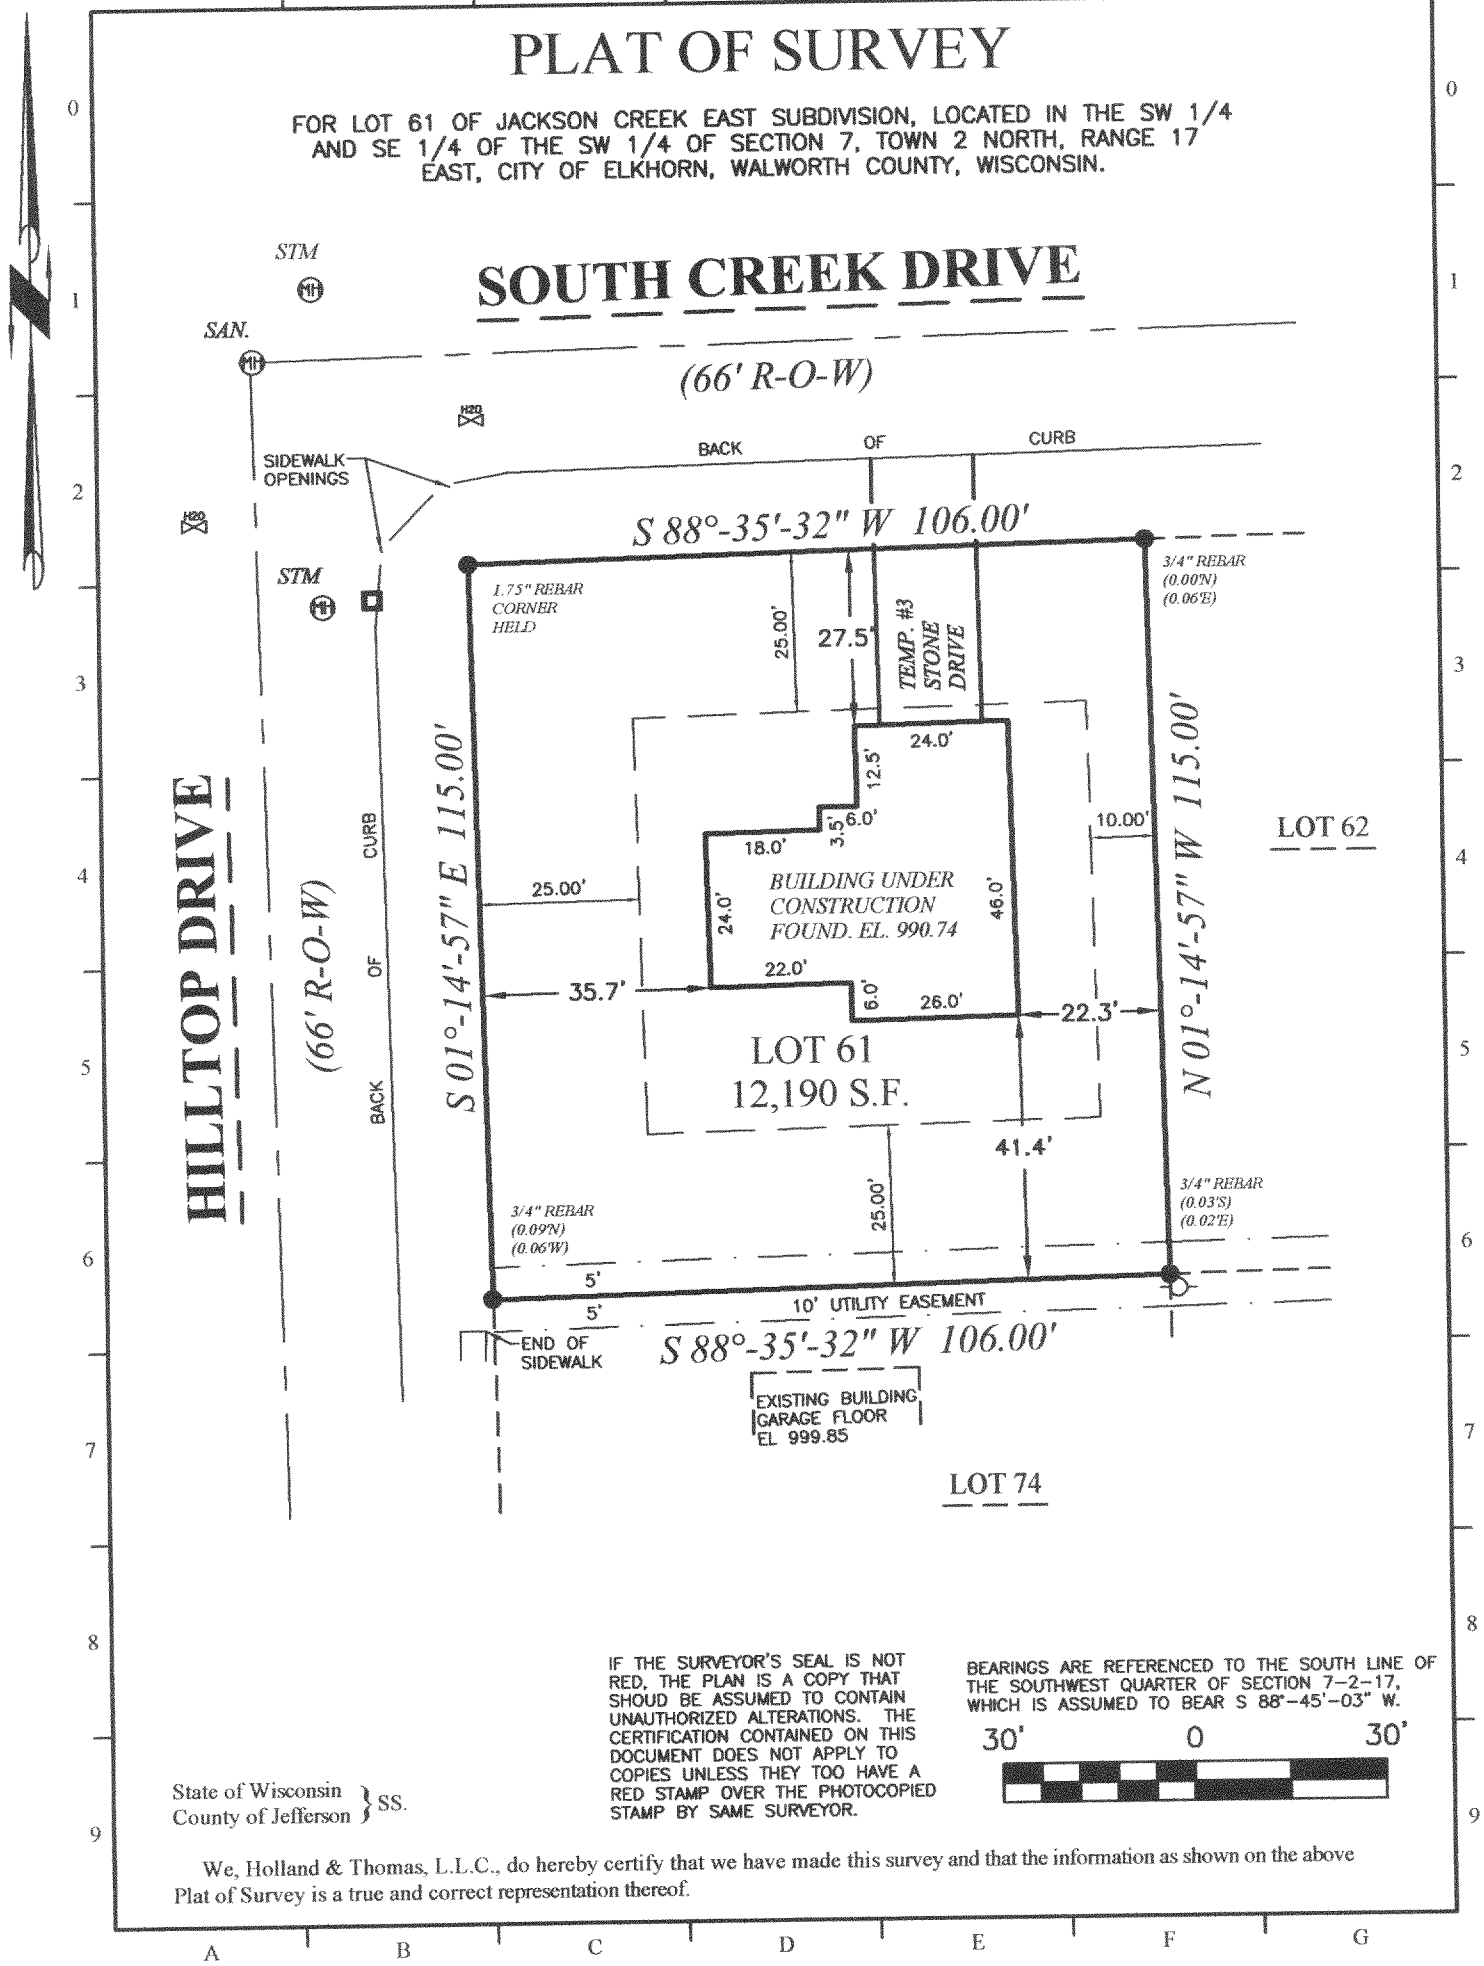

IF THE SURVEYOR'S SEAL IS NOT RED, THE PLAN IS A COPY THAT SHOUD BE ASSUMED TO CONTAIN UNAUTHORIZED ALTERATIONS. THE CERTIFICATION CONTAINED ON THIS DOCUMENT DOES NOT APPLY TO COPIES UNLESS THEY TOO HAVE A RED STAMP OVER THE PHOTOCOPIED STAMP BY SAME SURVEYOR.

BEARINGS ARE REFERENCED TO THE SOUTH LINE OF THE SOUTHWEST QUARTER OF SECTION 7-2-17, WHICH IS ASSUMED TO BEAR S 88°-45'-03" W.

30' 0 30'

State of Wisconsin } SS.
County of Jefferson }

We, Holland & Thomas, L.L.C., do hereby certify that we have made this survey and that the information as shown on the above Plat of Survey is a true and correct representation thereof.

LEGEND: These standard symbols may be found in the drawing.

- Utility Pedestal
- Lot Corner (Found) w/desc.
- Man Hole w/type
- Water Valve
- Easement Boundary
- Setback Line

WISCONSIN SCOTT D. THOMAS S-2051 JOHNSON CREEK WISCONSIN 5/5/03 LAND SURVEYOR

BUILDER: BROOKSTONE HOMES, INC.
1860 EXECUTIVE DRIVE
SUITE B1
OCONOMOWOC, WI 53066
PHONE: (262) 567-5700
FAX: (262) 567-7228

RECEIVED MAY 16 2003

C:\Holland&Thomas\2002\0207\020706AB.dwg;Drawn By:NLH;Checked By:SDT;05-05-03.

YJCE-61

004-1607