
HOLLAND & THOMAS, L.L.C. - LAND SURVEYORS
202 West Street Johnson Creek, WI 53038 (920) 699-3305

PLAT OF SURVEY

FOR LOT 14 OF MAPLE VIEW SUBDIVISION, LOCATED IN PART OF THE NW 1/4 AND SW 1/4 OF THE NW 1/4 OF SECTION 31, TOWN 3 NORTH, RANGE 17 EAST, CITY OF ELKHORN, WALWORTH COUNTY, WISCONSIN.

EXISTING TOP OF FOUNDATION: 1023.96

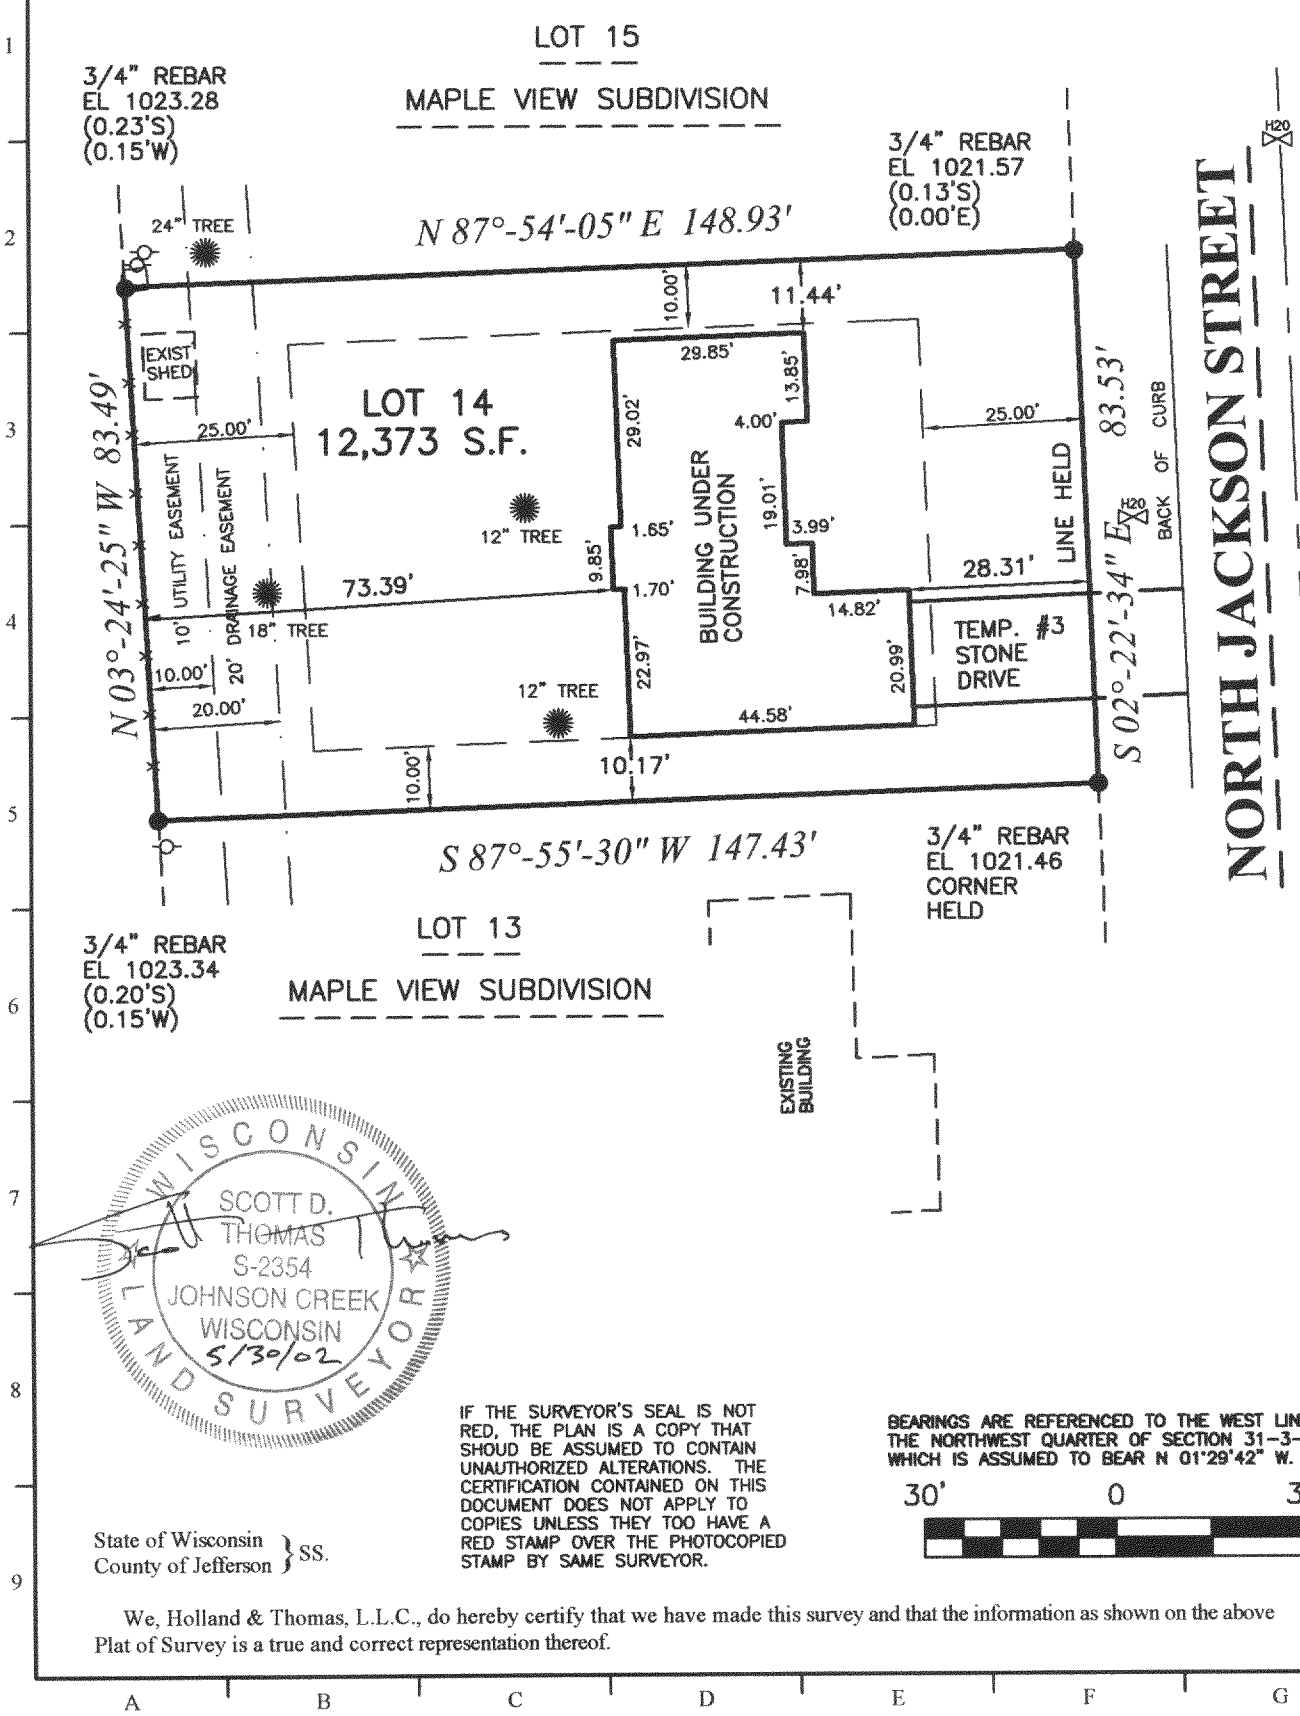

IF THE SURVEYOR'S SEAL IS NOT RED, THE PLAN IS A COPY THAT SHOUD BE ASSUMED TO CONTAIN UNAUTHORIZED ALTERATIONS. THE CERTIFICATION CONTAINED ON THIS DOCUMENT DOES NOT APPLY TO COPIES UNLESS THEY TOO HAVE A RED STAMP OVER THE PHOTOCOPIED STAMP BY SAME SURVEYOR.

BEARINGS ARE REFERENCED TO THE WEST LINE OF THE NORTHWEST QUARTER OF SECTION 31-3-17, WHICH IS ASSUMED TO BEAR N 01°29'42" W.

30' 0 30'

State of Wisconsin } SS.
County of Jefferson }

We, Holland & Thomas, L.L.C., do hereby certify that we have made this survey and that the information as shown on the above Plat of Survey is a true and correct representation thereof.


LEGEND: These standard symbols may be found in the drawing.

- Lot Corner (Found) w/desc.
- Existing Tree w/dia.
- Water Valve
- Elec. Trans. Box
- Sanitary Man Hole
- Utility Pedestal
- Easement Boundary
- Setback Line
- Chainlink Fence

C:/Holland&Thomas/020408AB;Drawn By:NLH;Checked By:SDT;5-30-02.

BUILDER: ADVANTAGE HOMES INCORPORATED
2017 N. HARMONY TOWNHALL ROAD
JANESVILLE, WI 53546
PH: (608) 756-2989
FAX: (608) 756-3443

OWNER: DAVIS

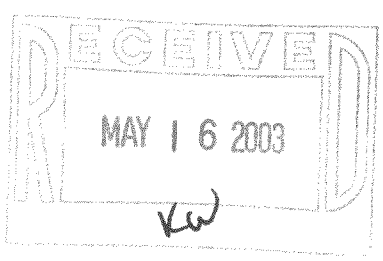

YMV-14

004-1611